


DUNHAM & RASMUSSEN
SURVEYING & ENGINEERING
DELAVER, WISCONSIN

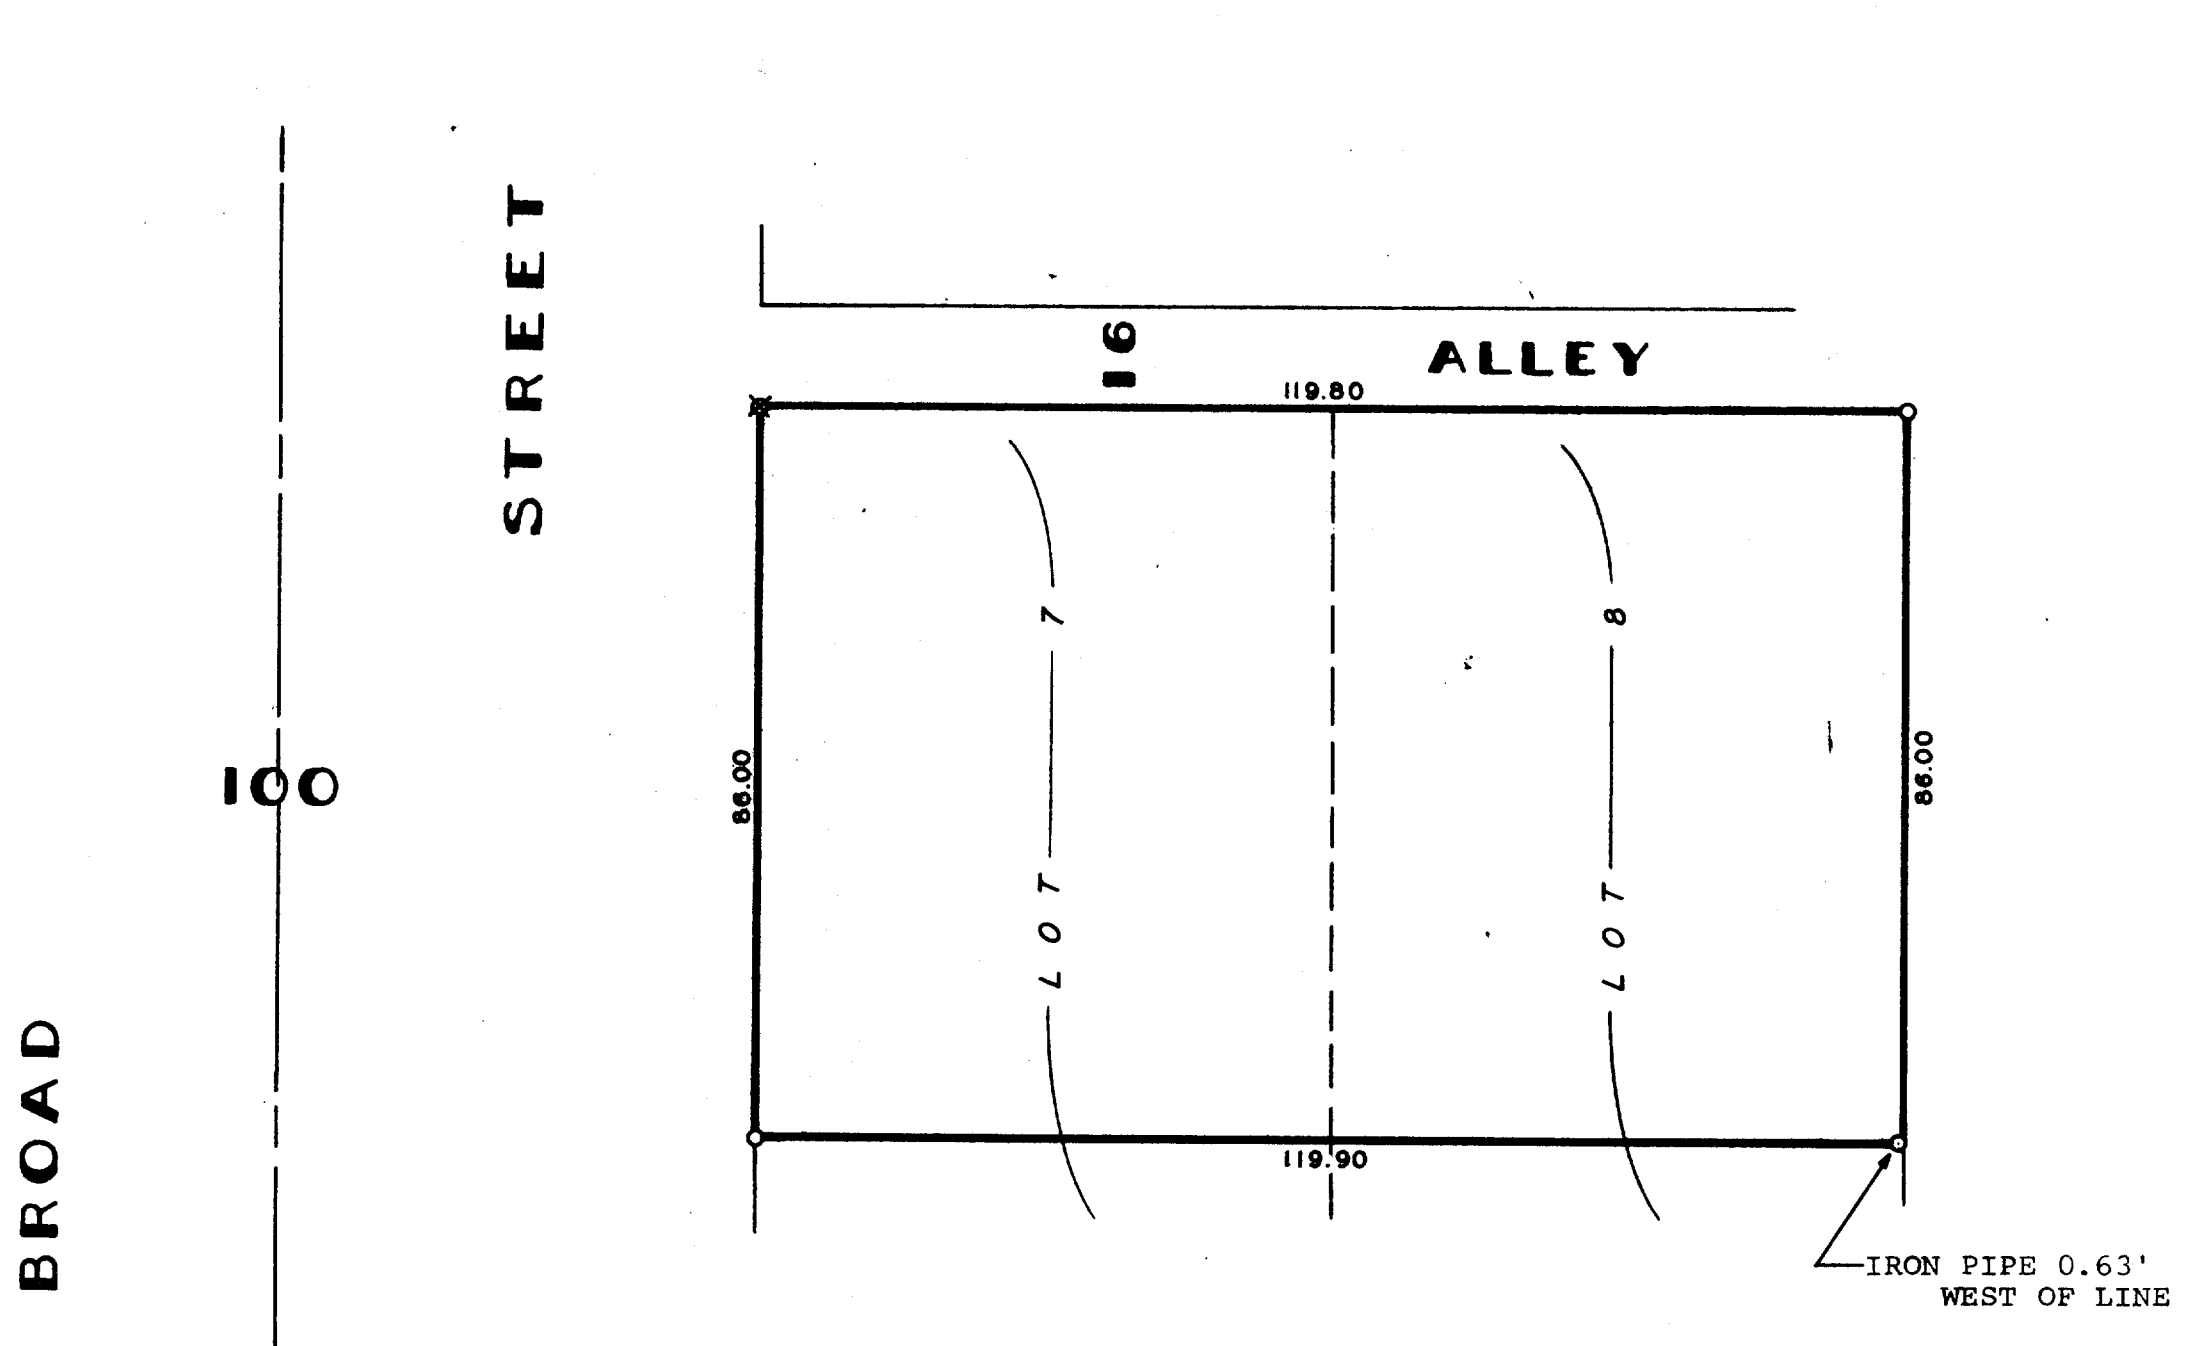

Plat of survey of the north $\frac{1}{2}$ of Lots 7 and 8
in Block 13 of the Original Village of Lake Geneva,
Walworth County, Wisconsin.
August 22, 1961

George T. Dunham
George T. Dunham, Surveyor

SCALE 1" = 20'
O = IRON PIPE
X = CROSS IN CONC.