


D.D. COOPER & CO. INC.

202 18 4. 202 508 8
EXCOURT. 29 58181

PH 414-723-6265

SURVEYING • BOLLAR NOTES

NOTE: PARCEL IS
RECORDED AS 374.77' LONG.
WAS FOUND TO BE
347.77'

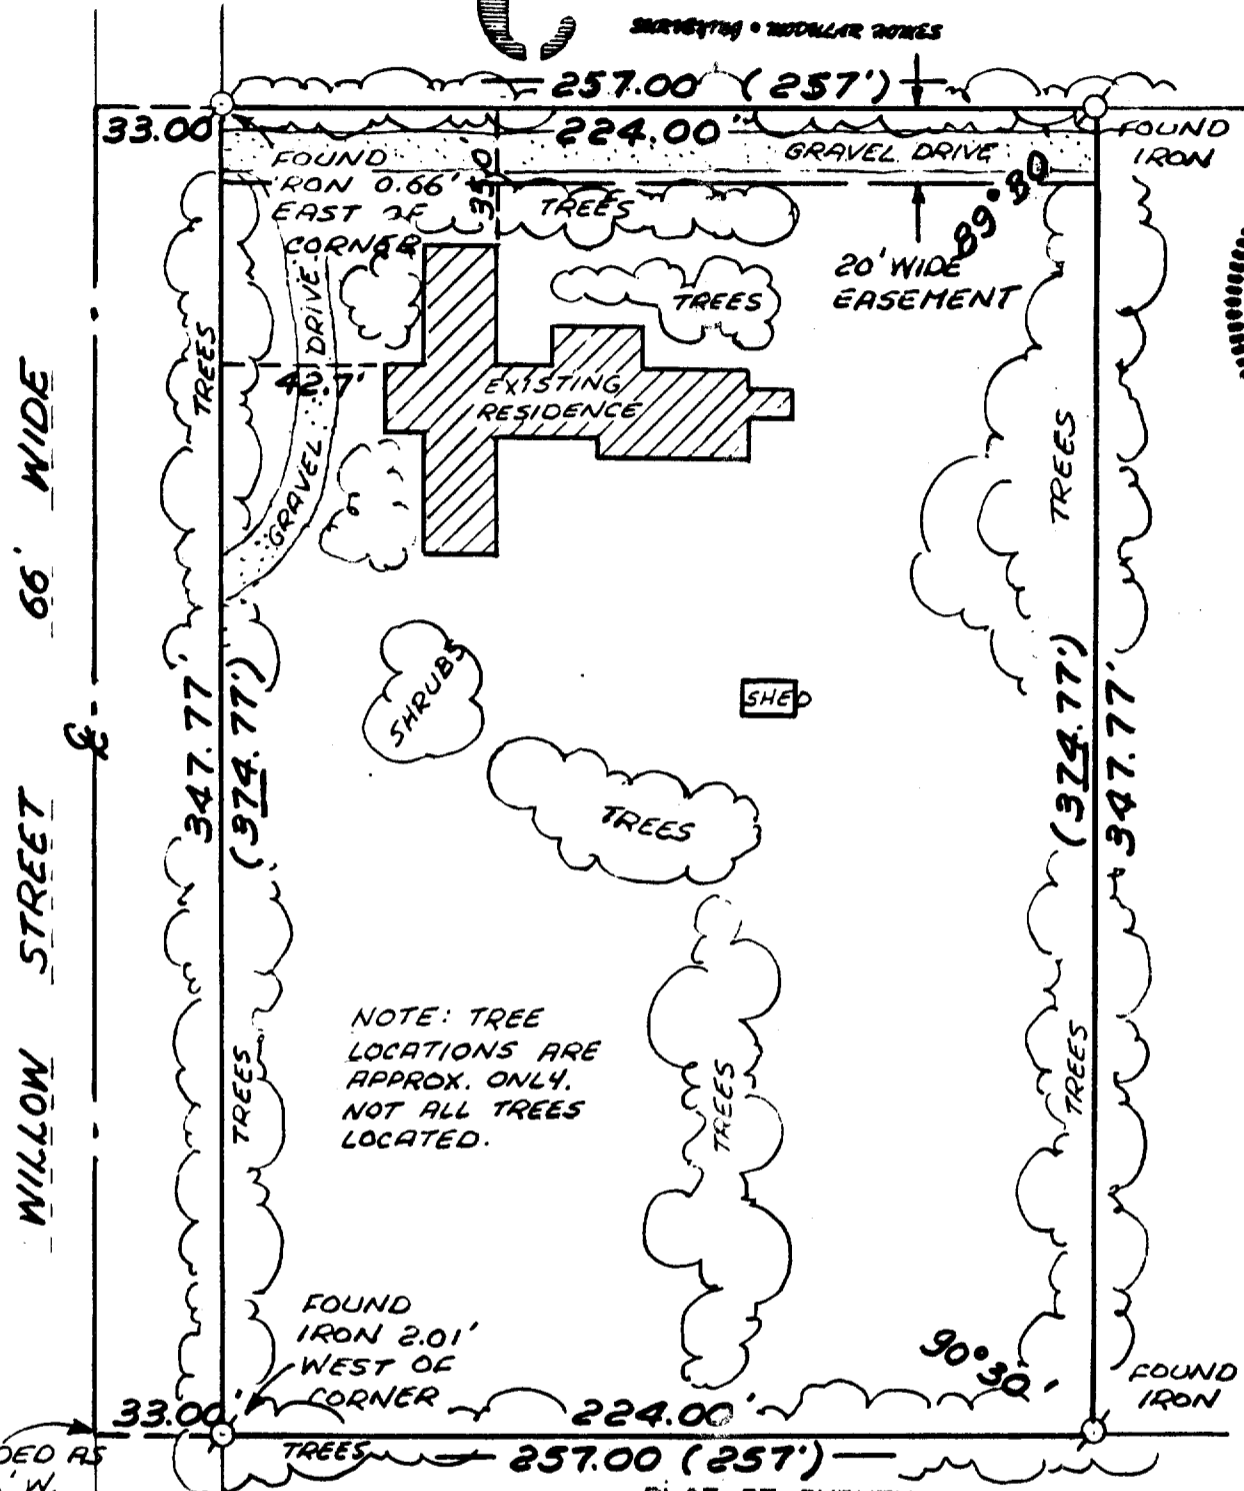

NOTE: TREE
LOCATIONS ARE
APPROX. ONLY.
NOT ALL TREES
LOCATED.

POINT
RECORDED AS
2566.96' W.
& 1675.9 N.
OF S.E. COR.
OF N.E. 1/4
SEC. 1-1-17

DESCRIPTION OF RECORD

Commencing at a point in the center line of Willow Street, which is 2566.96 feet West of and 1675.9 feet North of the Southeast corner of the Northeast 1/4 of Section 1, Township 1, North, Range 17 East; thence North along the center line of Willow Street 374.77 feet to a point, thence East 257 feet to a point, thence South 374.77 feet to a point, thence West 257 feet to the place of beginning, containing 2.23 acres more or less, reserving to Theodora W. Finney and William P. Finney, Jr., their executors, administrators and assigns, a right of way 20 feet over and across the entire North 20 feet of the property above described.

OWNER: EDWARD A PRZYBYLSKI

I, DANIEL D. COOPER, REGISTERED SURVEYOR, DO HEREBY CERTIFY THAT I HAVE SURVEYED THE PROPERTY DESCRIBED HEREON AND THAT THE MAP SHOWN HEREON IS A TRUE AND ACCURATE REPRESENTATION THEREOF TO THE BEST OF MY PROFESSIONAL KNOWLEDGE AND BELIEF.

LEGEND
○—IRON PIPE FOUND
()—RECORD DIMENSION

DATED THIS 2 DAY OF Oct, 1984

Daniel D. Cooper
DANIEL D. COOPER, RLS NO. S-1464



PROJ. NO. 1984