


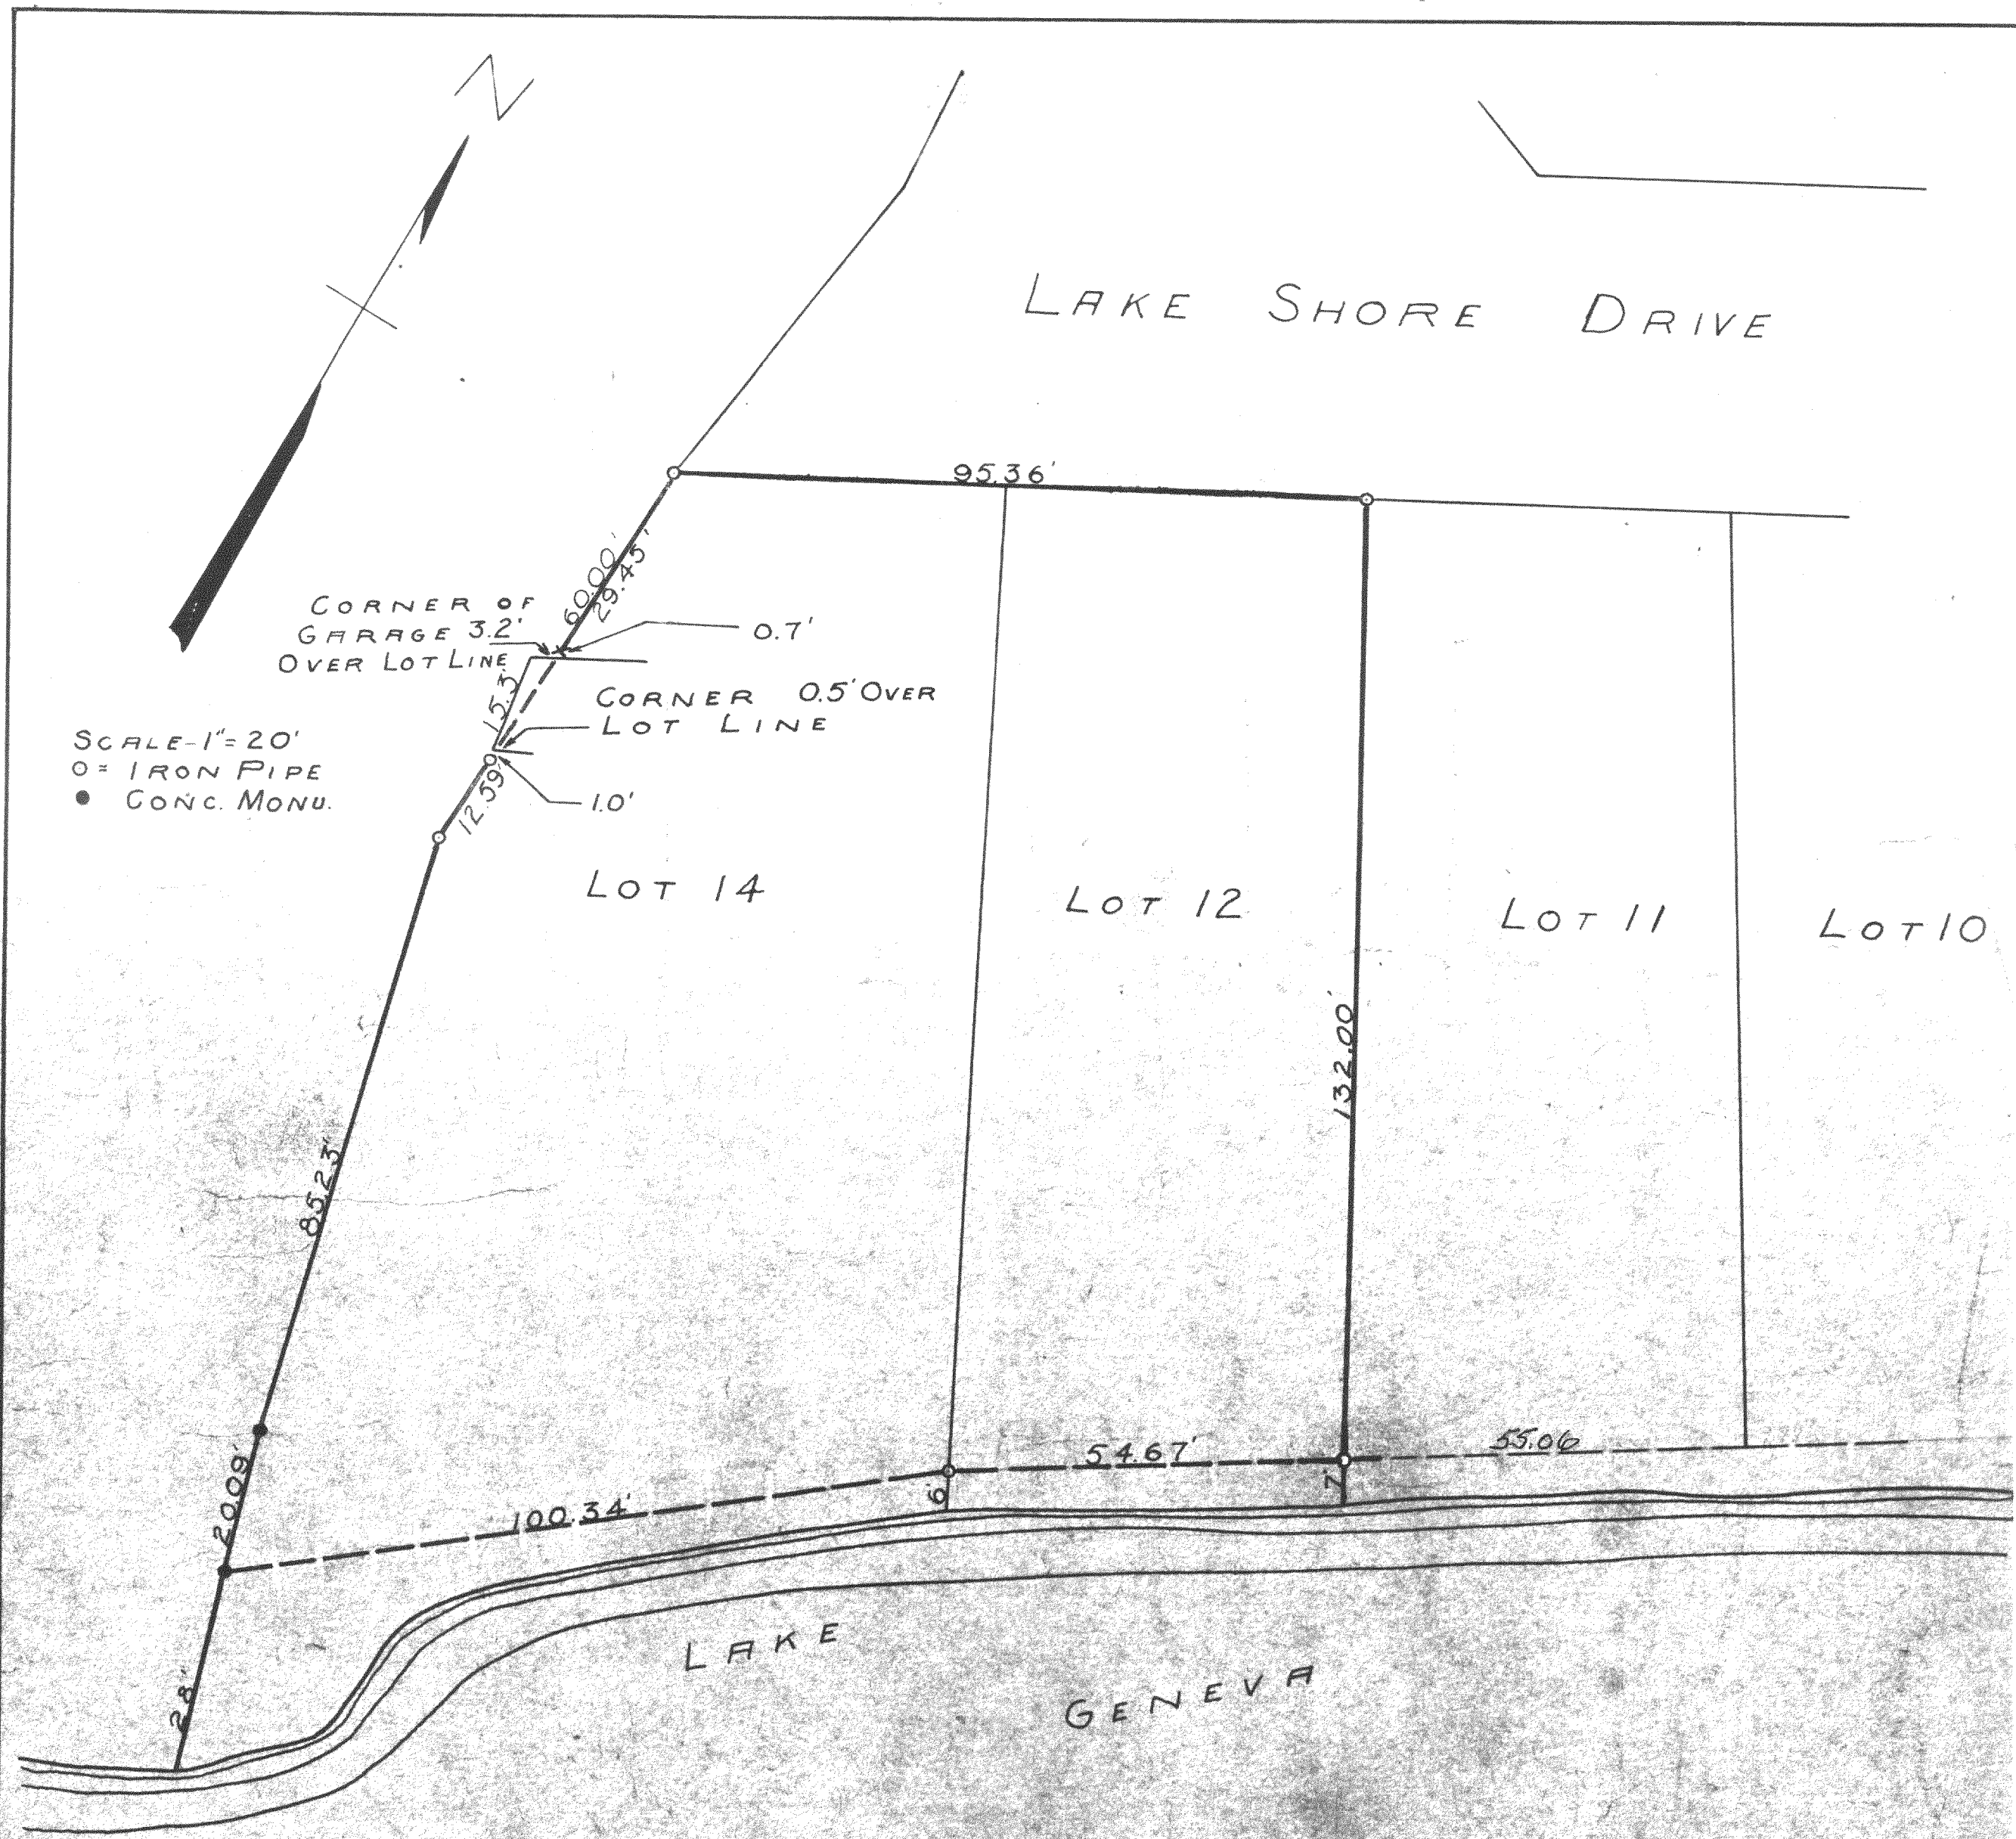

PLAT OF SURVEY OF LOTS 12 AND 14 OF
BLOCK 18 LAKE GENEVA MANOR LOCATED
IN THE CITY OF LAKE GENEVA WALWORTH
COUNTY WISCONSIN

LM-45 + LM-44

Nov. 1947

Lloyd L. Jensen
COUNTY SURVEYOR

7-9J