


DUNHAM SURVEYING, S.C.
SURVEYING & SUBDIVIDING
DELAVER, WISCONSIN 53115

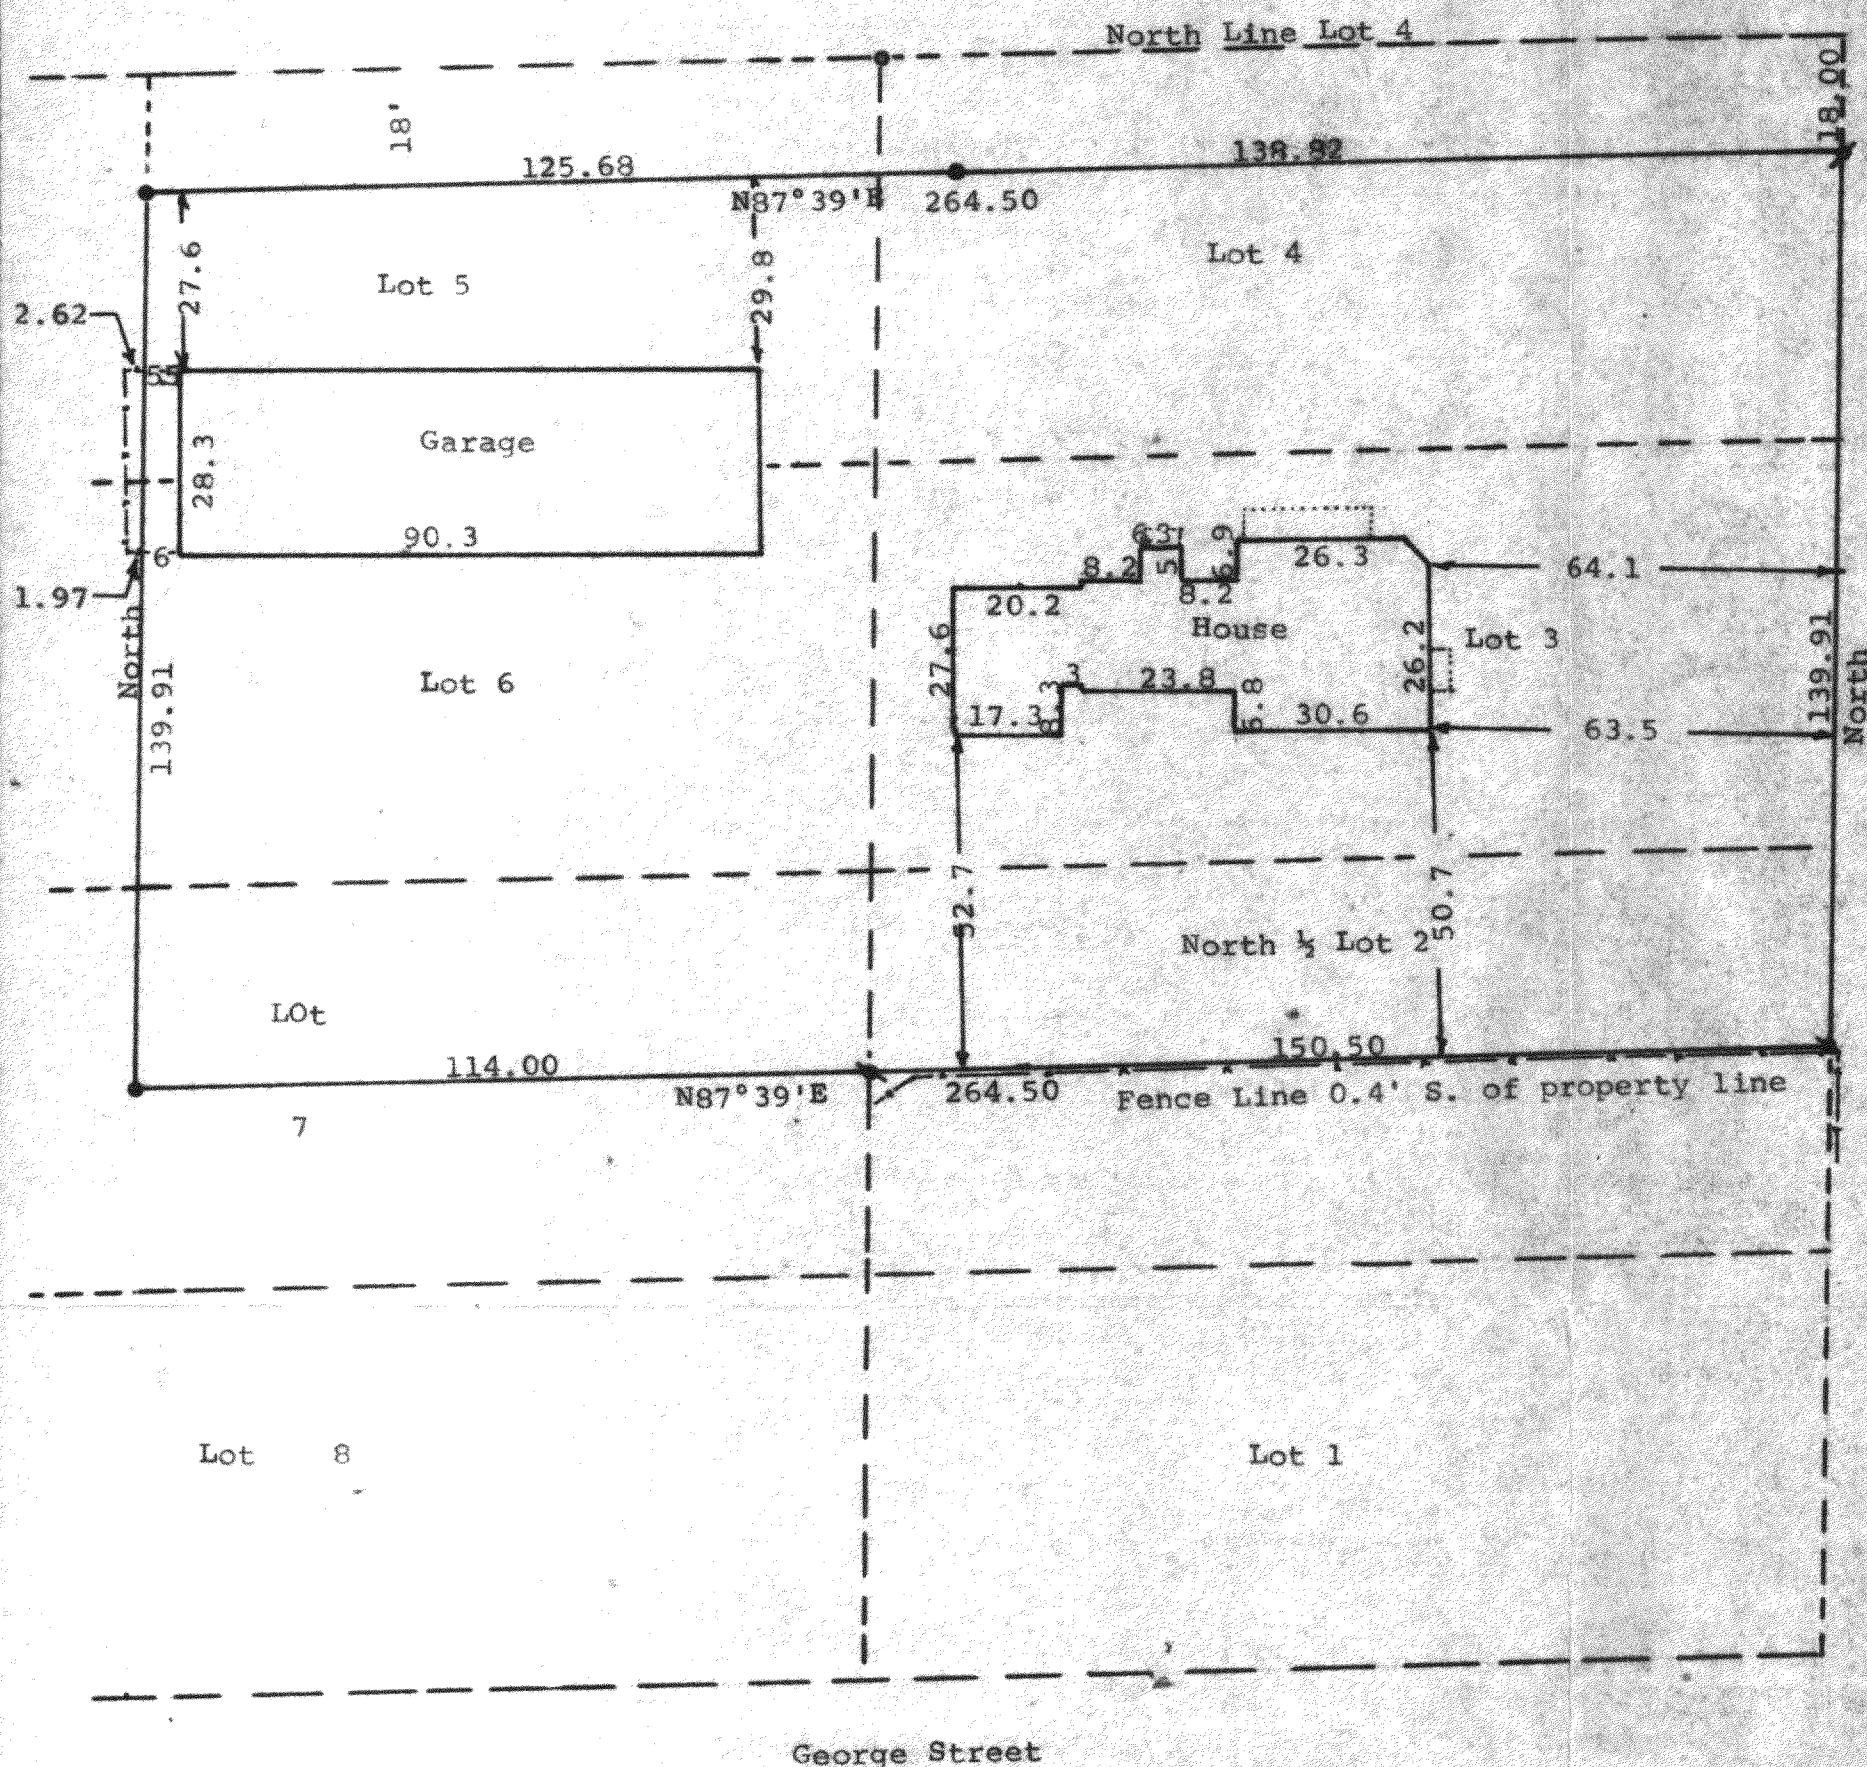

Scale - 1" = 30'
 x = 1/2" Iron Pipe Found
 o = 3/4" Iron Pipe Found
 o = 1" Iron Pipe Found
 e = 1 1/2" X 24" Iron Pipe Set
 Bearings referenced to the west line of
 Prairie Street with the assumed bearing of
 North
 Survey ordered by Mikrut Realty
 Sharon, WI 53585
 Updating & recertification ordered by:
 Ed & Diane Udey
 302 West Roosevelt
 Harvard, IL 60033
 - - - - - = Fence Line

STATE OF WISCONSIN) ss
 COUNTY OF WALWORTH)

I, George T. Dunham, Surveyor, certify that I have surveyed the property
 described as follows:



Commencing at a point which is midway between the Northeast corner of
 Lot 2, Block 1, Brigham's Addition to the Village of Sharon, Walworth
 County, Wisconsin, and the Southeast corner of said Lot 2; thence West
 parallel with the North line of Lot 2 and Lot 7 in said block to the
 west line of said Lot 2; thence continuing West parallel with the north
 line of said Lot 7 the further distance of 114.00 feet; thence North along
 the line of a fence to a point which is 18.00 feet south of the North line
 of Lot 5 in said block; thence East in a straight line to a point on the
 east line of Lot 4 in said block, which point is 18.00 feet south of the North-
 east corner of said Lot 4; thence South on the East line of Lots 4, 3, and 2
 in said block to the place of beginning.

and that the map shown hereon is a correct representation thereof and shows
 the size and location of the property, its exterior boundaries, the location
 of all visible structures and dimensions of all principal buildings thereon,
 boundary fences, apparent easements, roadways and visible encroachments, if
 any, and that I have surveyed the property hereon described according to the
 official records, to the best of my knowledge and belief.

August 27, 1987

Updated & recertified this 27th day of
 October, 1989

George T. Dunham
 George T. Dunham, Surveyor

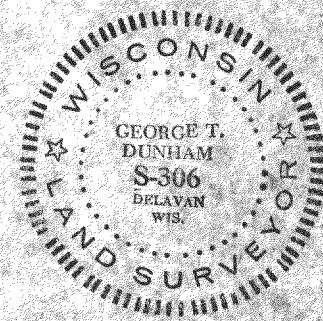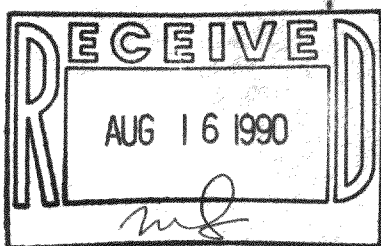

Tax Key #
 UBA 00001
 UBA 00002
 UBA 00003
 UBA 00004
 UBA 00005

Survey # 008-117