


PLAT OF SURVEY OF THE WEST 30 FEET OF
LOT 3 OF BLOCK II ORIG. PLAT SHARON
IN SE1/4 NW1/4 SEC. 33-1-15
WALWORTH COUNTY, WISCONSIN

LEGEND

- = FOUND IRON PIPE
- = SET IRON PIPE
- = UTILITY POLE
- OR ⊗ = CATCH BASIN
- = SANITARY MANHOLE
- = WOODEN FENCE
- - - = STORM SEWER OR CULV.
- = GUARD RAIL
- (XXX) = RECORDED DIMENSION

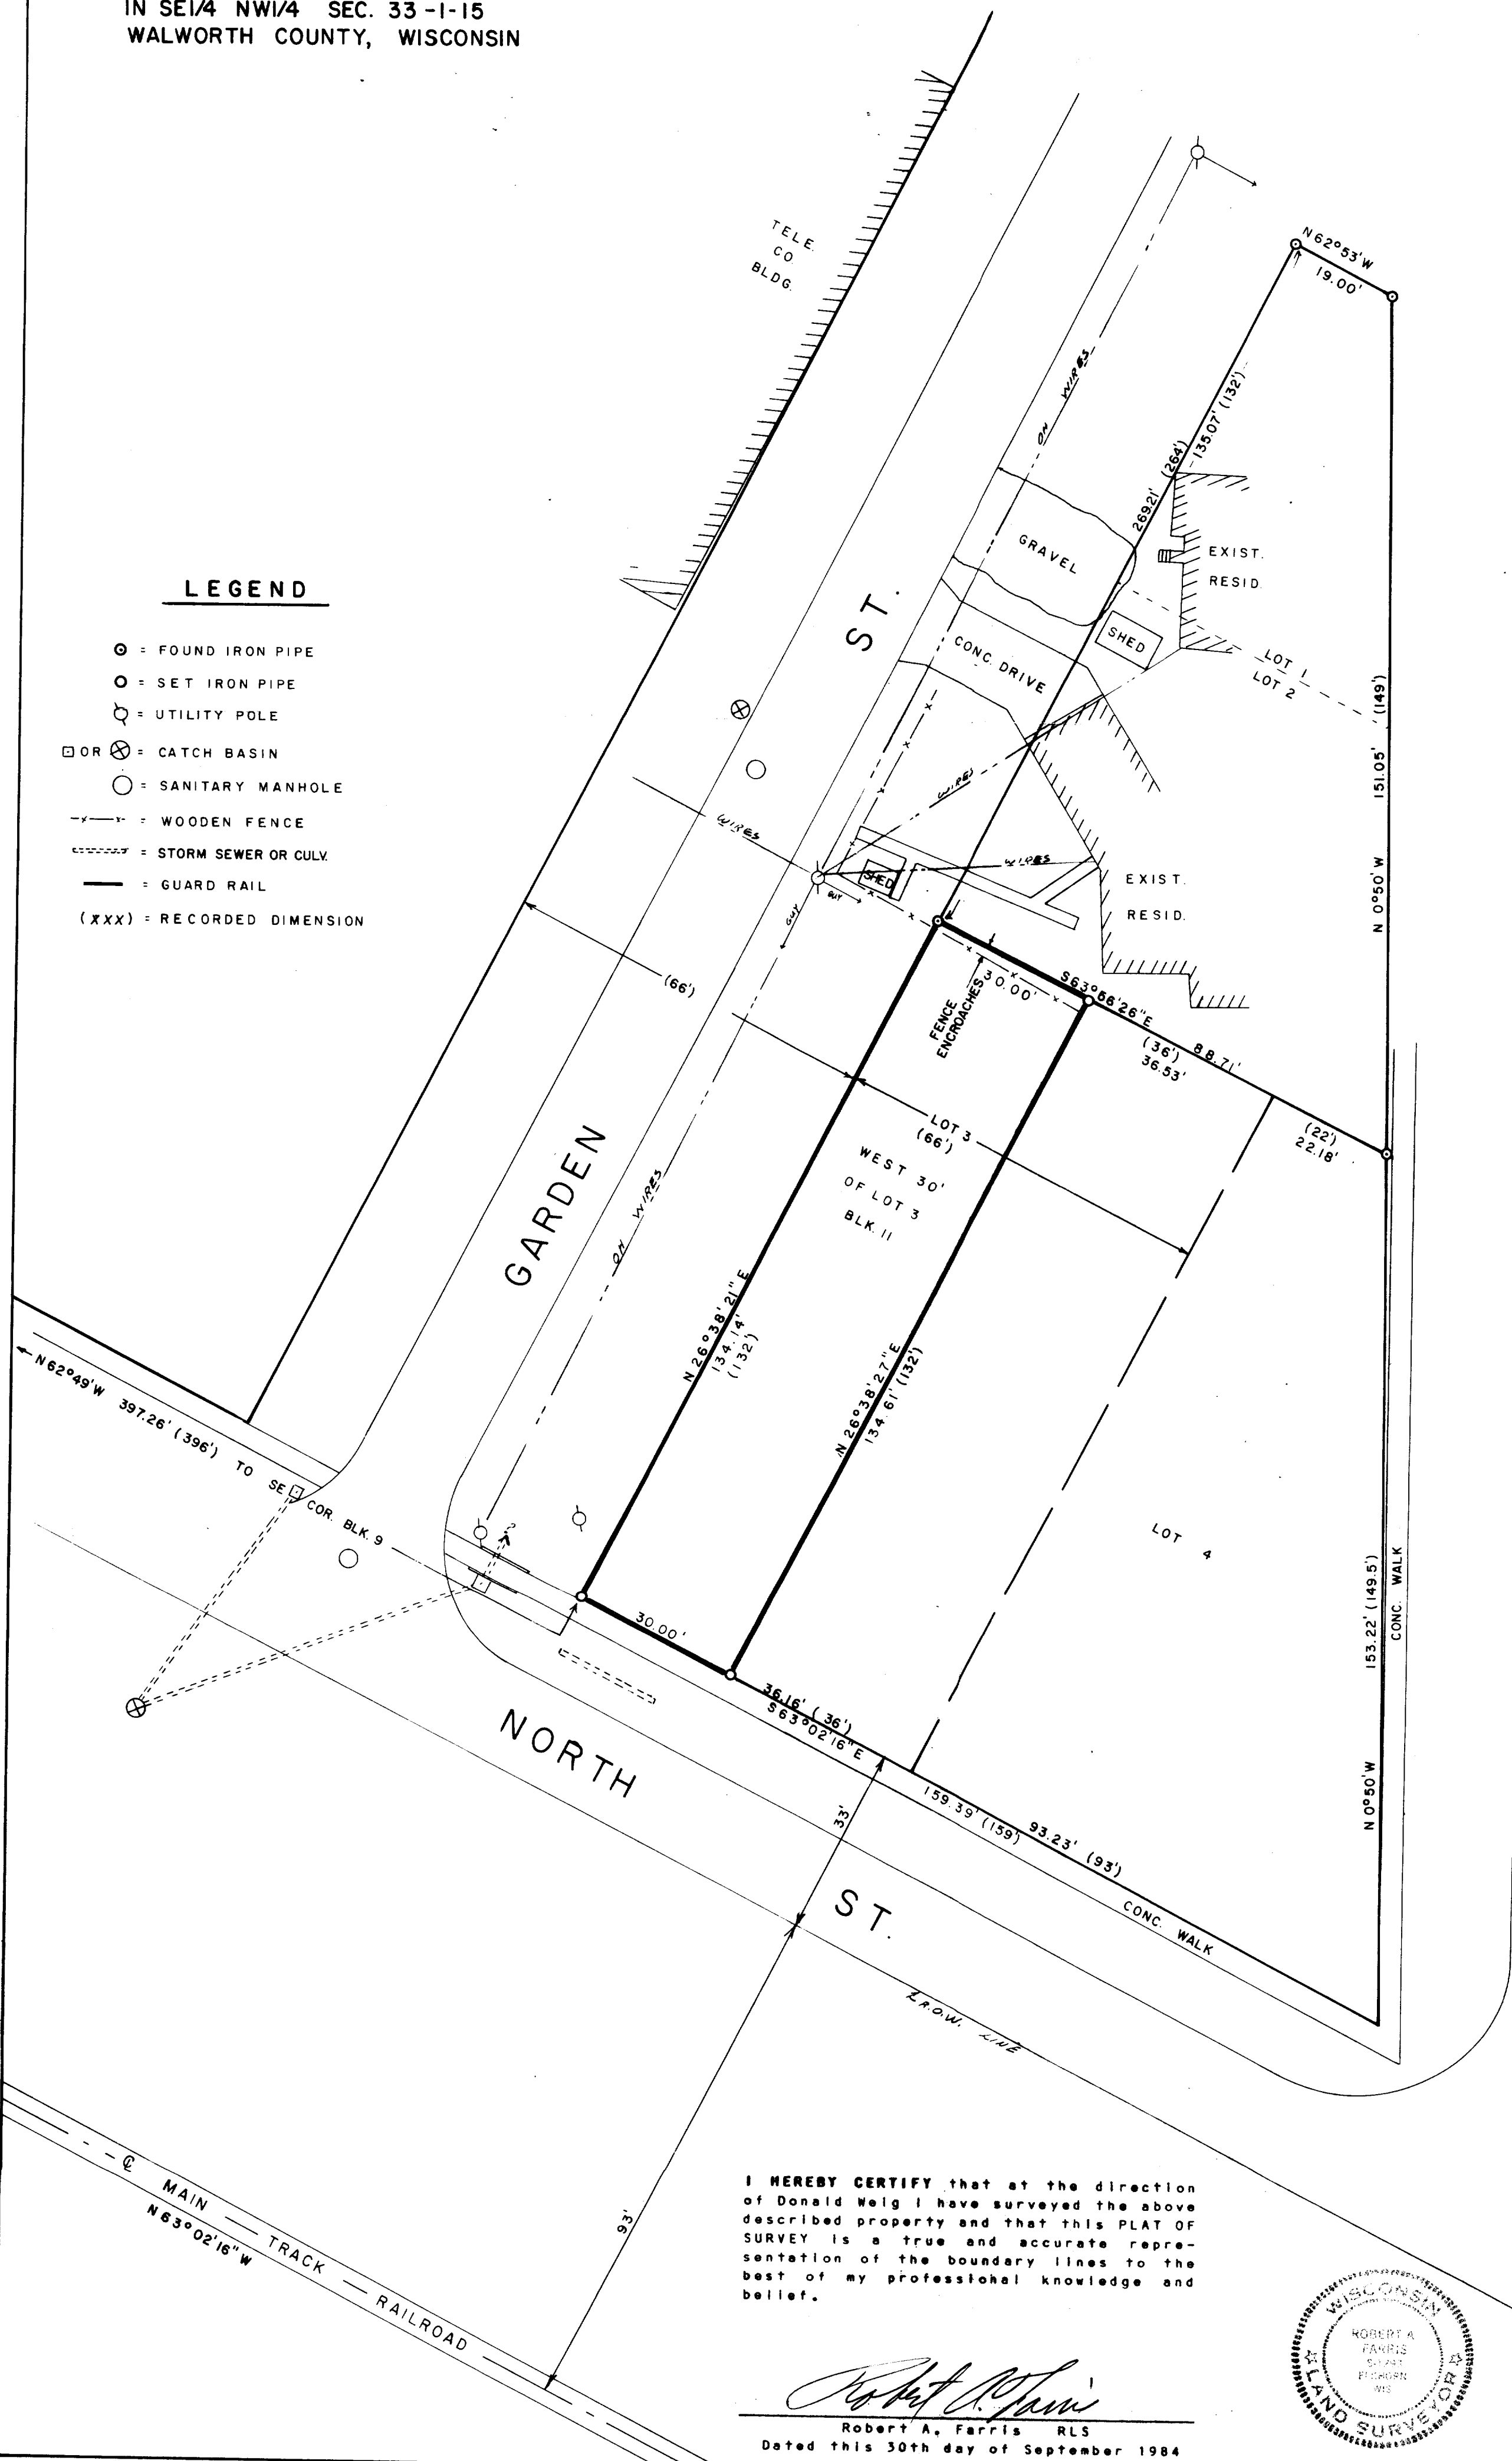


SCALE: 1" = 20'
BRGS. REF. PROJ. 2298 - RAILROAD MAIN
TRACK N 63° 02' 16" W

MARTIN ST.

I HEREBY CERTIFY that at the direction of Donald Weig I have surveyed the above described property and that this PLAT OF SURVEY is a true and accurate representation of the boundary lines to the best of my professional knowledge and belief.

Robert A. Farris
Robert A. Farris RLS

Dated this 30th day of September 1984

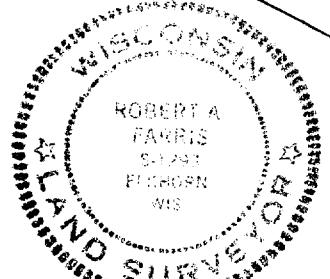

Farris, Hansen & Associates, Inc.
Engineering, Surveying & Land Planning
P.O. BOX 487
715 W. WALWORTH STREET
ELKHORN, WISCONSIN 53121

PROJ. NO. 2305

UOP-74

8-100