
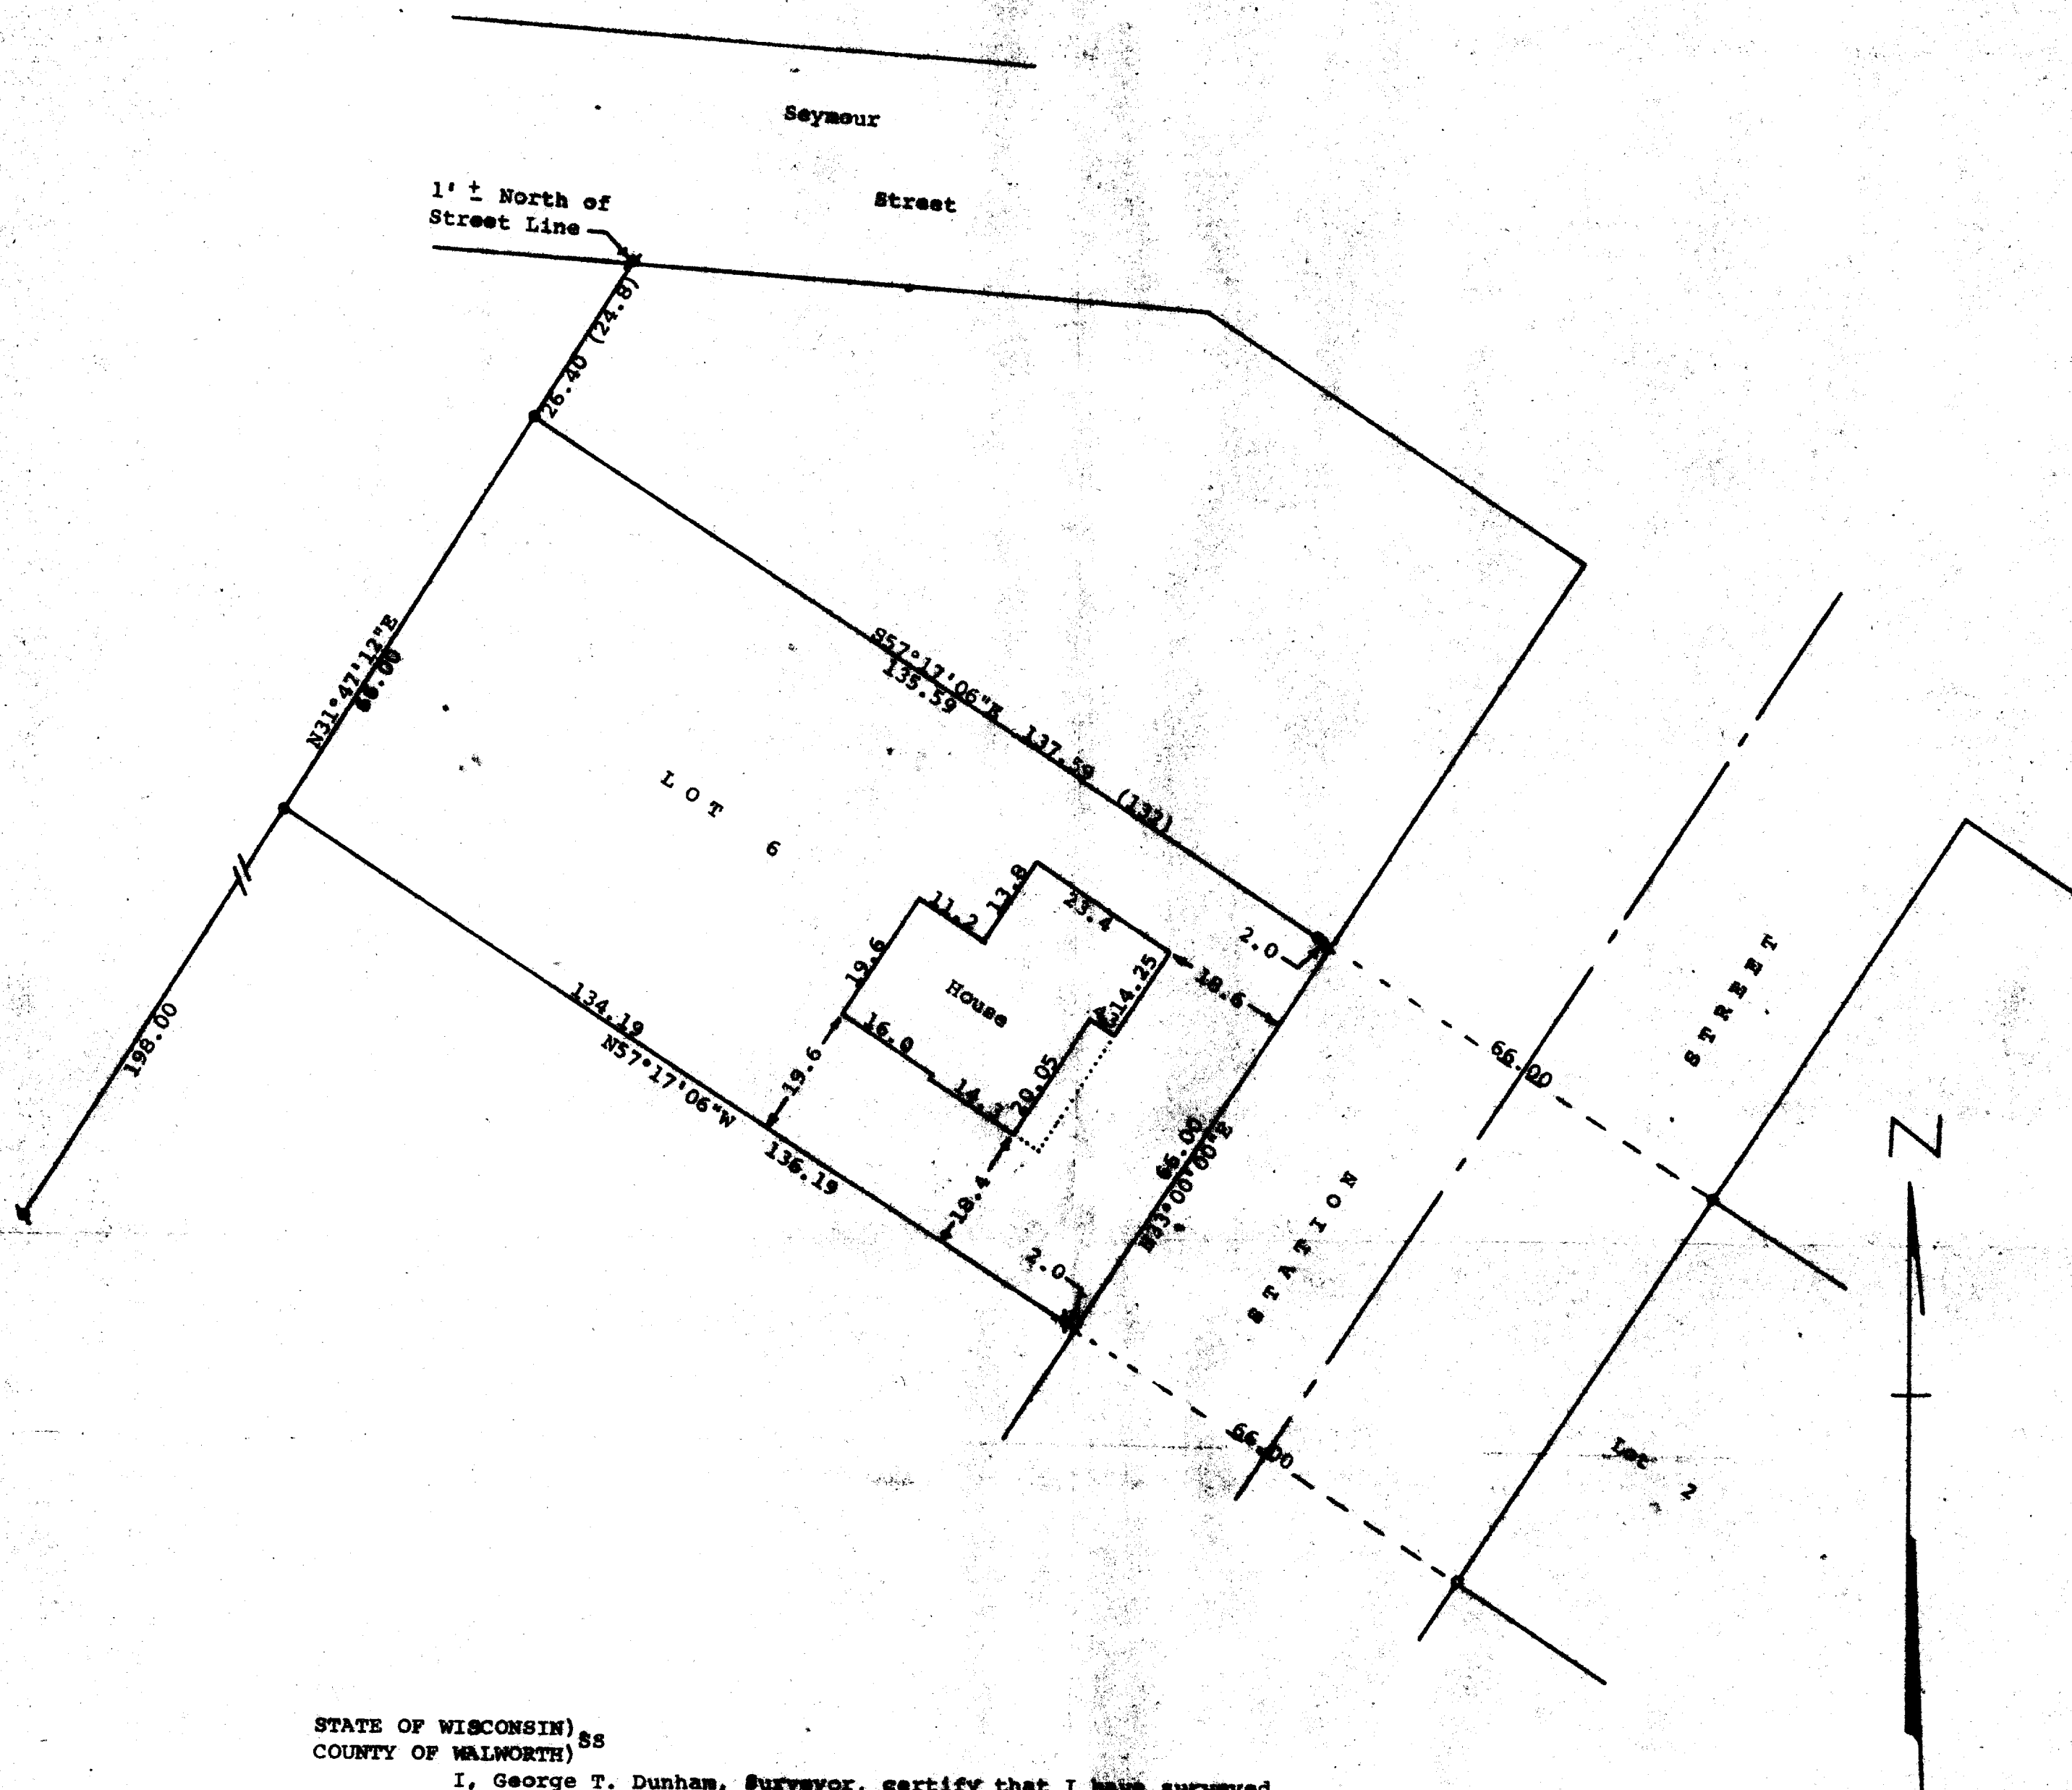


DUNHAM SURVEYING, S.C.
SURVEYING & SUBDIVISIONS
DELAWARE, WISCONSIN 5353

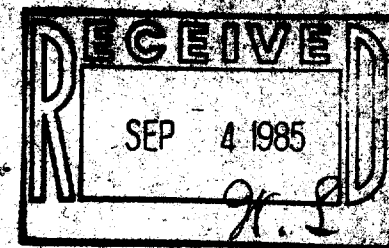

STATE OF WISCONSIN) ss
COUNTY OF WALWORTH)


I, George T. Dunham, Surveyor, certify that I have surveyed the property described as follows:

Lot 6 in Block 5 of the Original Plat of the Village of Sharon, Walworth County, Wisconsin,

and that the above map is a true representation thereof and shows the size and location of the property, its exterior boundaries, the location of all visible structures and dimensions of all principal buildings thereon, boundary fences, apparent easements, roadways and visible encroachments, if any, and that I have surveyed the property herein described according to the official records to the best of my knowledge and belief.

May 1, 1985

George T. Dunham
George T. Dunham, Surveyor

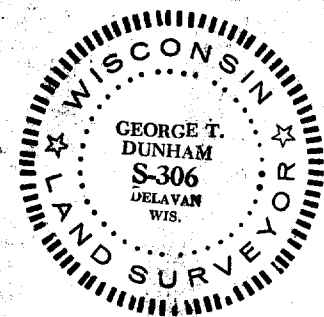

Scale - 1" = 20'

1" = 1" Iron Pipe Found
3/4" = 3/4" Iron Pipe Found
1/2" = 1/2" Iron Pipe Found
1/4" = 1/4" Iron Pipe Set
3/4" X 24" = 3/4" X 24" Iron Pipe Set
X = cross cut in concrete sidewalk

(0.00) = recorded distance
Bearings referenced to the assumed bearing of N33°00'00"E along the north-westerly line of Station Street
Owner: Henry Feuerstein