



KOLB LAND CONSULTING, INC.
LAND SURVEYING • SUBDIVIDING • LAND PLANNING

929 WILLIAMS STREET LAKE GENEVA, WISCONSIN 53147 414-248-3697

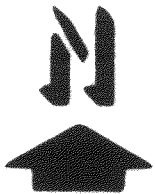

SCALE: 1" = 40'

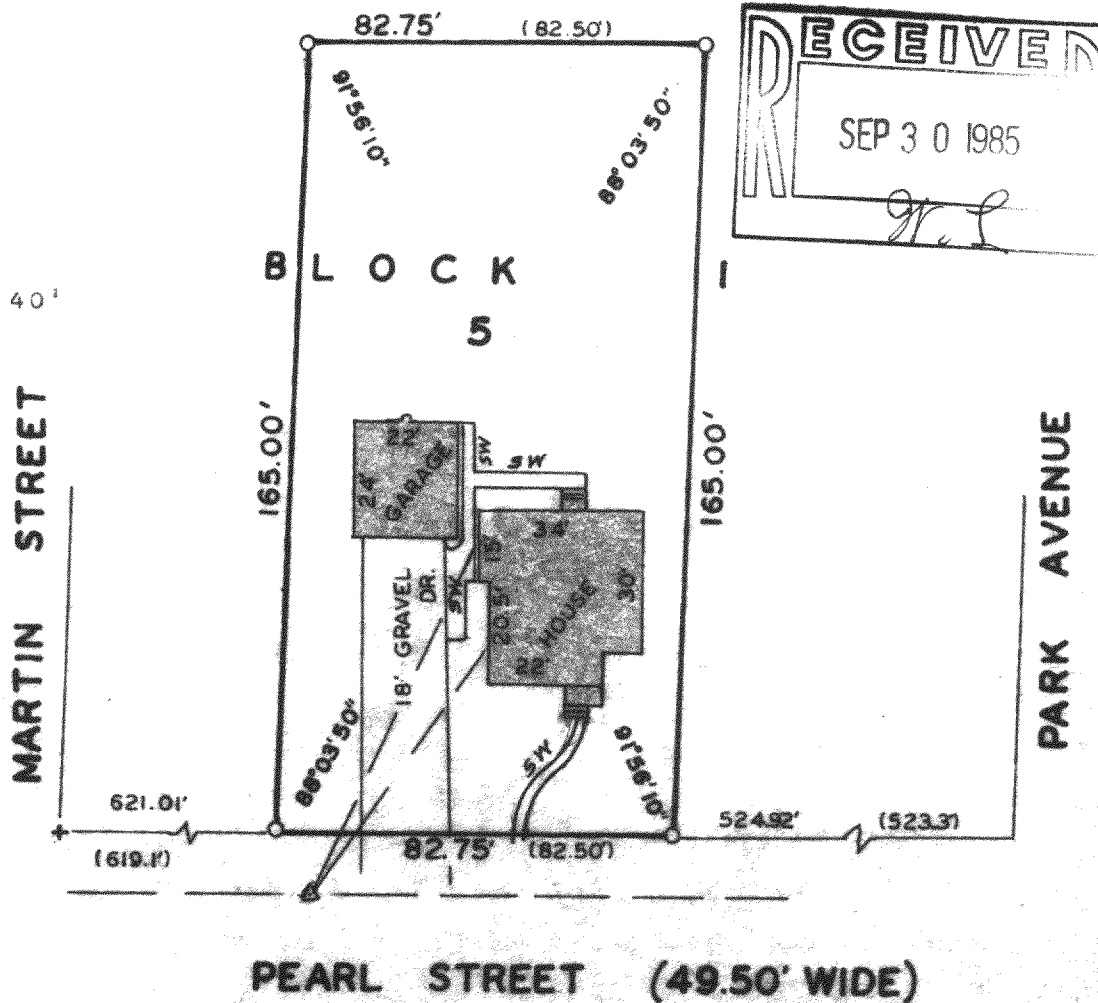

LEGEND

- O- 1 1/4" X 24" IRON PIPE SET
- Δ- UTILITY POLE
- OVERHEAD UTILITY LINE
- + CUT CROSS IN CONC. FOUND
- ()- AS RECORDED
- SW - SIDEWALK

ORDERED BY: RICHARD CAIN
P.O. BOX 351
FONTANA, WI. 53125

PLAT OF SURVEY OF

LOT 5, BLOCK 1, OF WISE'S SUBDIVISION OF LOTS 14 AND 15, BLOCK 7, CITIZEN'S ADDITION TO THE VILLAGE OF SHARON, WALWORTH COUNTY WISCONSIN.

I HEREBY CERTIFY THAT I HAVE SURVEYED THE ABOVE DESCRIBED PROPERTY AND THAT THE ABOVE MAP IS A TRUE REPRESENTATION THEREOF AND SHOWS THE SIZE AND LOCATION OF THE PROPERTY, ITS EXTERIOR BOUNDARIES, THE LOCATION OF ALL VISIBLE STRUCTURES AND DIMENSIONS OF ALL PRINCIPAL BUILDINGS THEREON, BOUNDARY FENCES, APPARENT EASEMENTS, ROADWAYS AND VISIBLE ENCROACHMENTS, IF ANY, TO THE BEST OF MY KNOWLEDGE AND BELIEF.

THIS SURVEY IS MADE FOR THE USE OF THE PRESENT OWNERS OF THE PROPERTY, AND ALSO THOSE WHO PURCHASE, MORTGAGE, OR GUARANTEE THE TITLE THERETO WITHIN ONE (1) YEAR FROM DATE HEREOF.

Harold H. Kolb


HAROLD H. KOLB

WISCONSIN REGISTERED LAND SURVEYOR, S-187

DATE AUGUST 21, 1985

REVISED

REVISED

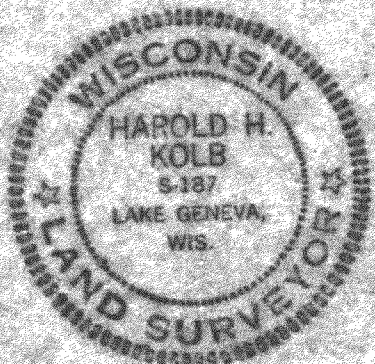

UWS-00005

S-UWS-14 8-107