


DUNHAM SURVEYING, S.C.
SURVEYING & SUBDIVIDING
DELAVER, WISCONSIN 53115

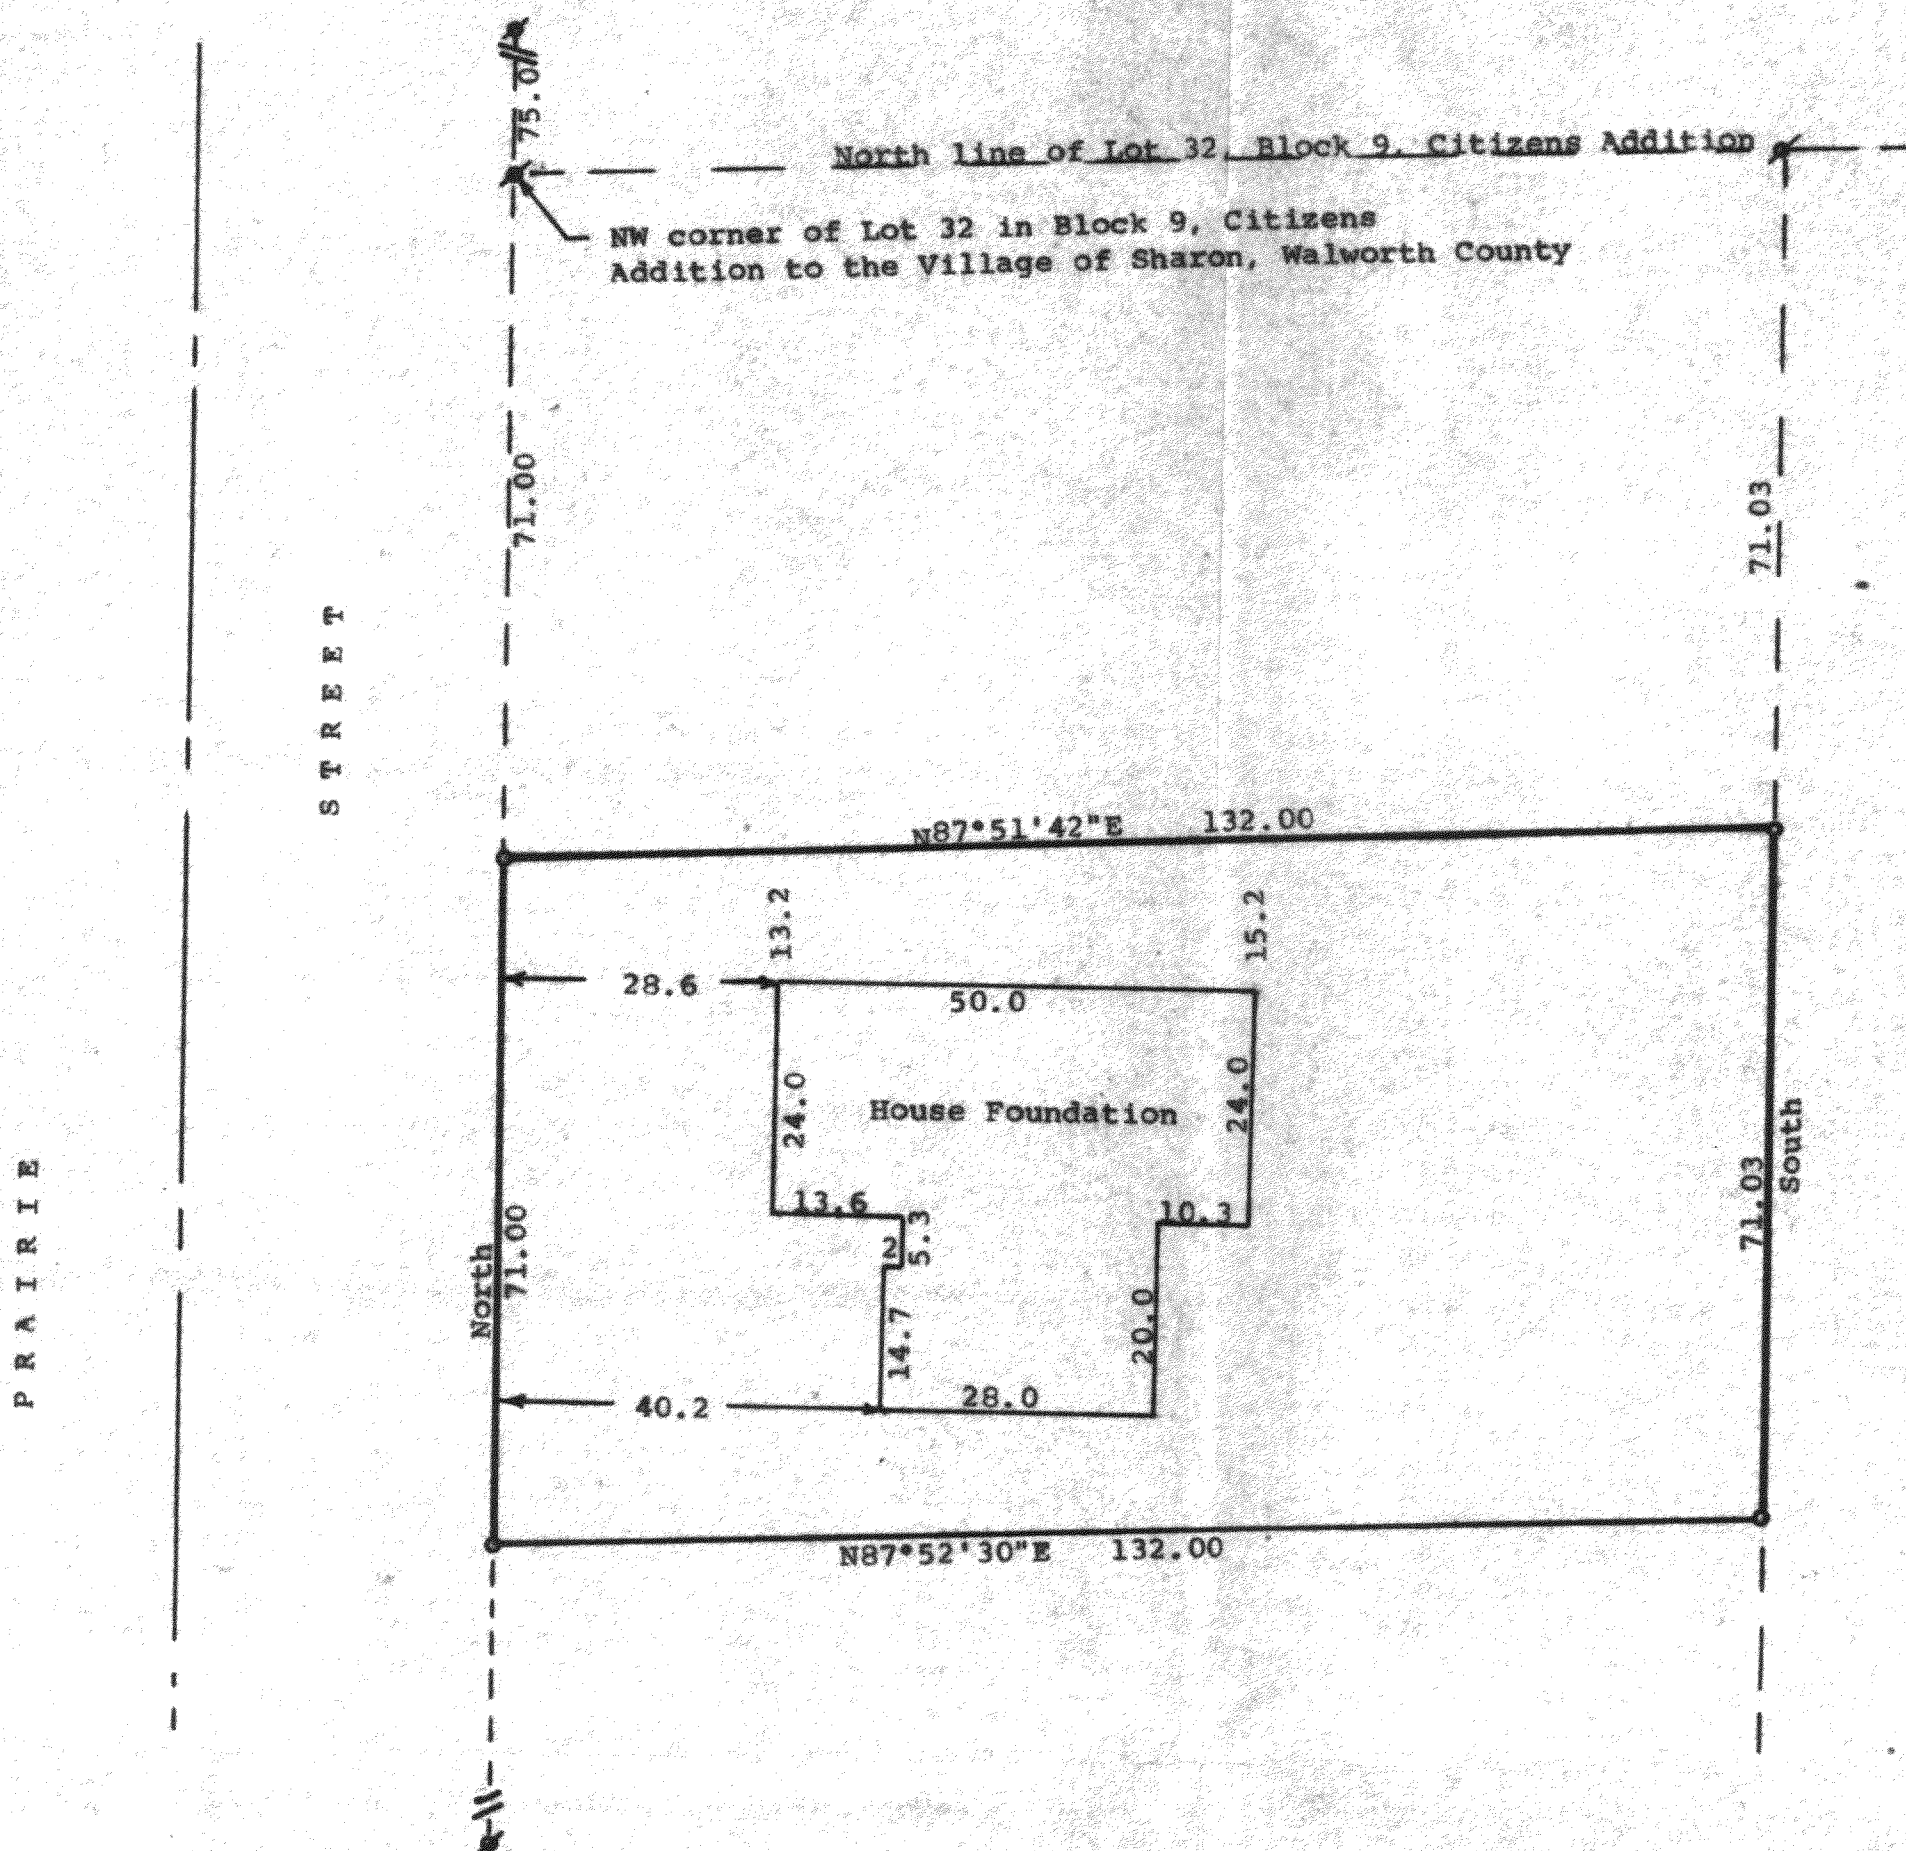

N

Scale - 1" = 20'
= 1" Iron Pipe Found
o = 1 1/4" X 24" Iron Pipe Set

Bearings are referenced to the east line of Prairie Street with the assumed bearing of North
Survey ordered by: Donna Hardt
P.O. Box 48
Sharon, WI 53585

STATE OF WISCONSIN) SS
COUNTY OF WALWORTH)

I, George T. Dunham, Surveyor, certify that I have surveyed the property described as follows:

A part of Lots 31 and 32 in Block 9 of Citizens Addition, Village of Sharon, Walworth County, Wisconsin, described as follows: Commencing at the northwest corner of said Lot 32; thence South along the west line of said Lots 32 and 31, 142.00 feet to the place of beginning; thence N87°52'30"E 132.00 feet; thence North 71.00 feet; thence S87°51'42"W 132.00 feet; thence South along the west line of said Lots 32 and 31, 71.00 feet to the place of beginning.

and that the plat shown hereon is a correct representation thereof and shows the size and location of the property, its exterior boundaries, the location of all visible structures and dimensions of all principal buildings thereon, boundary fences, apparent easements, roadways and visible encroachments, if any, and that I have surveyed the property hereon described, according to the official records, to the best of my knowledge and belief.

April 18, 1988
Revised May 11, 1988

George T. Dunham
George T. Dunham, Surveyor

