
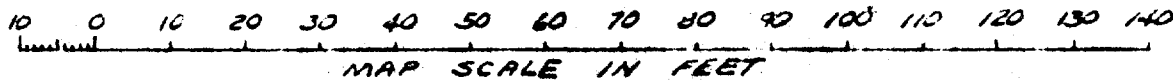


FARRIS, HANSEN & ASSOCIATES, INC.
7 RIDGEWAY COURT, ELKHORN, WI
414-723-2311

PLAT OF SURVEY OF

LOT 1 OF C.S.M. #1716 LOCATED IN THE SOUTHWEST 1/4 OF THE NORTHWEST 1/4
SECTION 33, TOWN 1 NORTH, RANGE 15 EAST, VILLAGE OF SHARON
WALNORTH COUNTY, WISCONSIN

WORK ORDERED BY: SOUTHEASTERN WISCONSIN HOUSING C/O BOB STEIN

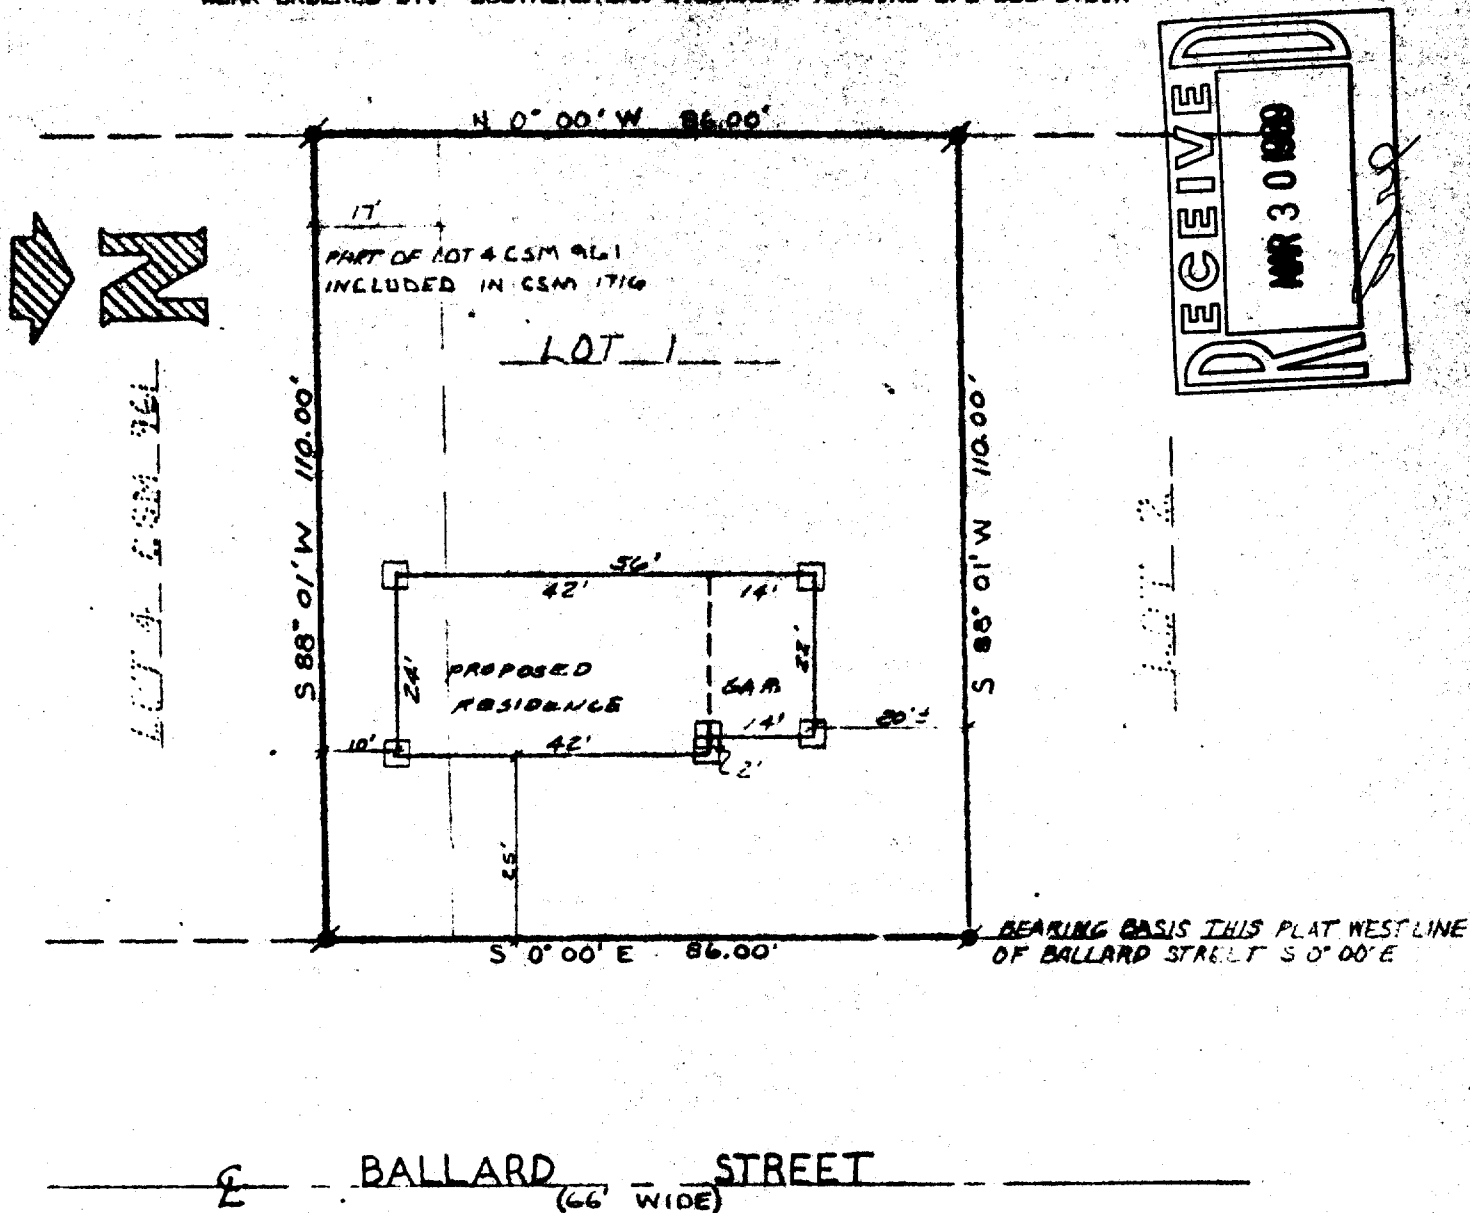

○ = FOUND IRON PIPE STAKE ● = SET RE-BAR STAKE * = FOUND RE-BAR
(x x x) = ORIGINAL PLAT DIMENSION
□ = 1x2 WOOD STAKE SET

I hereby certify that this plat of survey is a true and accurate representation of the lot lines and proposed building location to the best of my knowledge and belief.

Robert A. Farris, R.L.S.

DATED: MARCH 22, 1989
REVISED MARCH 29, 1989
AS STAKED



PROJECT # 1335.1716.1
8-146