


FARRIS, HANSEN & ASSOCIATES, INC.
7 RIDGEWAY COURT, ELKHORN, WI
414-723-2070

PLAT OF SURVEY OF

LOT 2 OF C.S.M. 81716 LOCATED IN THE SOUTHWEST 1/4 OF THE NORTHWEST 1/4
SECTION 33, TOWN 1 NORTH, RANGE 18 EAST, VILLAGE OF SHARON
WALMOUTH COUNTY, WISCONSIN

WORK ORDERED BY: SOUTHEASTERN WISCONSIN HOUSING C/O BOB STEIN

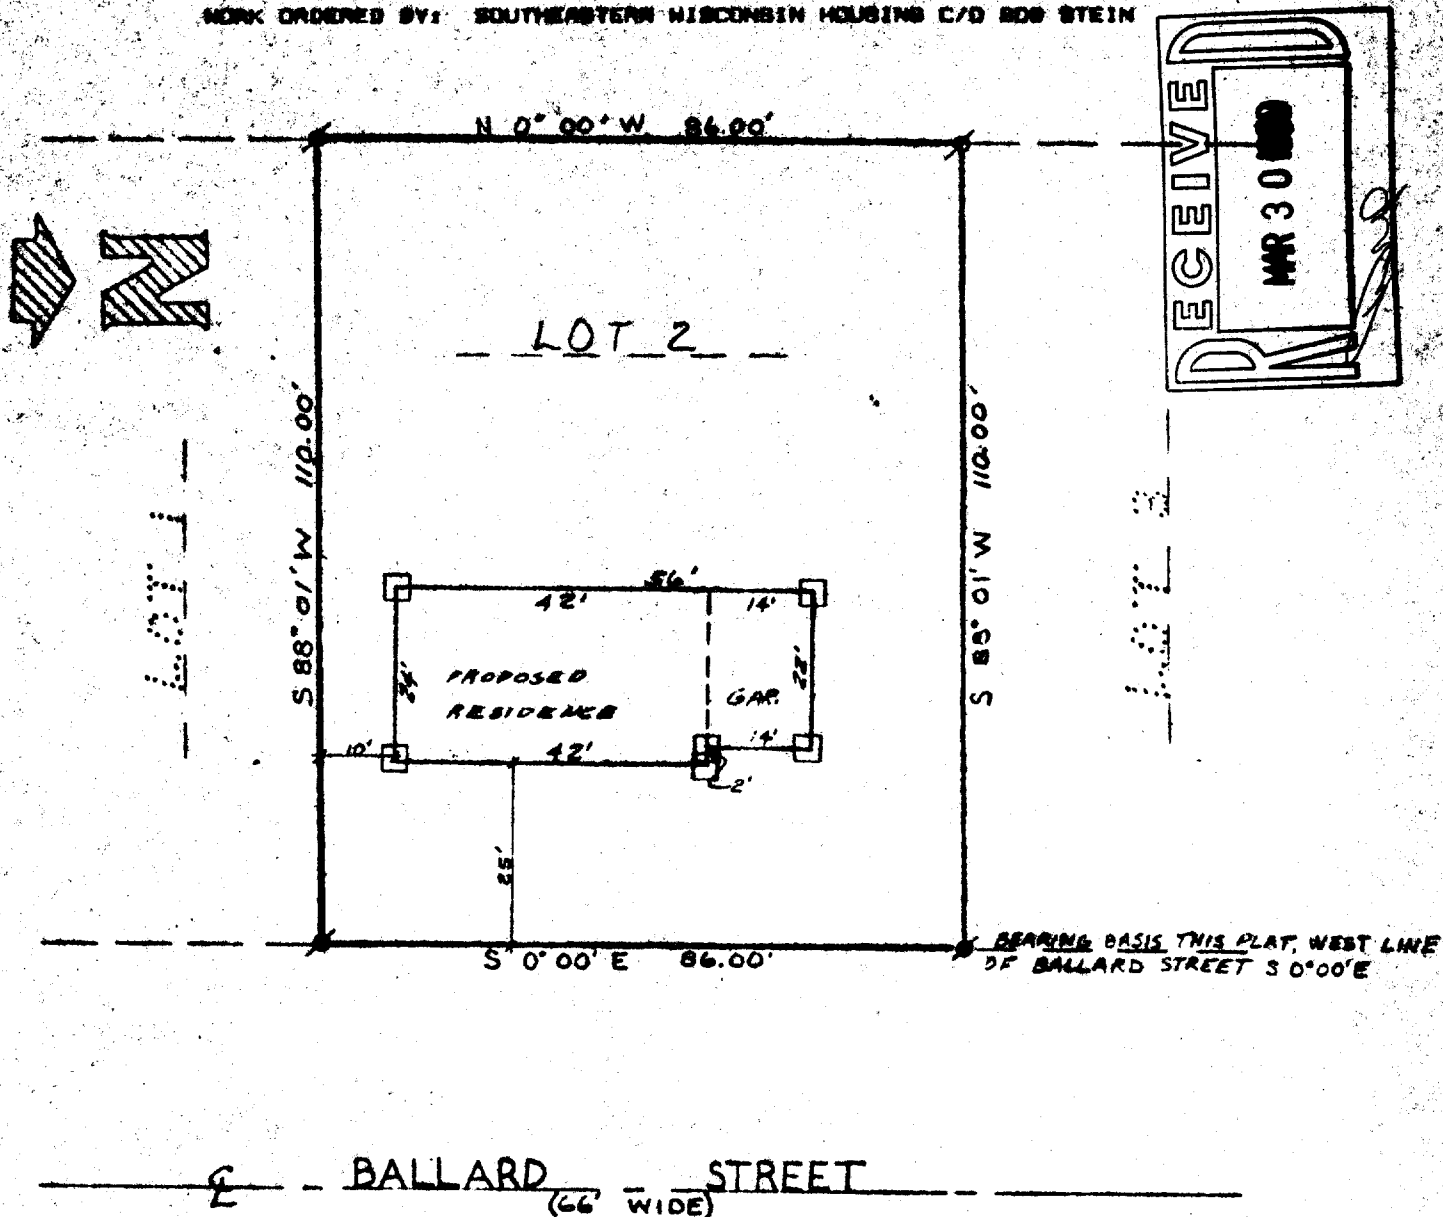

10 0 10 20 30 40 50 60 70 80 90 100 110 120 130 140
MAP SCALE IN FEET


○ = FOUND 1/2" PIPE STAKE ● = SET REBAR STAKE * = FOUND RE-BAR
(XIX) = ORIGINAL PLAT DIMENSION
□ = 1"x2" WOOD STAKESET

I hereby certify that this plat of survey is a true and accurate representation of the lot lines and proposed building location to the best of my knowledge and belief.

Robert A. Farris, R.L.S.

DATED: MARCH 22, 1989

REVISED MARCH 29, 1989
AS STAKED

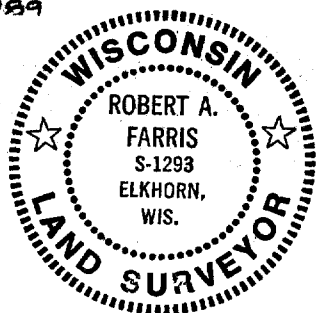

PROJECT # 1535.1716.2

8-147