
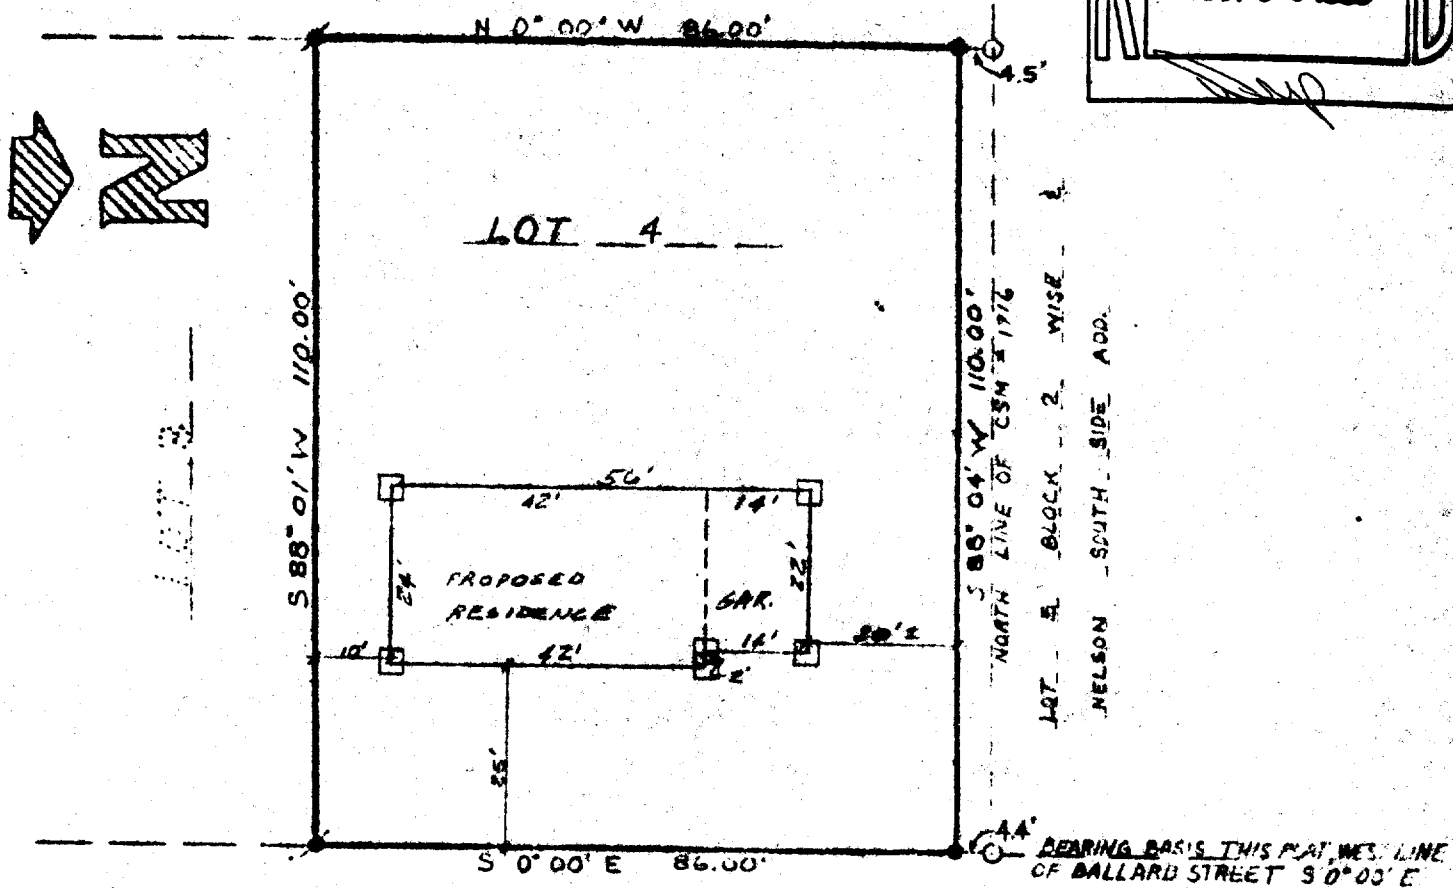


FARRIS, HANSEN & ASSOCIATES, INC.
7 RIDGEWAY COURT, ELKHORN, WI
414-723-2098


PLAT OF SURVEY OF

The South 86 feet of LOT 4 OF C.S.M. #1716 LOCATED IN THE SOUTHWEST 1/4 OF THE NORTHWEST 1/4
SECTION 33, TOWN 1 NORTH, RANGE 18 EAST, VILLAGE OF SHARON
WALNORTH COUNTY, WISCONSIN

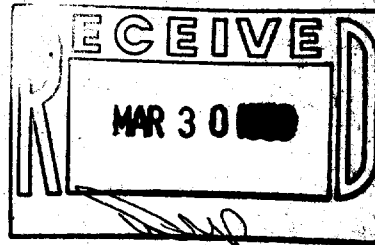

BALLARD STREET
(66' WIDE)

WORK ORDERED BY: SOUTHEASTERN WISCONSIN HOUSING C/O BOB STEIN

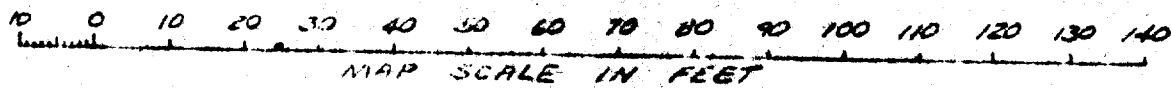


○ FOUND IRON PIPE STAKE * = SET RE-BAR STAKE # = FOUND RE-BAR
(XX) = ORIGINAL PLAT DIMENSION
□ 1X2 WOOD STAKE SET

I hereby certify that this plat of survey is a true and accurate representation of the lot lines and proposed building location to the best of my knowledge and belief.

Robert A. Farris
Robert A. Farris, L.L.S.

DATED: MARCH 22, 1989

REVISED: MARCH 29, 1989
AS STAKED

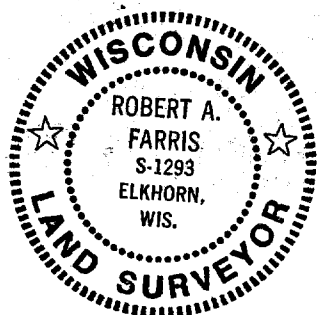

PROJECT # 1335.1716.4
8-149