


FARRIS, HANSEN & ASSOCIATES, INC.
7 RIDGEWAY COURT, ELKHORN, WI
414-723-2070

PLAT OF SURVEY OF

THE SOUTH 88' OF LOT 4 CSM #961 LOCATED IN THE SOUTHWEST 1/4 OF THE NORTHWEST 1/4 SECTION 33,
TOWN 1 NORTH, RANGE 15 EAST, VILLAGE OF SHARON
WALWORTH COUNTY, WISCONSIN

WORK ORDERED BY: SOUTHEASTERN WISCONSIN HOUSING C/O BOB STEIN

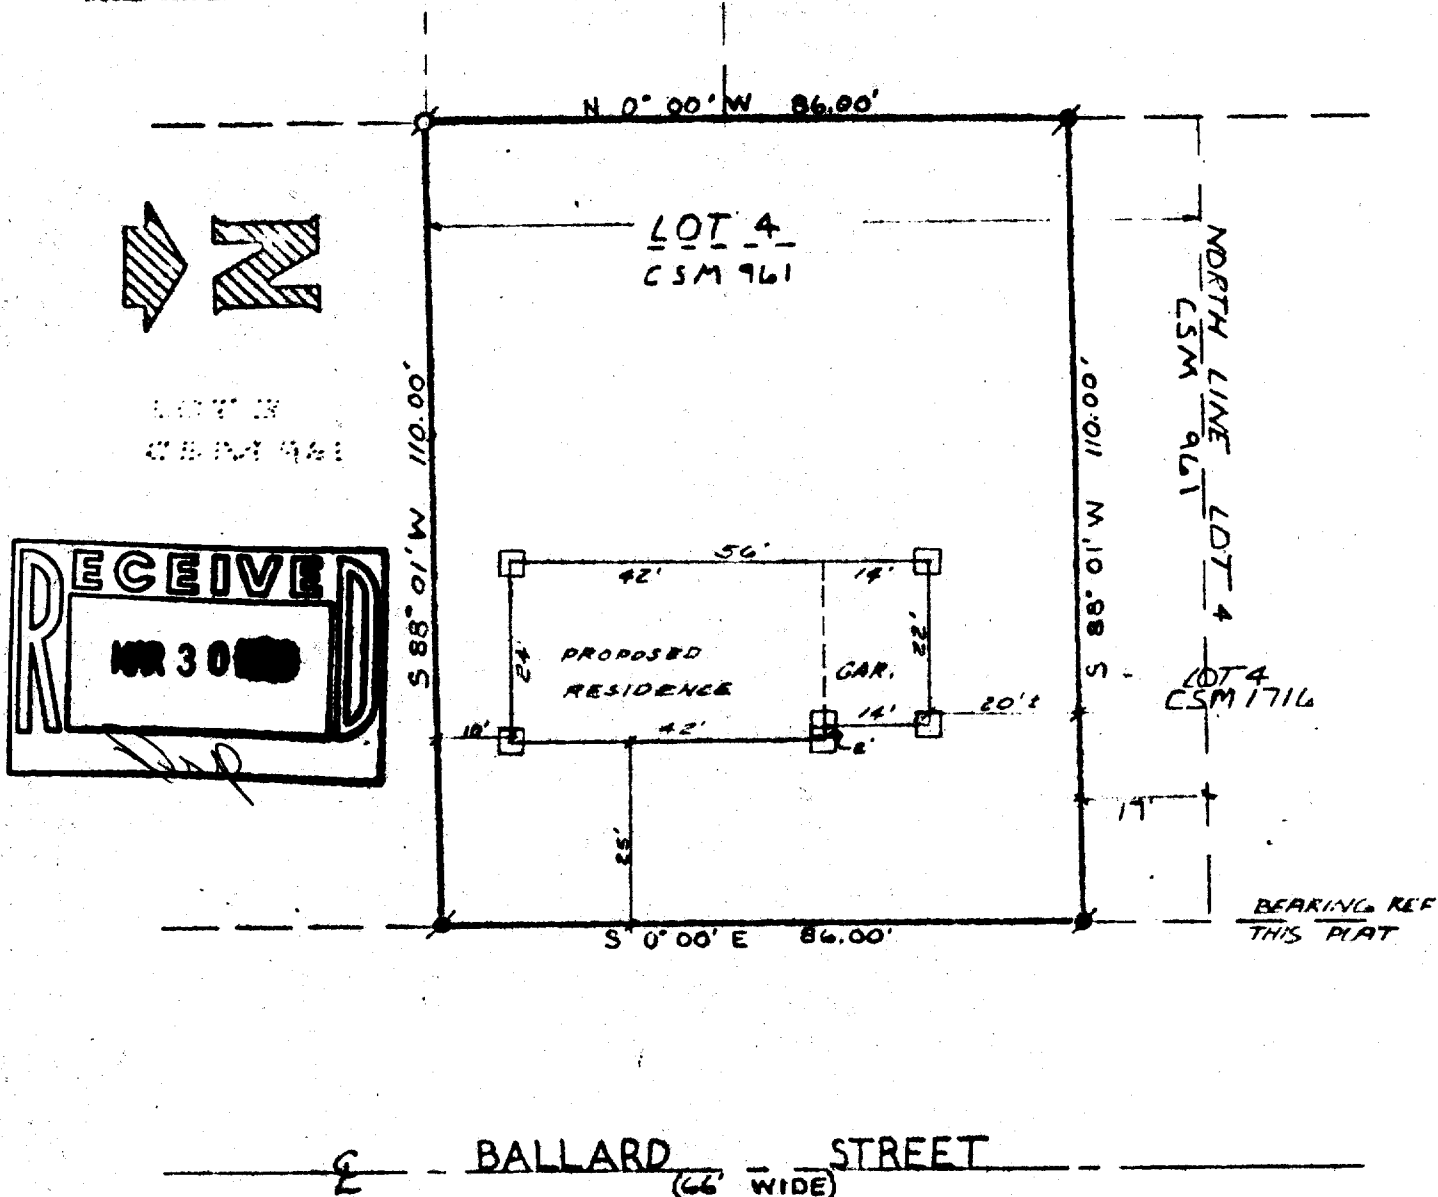


10 0 10 20 30 40 50 60 70 80 90 100 110 120 130 140
MAP SCALE IN FEET

Q-FOUND IRON PIPE STAKE * SET RE-BAR STAKE * FOUND RE-BAR
(KEY) : ORIGINAL PLAT DIMENSION
□ = 1x6 WOOD STAKE SET

I hereby certify that this plat of survey is a true and accurate representation of the lot
lines and proposed building location to the best of my knowledge and belief.

Robert A. Farris, R.L.S.

DATED: MARCH 22, 1989
REVISED MARCH 29, 1989
AS STAKED

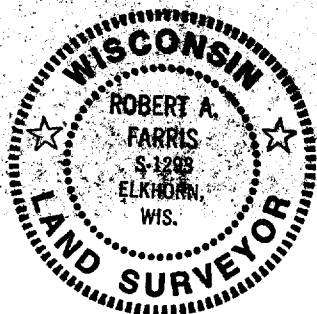

PROJECT # 1535.961.4
8-150