



DUNHAM SURVEYING, S.C.
SURVEYING & SUBDIVIDING
DELAVER, WISCONSIN 53115

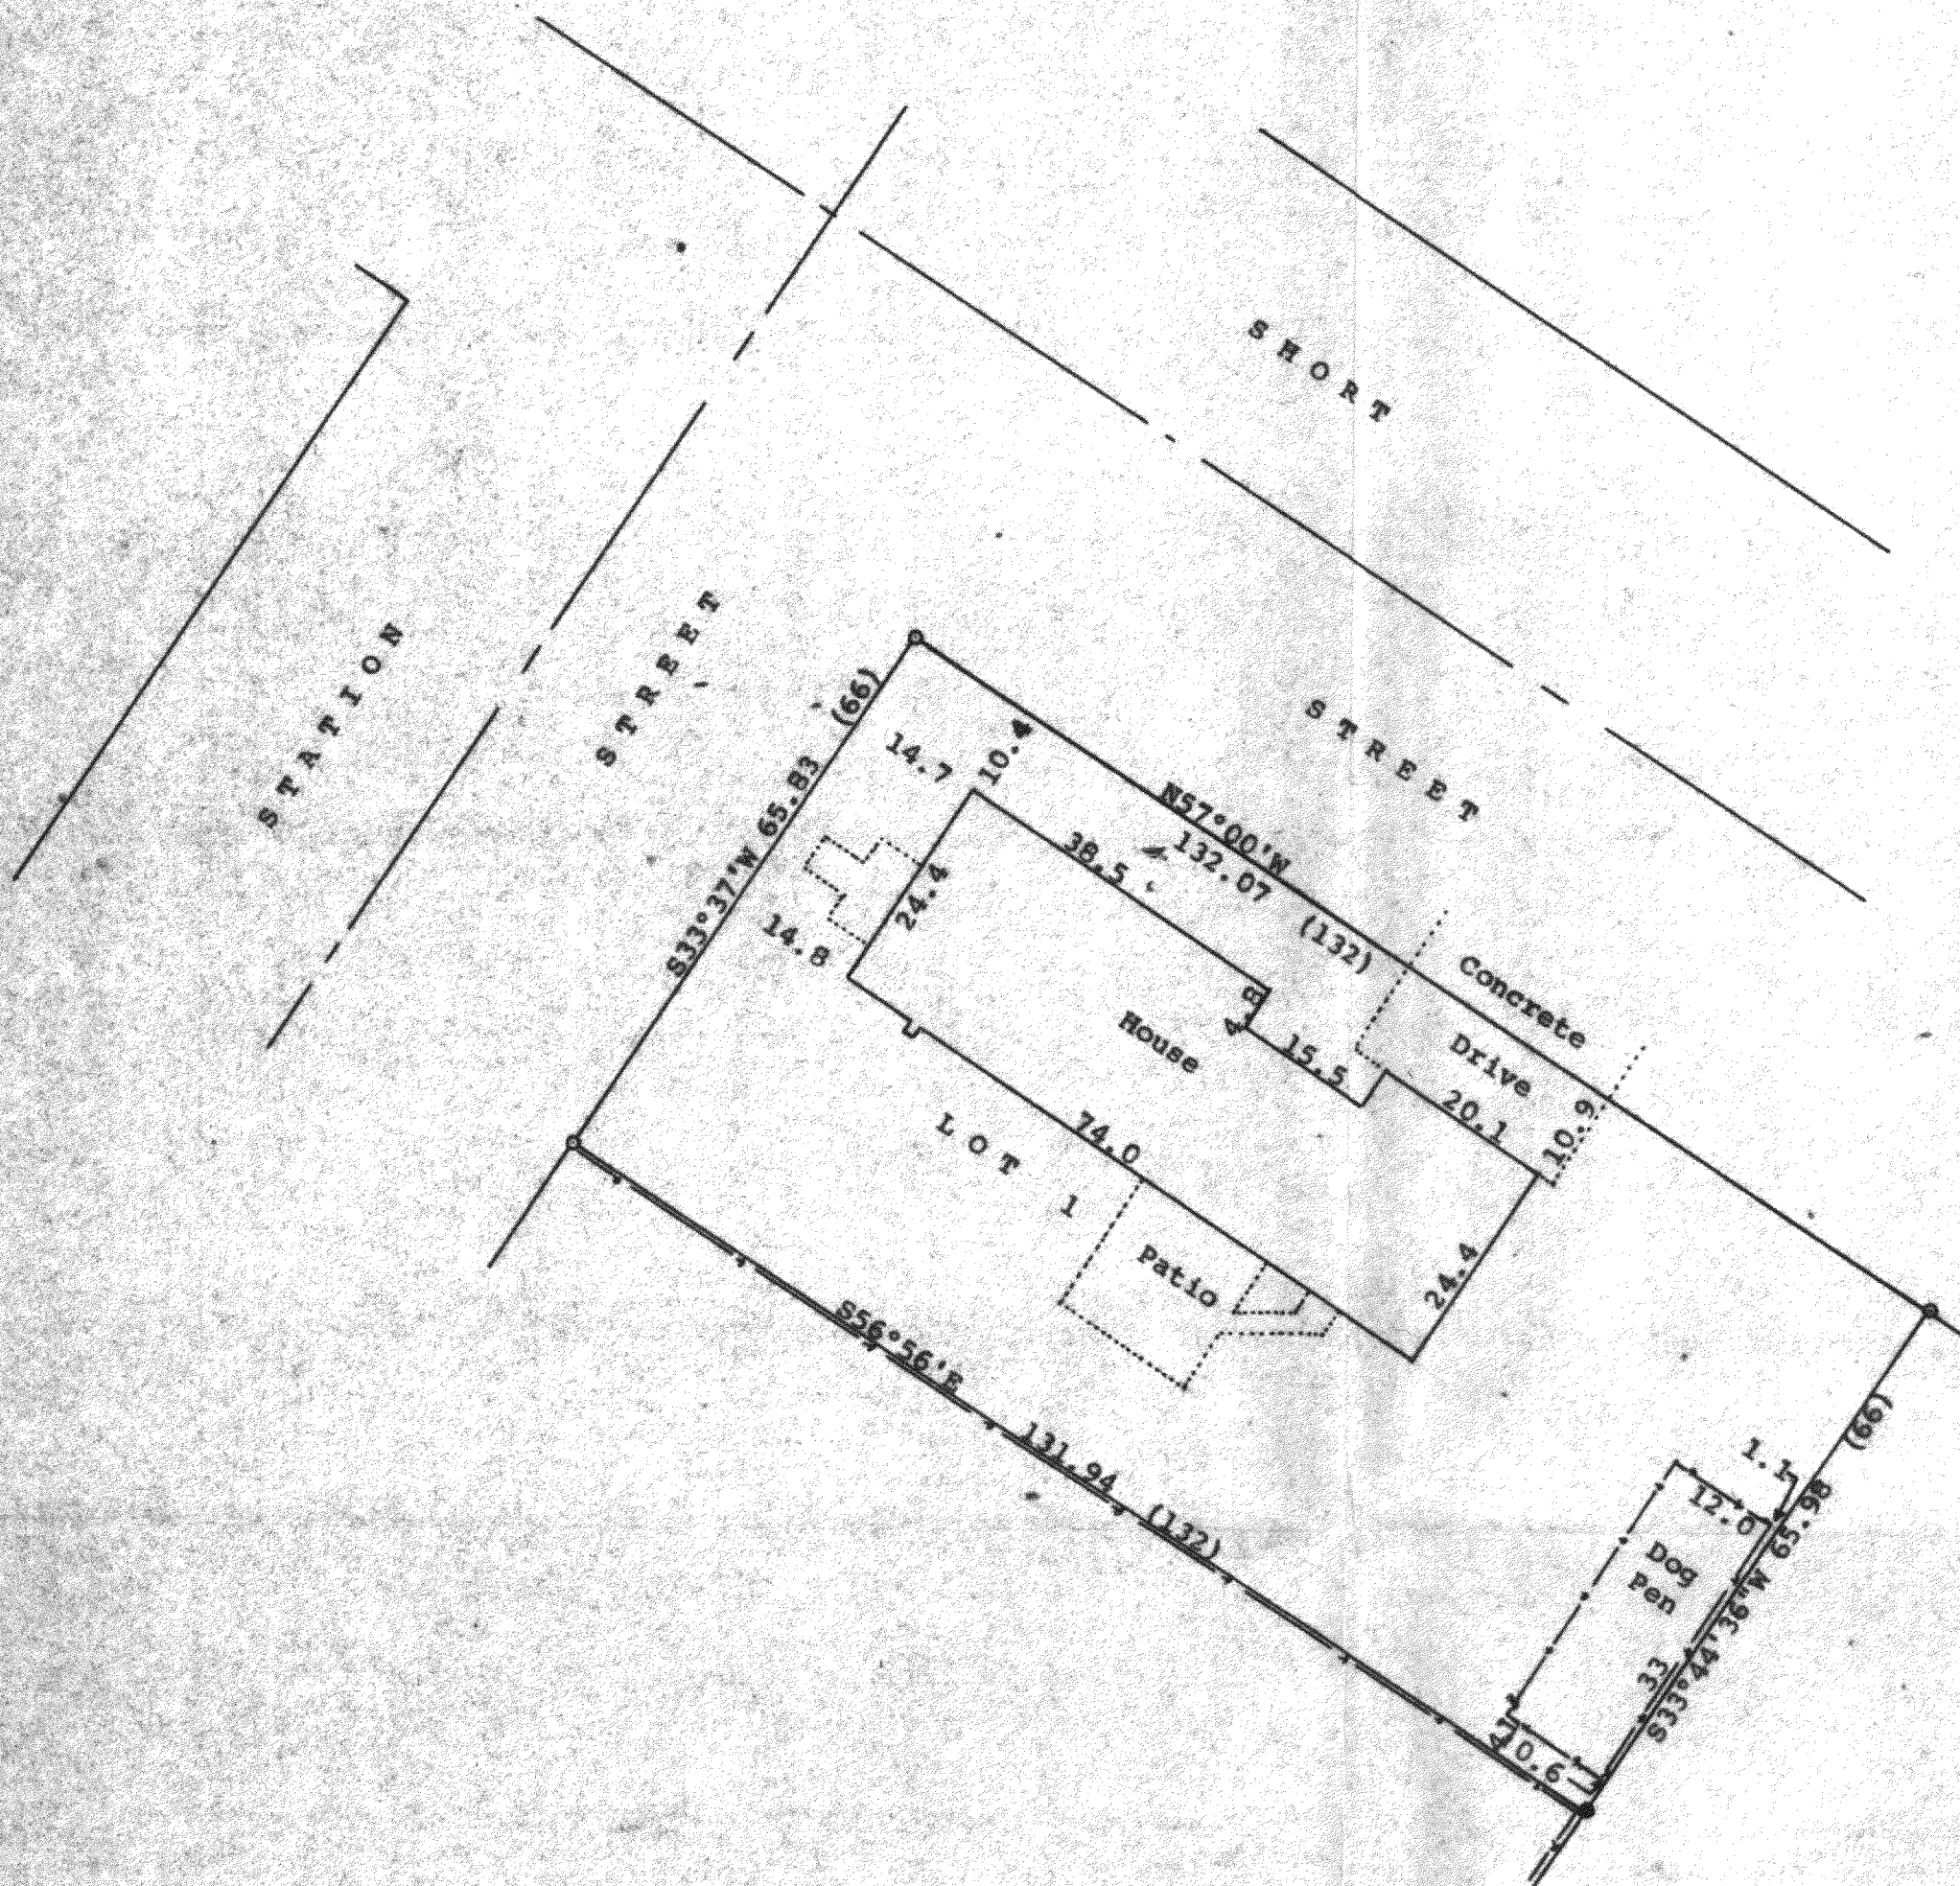

Scale - 1" = 20'
o = 3/4" Iron Pipe Found
• = 5/8" Iron Rod Found
--- = Fence Line
Bearings referenced to the recorded bearing of N57°W along the southerly line of Short Street.
Survey ordered by: Mikrut Realty
Sharon, WI 53585
(0.00) = recorded distance

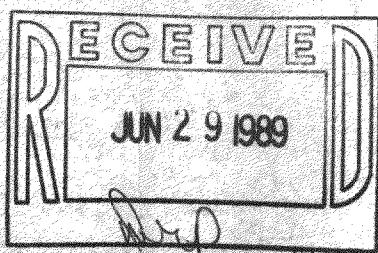

STATE OF WISCONSIN) ss
COUNTY OF WALWORTH)

I, George T. Dunham, Surveyor, certify that I have surveyed the property described as follows:

Lot 1 in Block 4 of the Original Plat of the Village of Sharon, Walworth County, Wisconsin,

and that the plat shown hereon is a correct representation thereof and shows the size and location of the property, its exterior boundaries, the location of all visible structures and dimensions of all principal buildings thereon, boundary fences, apparent easements, roadways and visible encroachments, if any, and that I have surveyed the property hereon described, according to the official records, to the best of my knowledge and belief.

June 5, 1989

George T. Dunham
George T. Dunham, Surveyor

