


DUNHAM SURVEYING, S.C.
SURVEYING & SUBDIVIDING
DELAVER, WISCONSIN 53115

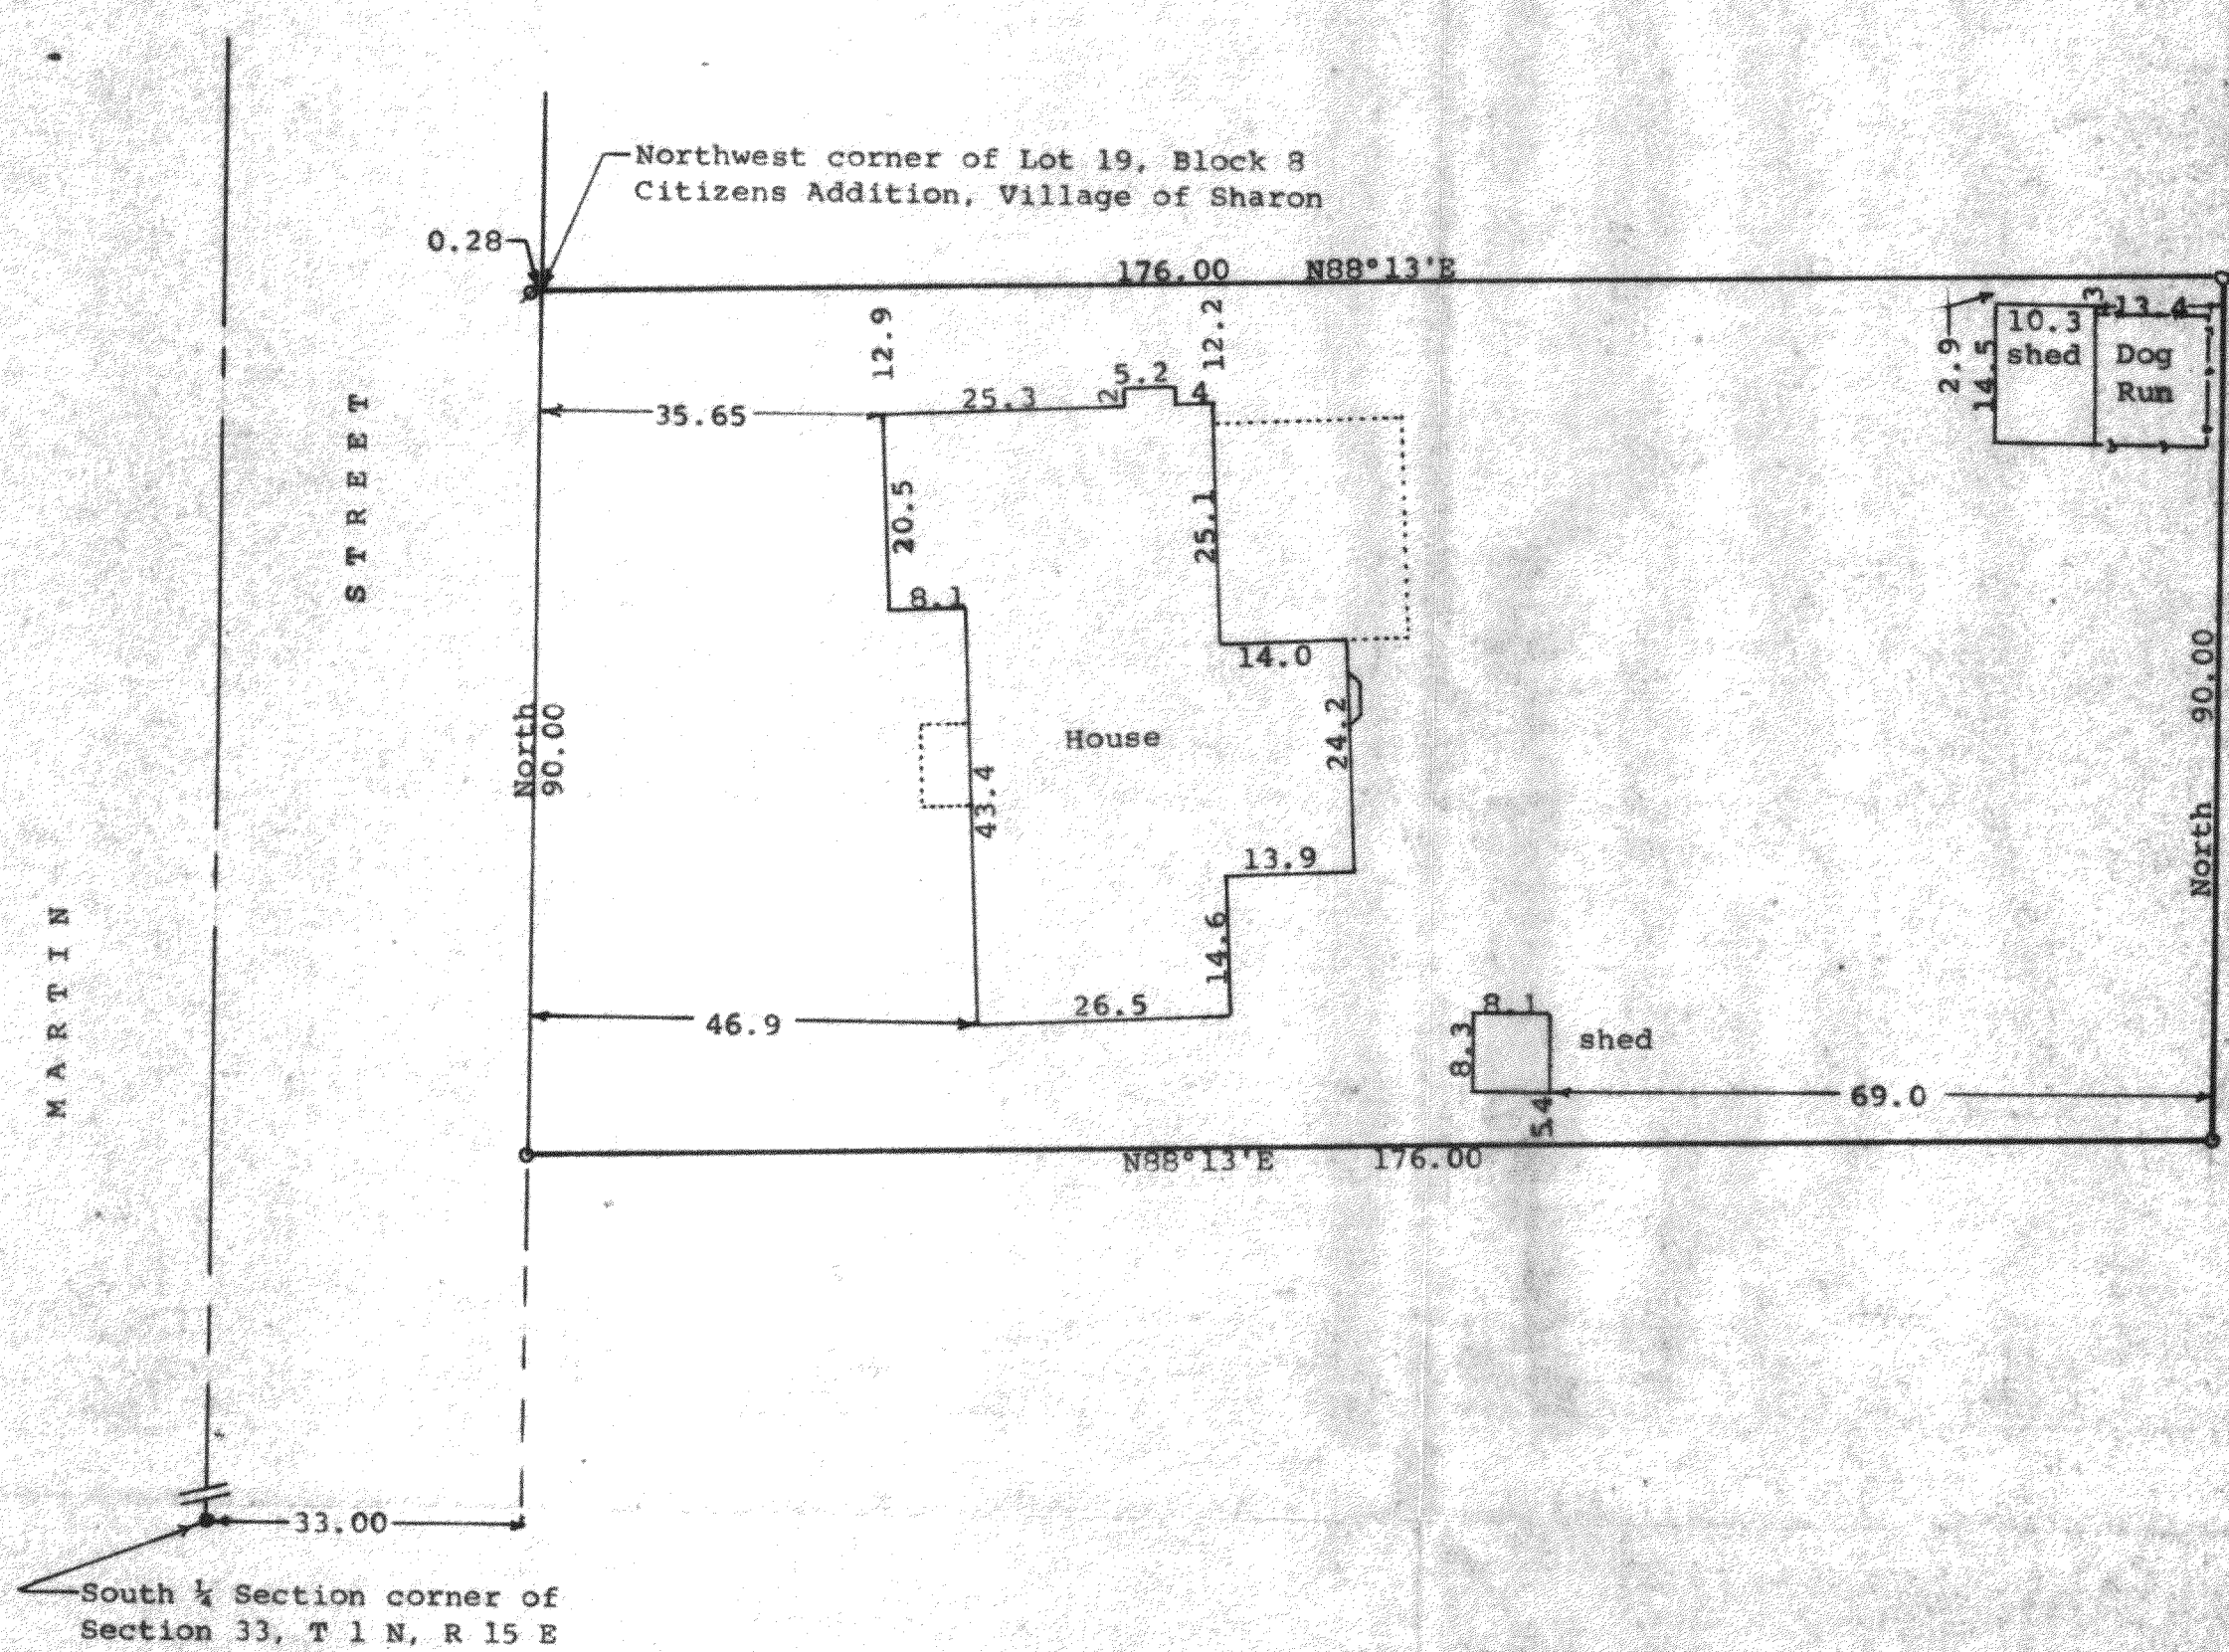

Scale - 1" = 20'
 ● = Concrete Monument
 ○ = 1" Iron Pipe Found
 ○ = 3/4" Iron Pipe Found and corrected
 Bearings are referenced to the east line of Martin Street with the assumed bearing of North
 Survey ordered by:
 Mikrut Realty
 199 Baldwin
 Sharon, WI 53585



STATE OF WISCONSIN)
COUNTY OF WALWORTH) SS

I, George T. Dunham, Surveyor, certify that I have surveyed the property described as follows:

A part of Lot 19 in Block 8, Citizens Addition to the Village of Sharon, Walworth County, Wisconsin, described as follows: Beginning at the northwest corner of said Lot 19; thence east along the north line of said lot, 176.00 feet; thence south parallel with the west line of said Lot 19, 90.00 feet; thence west parallel with the north line of said lot, 176.00 feet; thence north along the west line of said lot, 90.00 feet to the place of beginning.

and that the plat shown hereon is a correct representation thereof and shows the size and location of the property, its exterior boundaries, the location of all visible structures and dimensions of all principal buildings thereon, boundary fences, apparent easements, roadways and visible encroachments, if any, and that I have surveyed the property hereon described, according to the official records, to the best of my knowledge and belief.
October 2, 1989

George T. Dunham
George T. Dunham, Surveyor

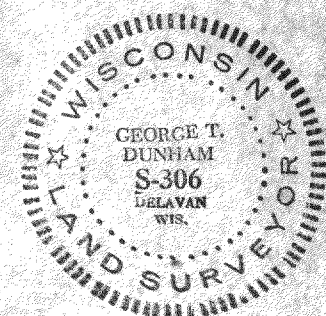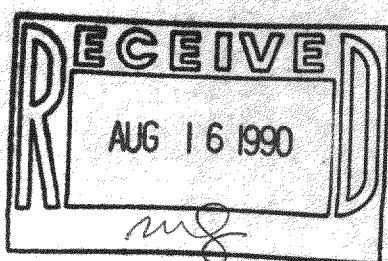

TAX KEY # UCA-00135

Survey # 008-160