


KOLB LAND CONSULTING, INC.
LAND SURVEYING • SUBDIVIDING • LAND PLANNING

LAKE GENEVA, WISCONSIN 53147


WHITEWATER, WISCONSIN 53190

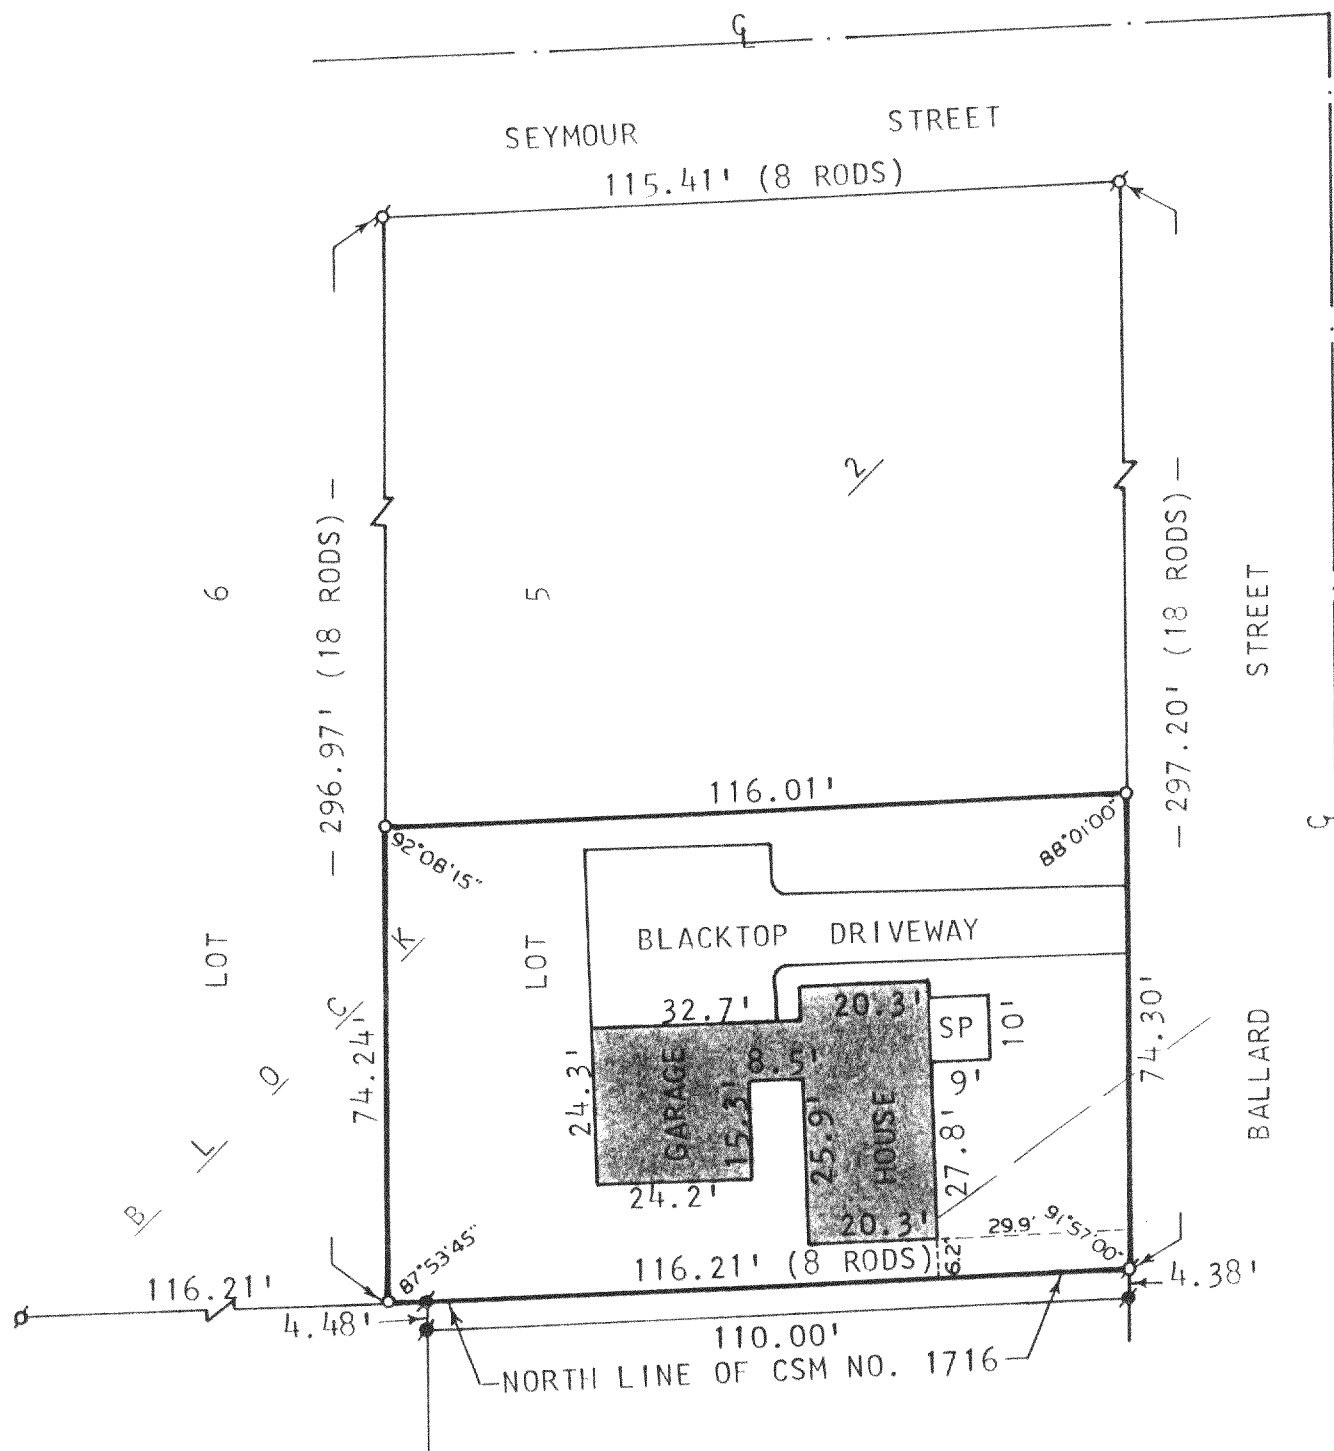

PLAT OF SURVEY OF

THE SOUTH 1/2 OF THE SOUTH 1/2 OF LOT 5, BLOCK 2, NELSON AND WISE SOUTH SIDE ADDITION, VILLAGE OF SHARON, WALWORTH COUNTY, WISCONSIN.


ORDERED BY: JOHN REYNOLDS & RUTH GOFF
BOX 207
SHARON, WI 53585

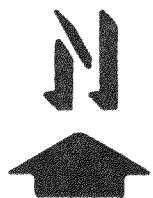

SCALE : 1" = 30'

LEGEND

- ⊙ - IRON PIPE FOUND
- - IRON PIPE SET
- - IRON ROD FOUND
- () - PLATTED AS
- SP - SCREEN PORCH
- - UTILITY LINE

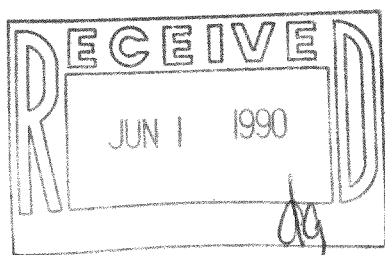

I HEREBY CERTIFY THAT I HAVE SURVEYED THE ABOVE DESCRIBED PROPERTY AND THAT THE ABOVE MAP IS A TRUE REPRESENTATION THEREOF AND SHOWS THE SIZE AND LOCATION OF THE PROPERTY, ITS EXTERIOR BOUNDARIES, THE LOCATION OF ALL VISIBLE STRUCTURES AND DIMENSIONS OF ALL PRINCIPAL BUILDINGS THEREON, BOUNDARY FENCES, APPARENT EASEMENTS, ROADWAYS AND VISIBLE ENCROACHMENTS, IF ANY, TO THE BEST OF MY KNOWLEDGE AND BELIEF.

THIS SURVEY IS MADE FOR THE USE OF THE PRESENT OWNERS OF THE PROPERTY, AND ALSO THOSE WHO PURCHASE, MORTGAGE, OR GUARANTEE THE TITLE THERETO WITHIN ONE (1) YEAR FROM DATE HEREOF.

SURVEY NOT VALID UNLESS SURVEYOR'S SIGNATURE IS IN RED.

HAROLD H. KOLB
WISCONSIN REGISTERED LAND SURVEYOR, S-137
DATE DECEMBER 4, 1989

008-173

UWDSS 00012