


DUNHAM SURVEYING, S. C.
 SURVEYING & SUBDIVIDING
 DELAVAN, WISCONSIN 53115

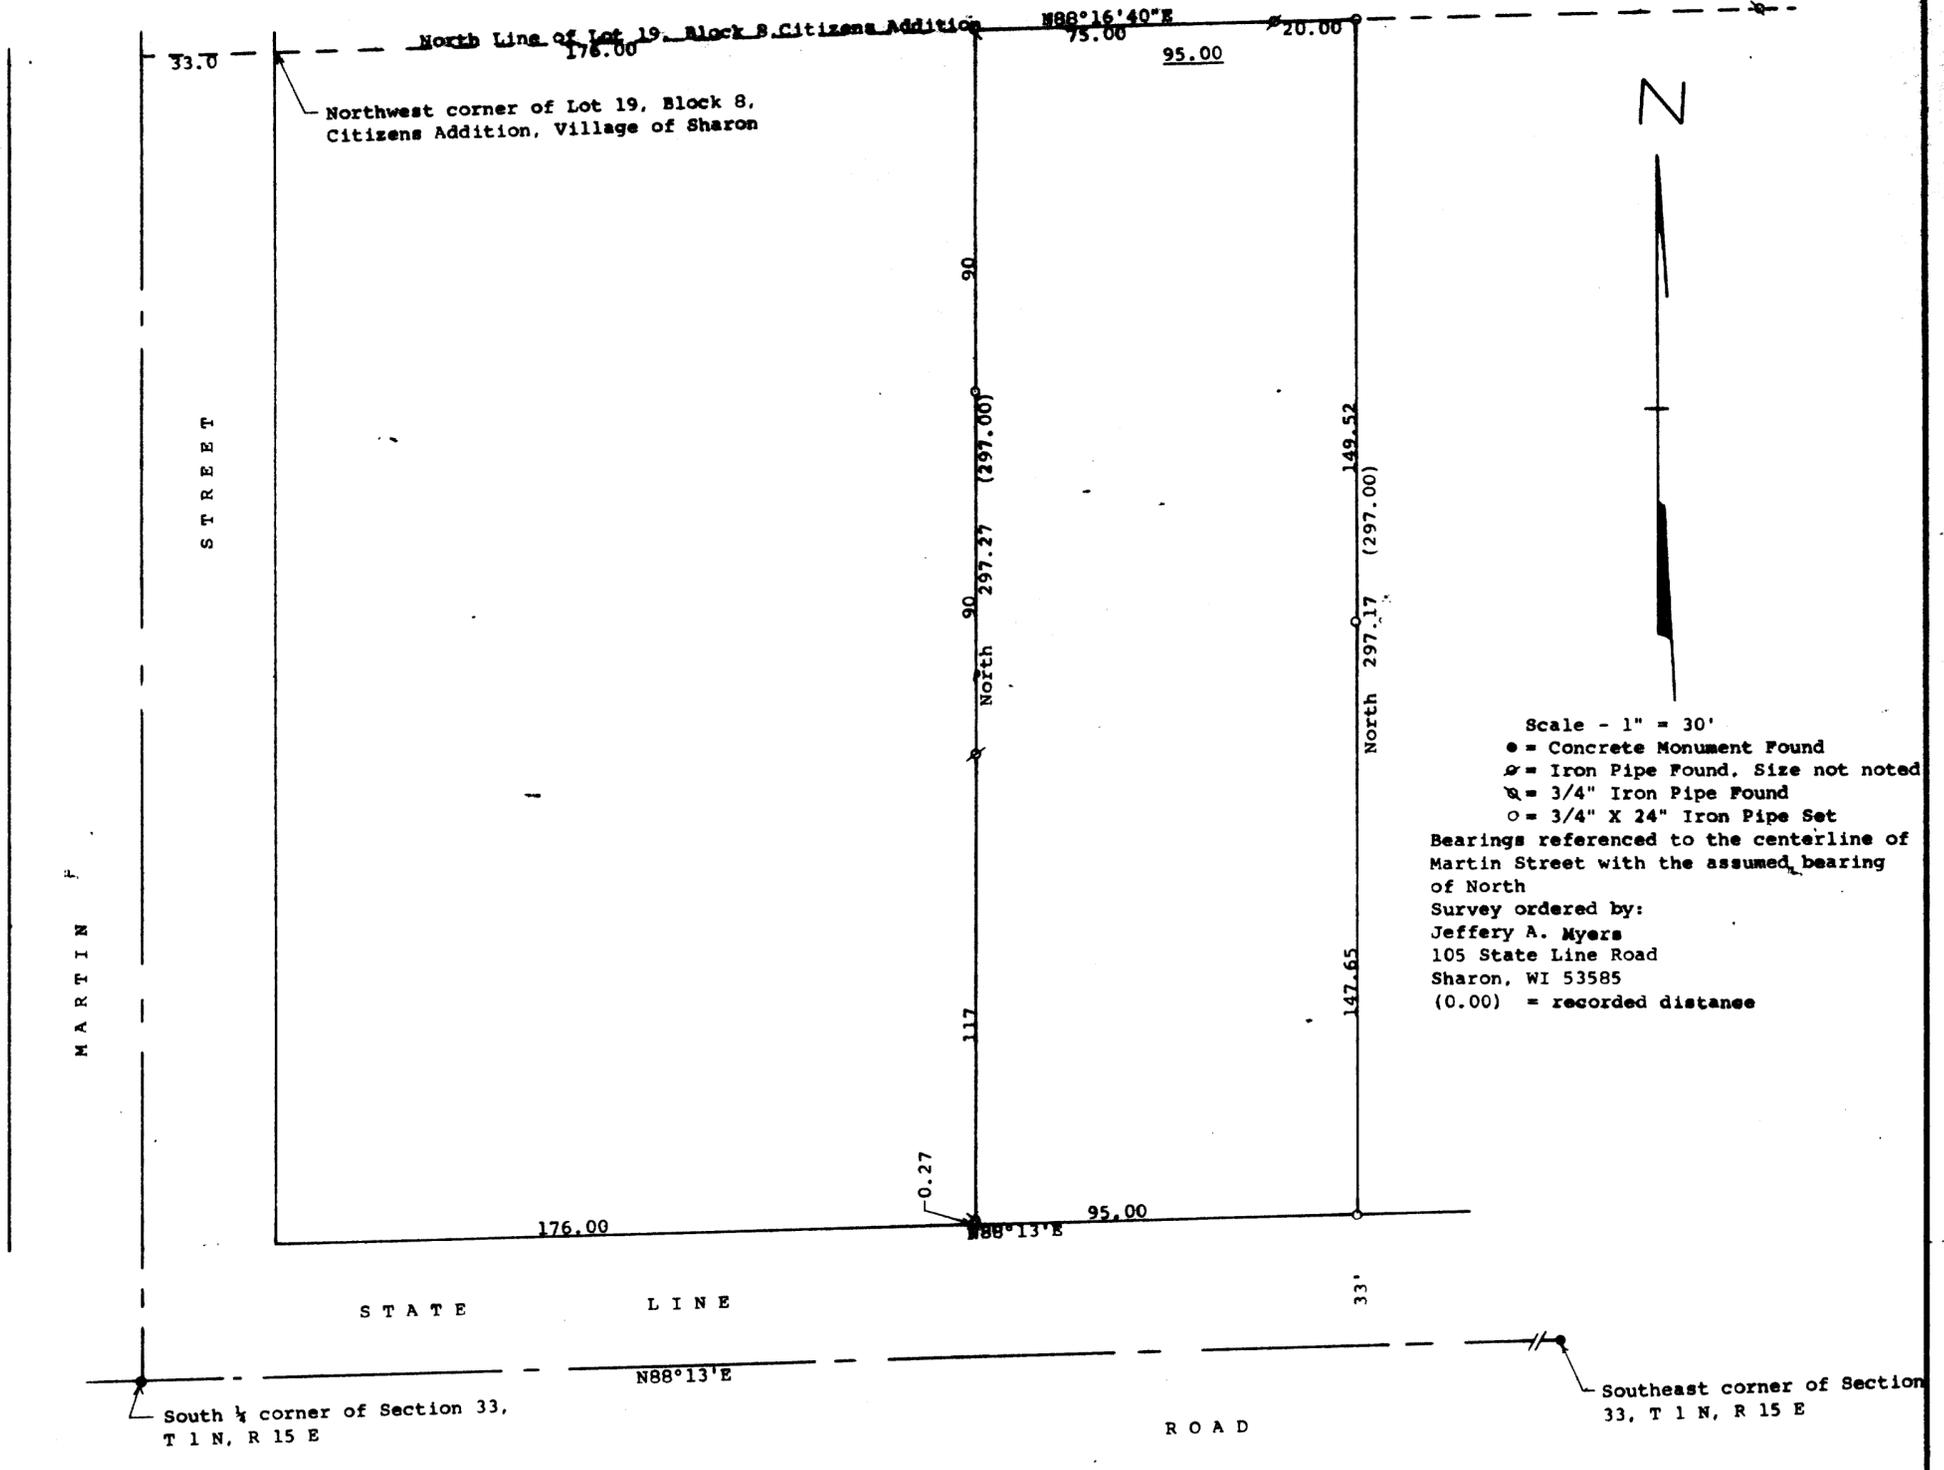

STATE OF WISCONSIN)SS
 COUNTY OF WALWORTH)

I, George T. Dunham, Surveyor, certify that I have surveyed the property described as follows:

A part of Lot 19 in Block 8, Citizens Addition to the Village of Sharon, Walworth County, Wisconsin, described as follows: Commencing at the northwest corner of said Lot 19; thence N88°16'40"E along the north line of said lot 176.00 feet to the place of beginning; thence continue N88°16'40"E along said north line 95.00 feet; thence South parallel with the centerline of Martin Street 297.17 feet to the south line of said Lot 19; thence S88°13'W 95.00 feet; thence North parallel with the centerline of Martin Street, 297.27 feet to the place of beginning, subject to easements of record.

and that the plat shown hereon is a correct representation thereof and shows the size and location of the property, its exterior boundaries, the location of all visible structures and dimensions of all principal buildings thereon, boundary fences, apparent easements, roadways and visible encroachments, if any, and that I have surveyed the property hereon described, according to the official records, to the best of my knowledge and belief.
 February 13, 1992

George T. Dunham
 George T. Dunham, Surveyor

