


DUNHAM SURVEYING, S.C.
SURVEYING & SUBDIVIDING
DELAVER, WISCONSIN 53115

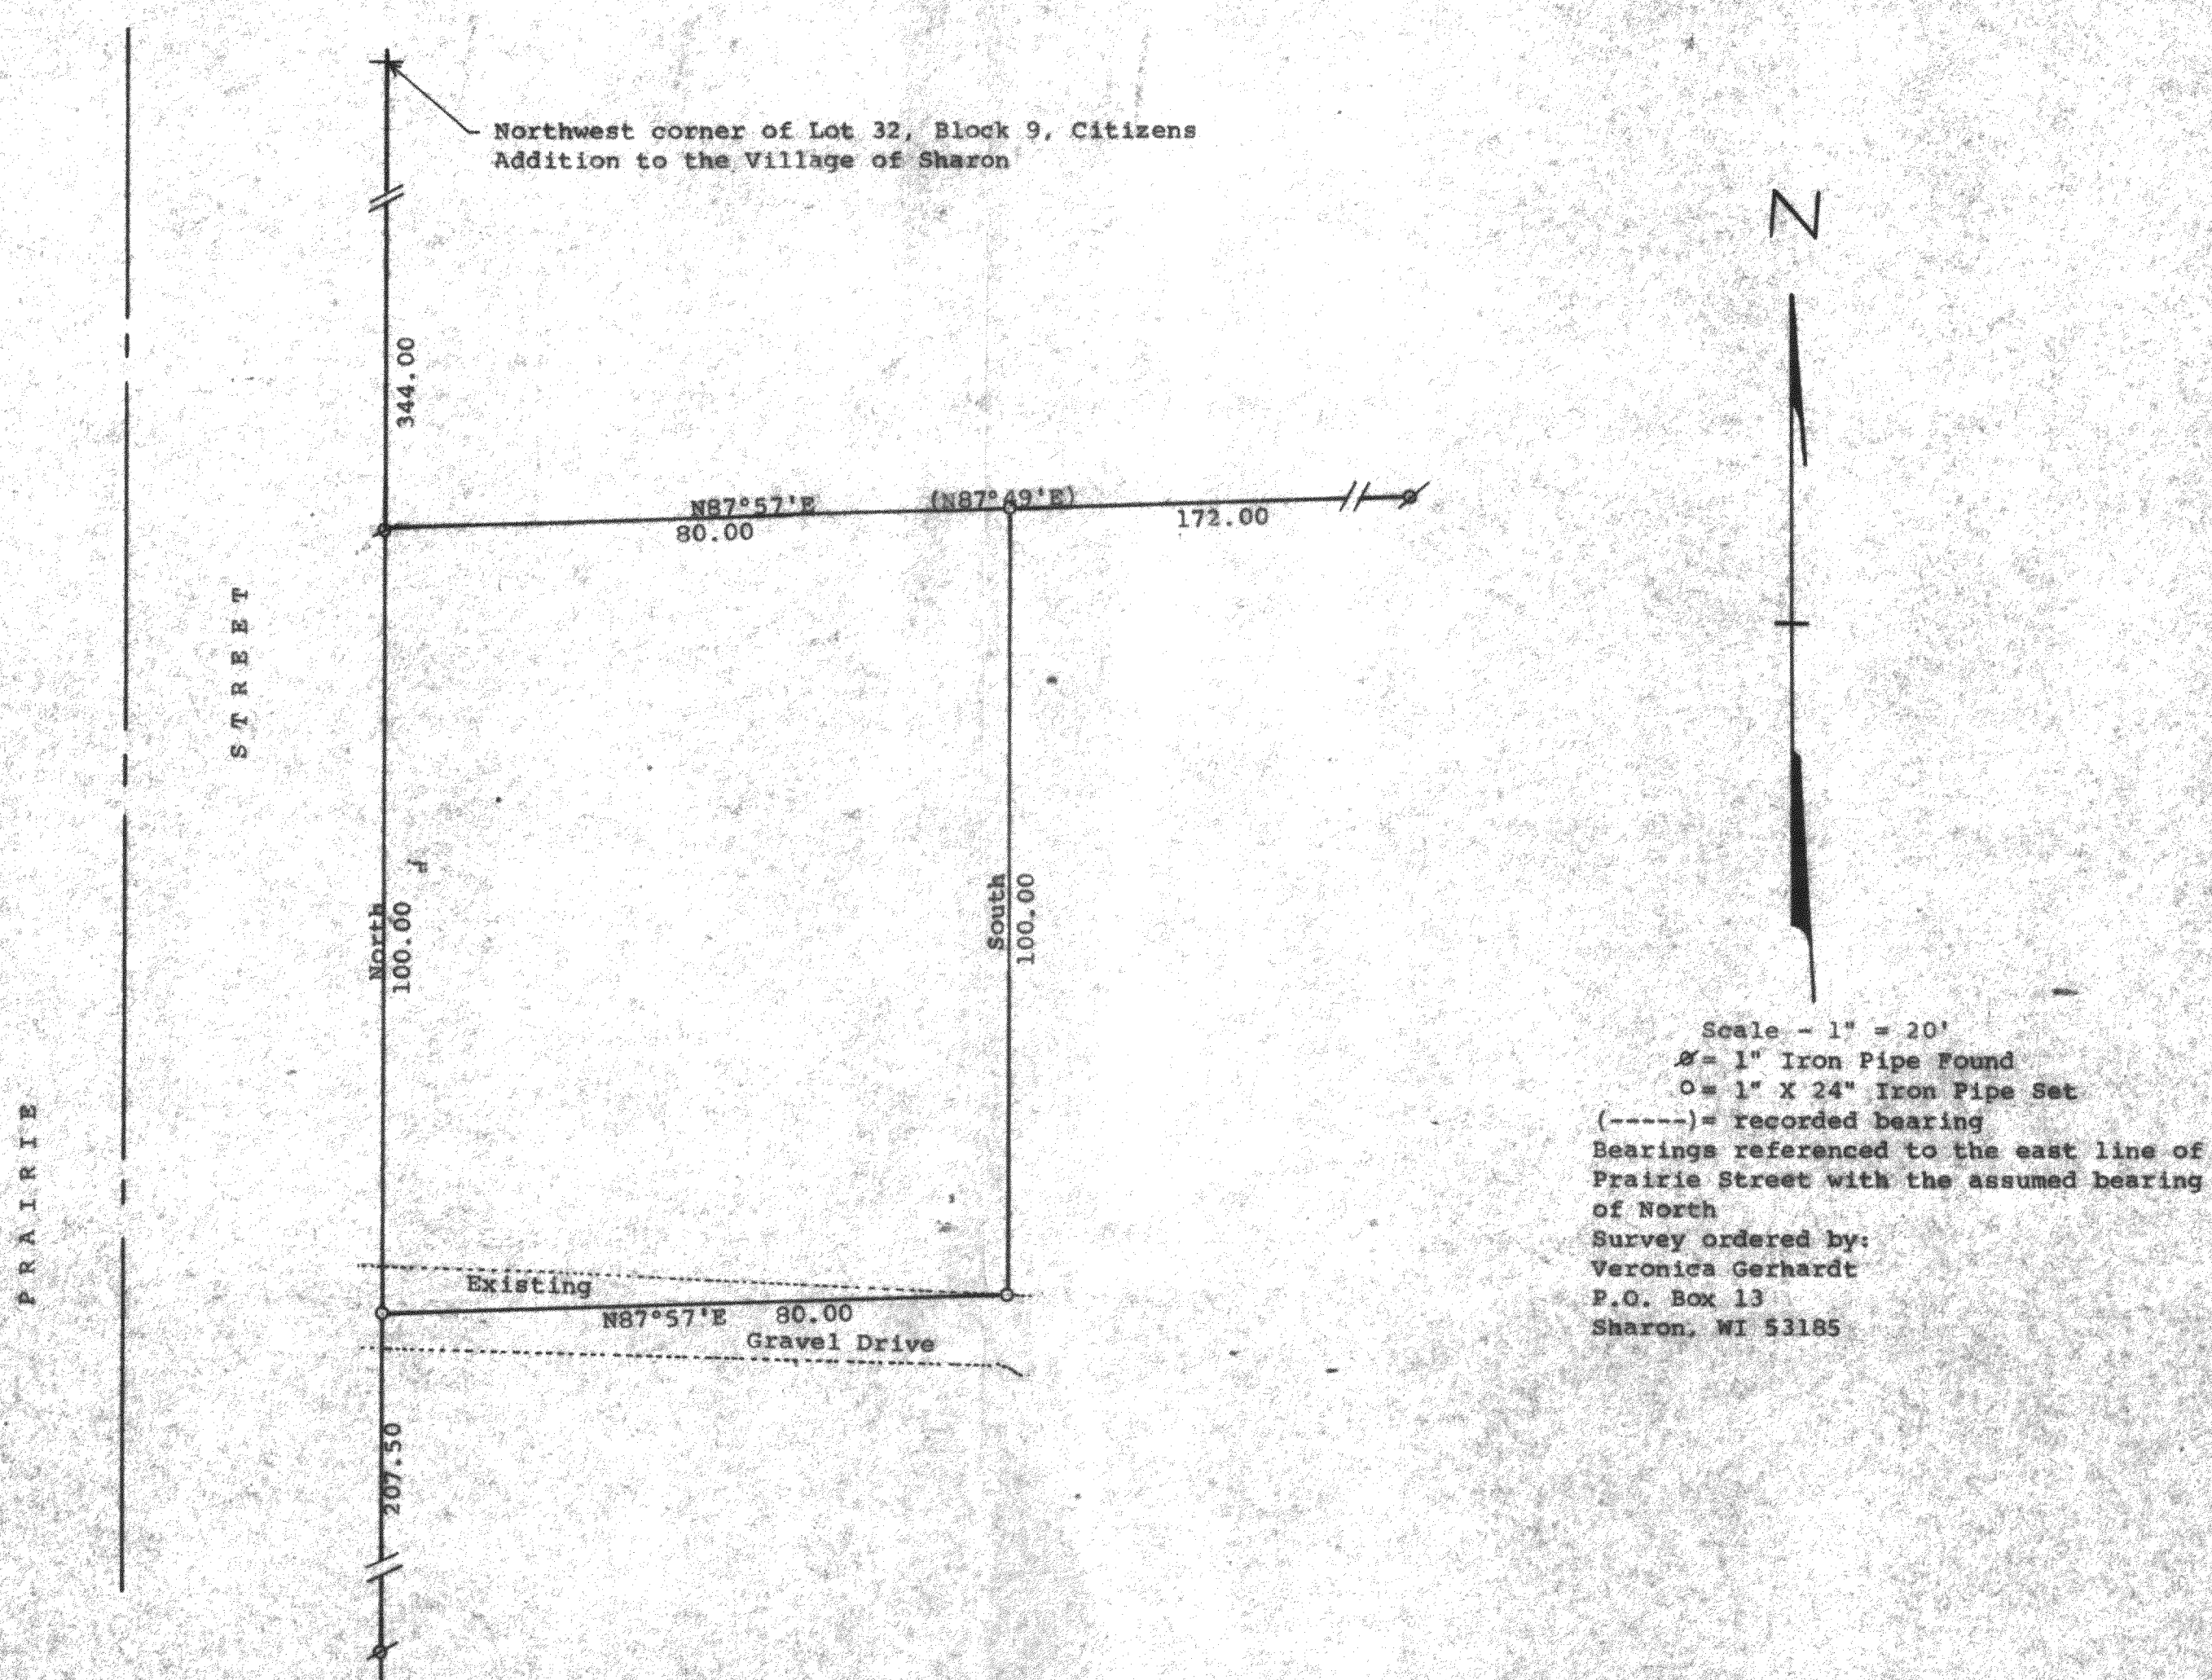

STATE OF WISCONSIN)
COUNTY OF WALWORTH) SS


I, George T. Dunham, Surveyor, certify that I have surveyed the property described as follows:

A parcel of land located in Lot 31, Block 9 of Citizens Addition to the Village of Sharon, Walworth County, Wisconsin, described as follows: Commencing at the Northwest corner of Lot 32 in said Block 9; thence South along the west line of said Lots 32 and 31, 344.00 feet to the place of beginning; thence N87°57'E (previously described as N87°49'E) parallel with the north line of said Lot 32, 80.00 feet; thence South parallel with the west line of said Lot 31, 100.00 feet; thence S87°57'W 80.00 feet to the east line of Prairie Street; thence North along the east line of Prairie Street, 100.00 feet to the place of beginning, containing 0.184 of an acre of land more or less.

and that the plat shown hereon is a correct representation thereof and shows the size and location of the property, its exterior boundaries, the location of all visible structures and dimensions of all principal buildings thereon, boundary fences, apparent easements, roadways and visible encroachments, if any, and that I have surveyed the property hereon described, according to the official records, to the best of my knowledge and belief.

October 27, 1992

George T. Dunham
George T. Dunham, Surveyor

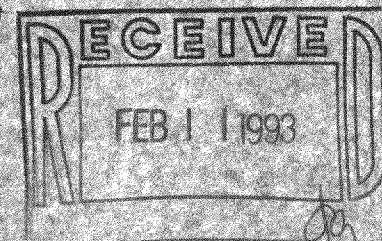

UCA-172B1

048-222