


815 648-2715

DESCRIPTION SUPPLIED:

THE SOUTH 82.5' OF LOT 28 BLOCK 9
IN CITIZENS ADDITION TO THE VILLAGE OF SHARON
IN PART OF SECTION 33, TOWN 1 NORTH, RANGE 15 EAST
OF THE FOURTH PRINCIPAL MERIDIAN, IN WALWORTH COUNTY, WISCONSIN.

WANAGAS SURVEYING
P.O. BOX 572 HEBRON ILLINOIS 60034
PLAT OF SURVEY

WORK ORDER NO. 921106
SHEET 1 OF 1
SCALE 1" = 20'
(EXCEPT AS NOTED)

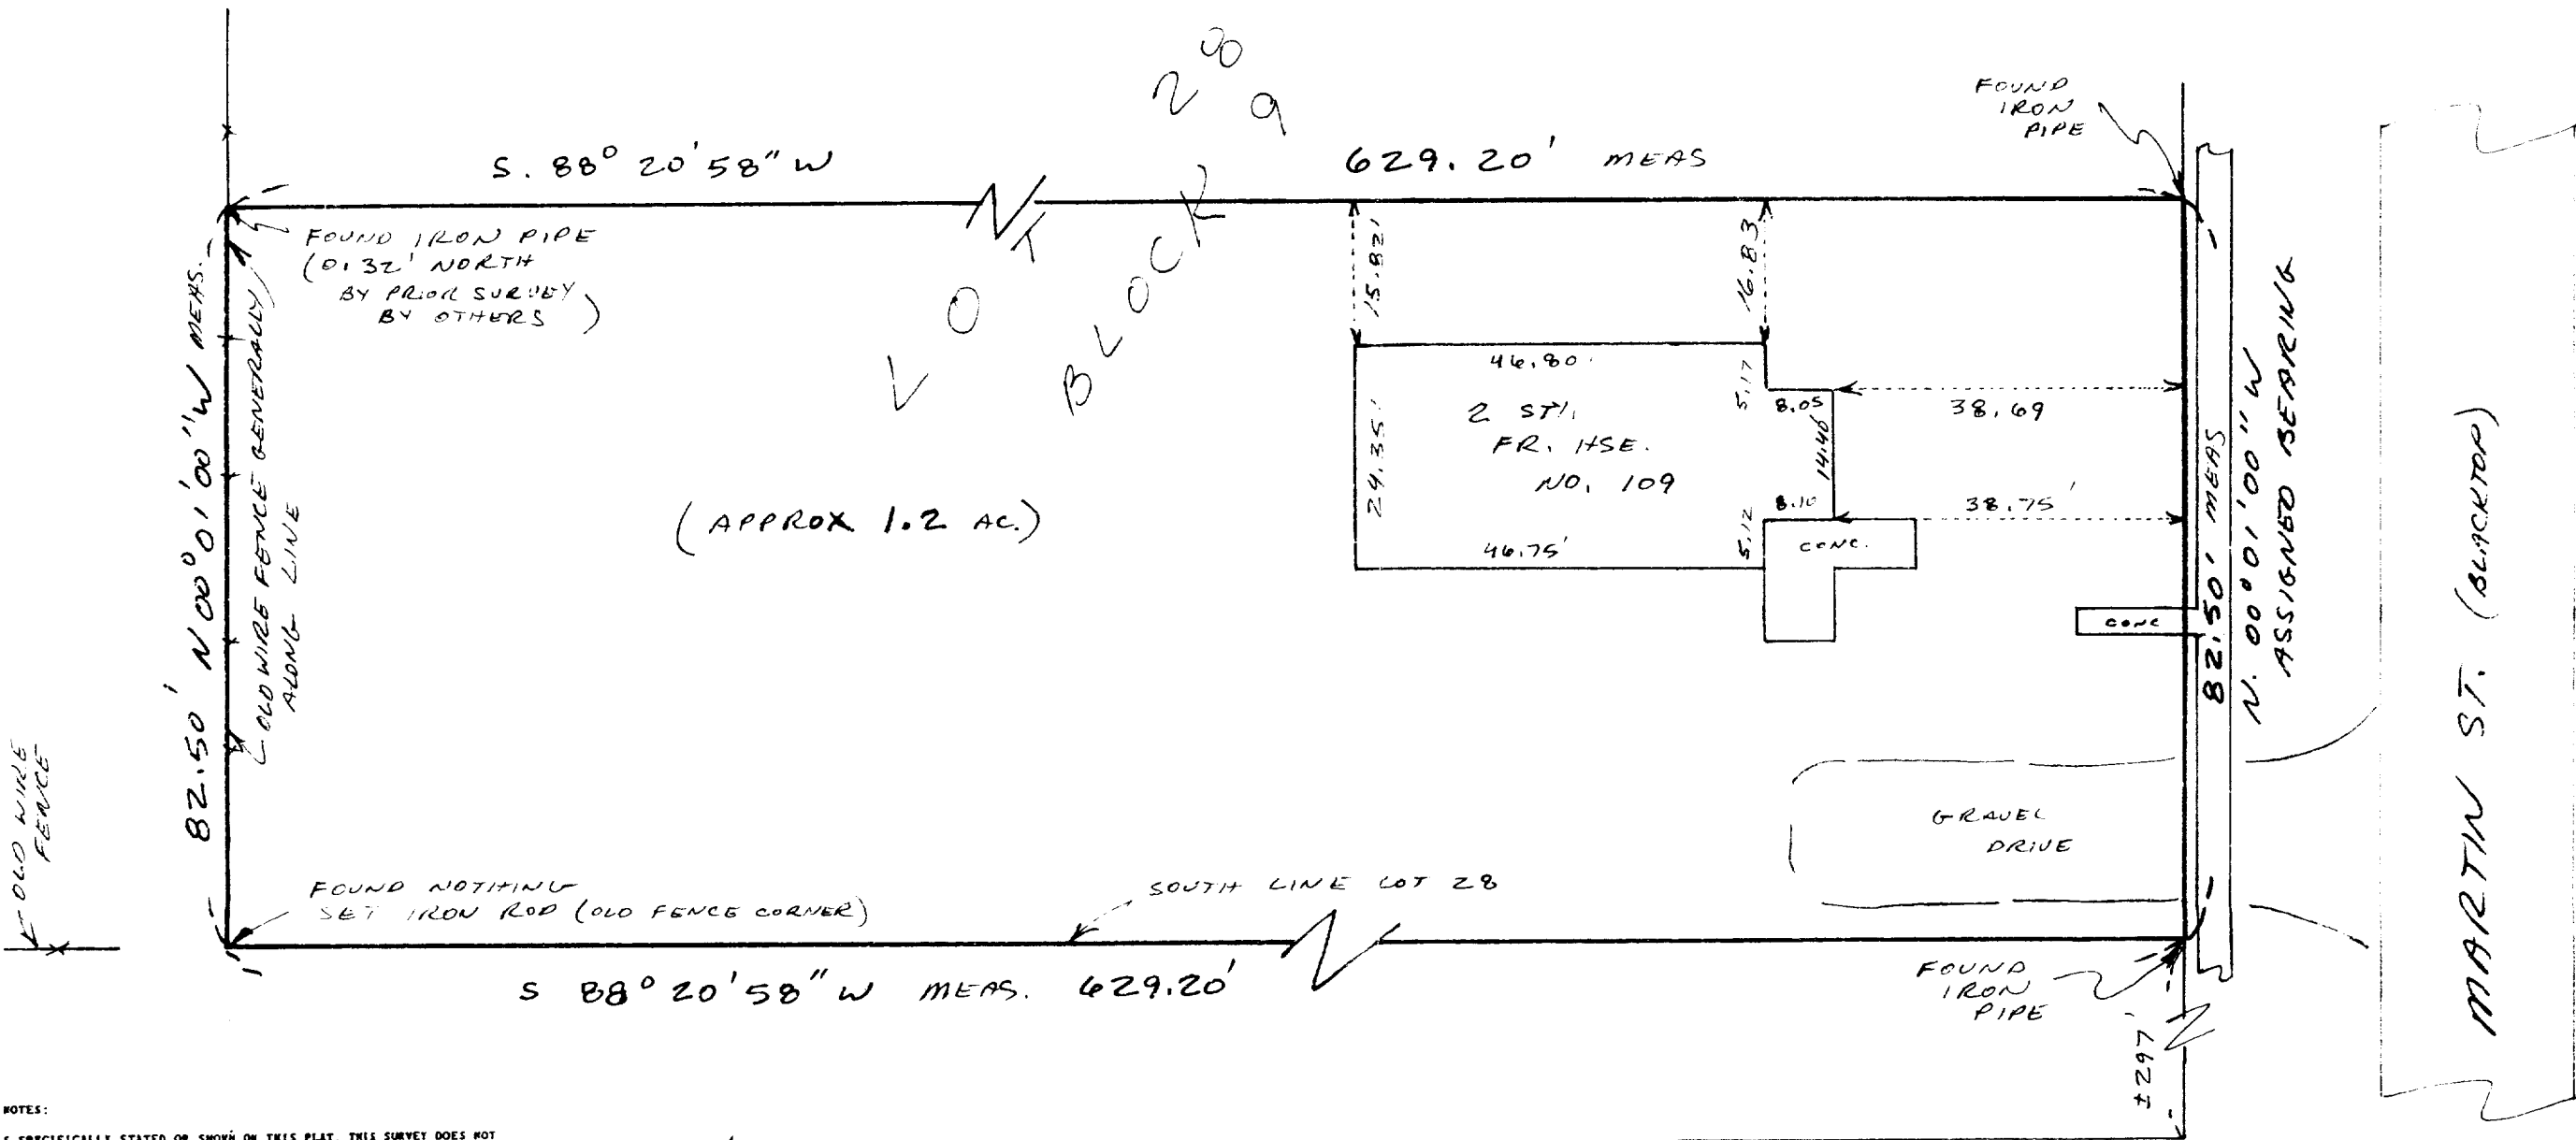

SURVEYOR'S NOTES:
EXCEPT AS SPECIFICALLY STATED OR SHOWN ON THIS PLAT, THIS SURVEY DOES NOT PURPORT TO REFLECT ANY OF THE FOLLOWING WHICH MAY BE APPLICABLE TO THE SUBJECT PROPERTY: EASEMENTS OTHER THAN POSSIBLE EASEMENTS WHICH WERE READILY VISIBLE AT THE TIME THE SURVEY WAS MADE; BUILDING SETBACK LINES; RESTRICTIVE COVENANTS; SUBDIVISION RESTRICTIONS; ZONING OR OTHER LAND USE REGULATIONS, AND ANY OTHER FACTS WHICH AN ACCURATE AND CURRENT TITLE SEARCH MAY DISCLOSE.
SURVEY IS VALID ONLY IF PRINT HAS EMBOSSED SEAL ON IT.
NO STATEMENT IS MADE CONCERNING SUBSURFACE CONDITIONS, OR THE EXISTENCE OF UNDERGROUND OR OVERHEAD CONTAINERS OR FACILITIES WHICH MAY AFFECT THE USE OR DEVELOPMENT OF THIS TRACT.
THE DOCUMENTS OF RECORD WHICH WERE REVIEWED AND CONSIDERED AS PART OF THIS SURVEY ARE NOTED HEREON. ONLY DOCUMENTS NOTED HEREON WERE SUPPLIED TO THE SURVEYOR.
ON RECEIPT OF THIS SURVEY AND YOUR INSPECTION OF THE SURVEY MARKERS, REPORT ANY APPARENT DISCREPANCY TO THE SURVEYOR IMMEDIATELY.

INDICATES NOT TO SCALE


STATE LINE RD.

STATE OF ILLINOIS
COUNTY OF MCHEERY

I HEREBY STATE THAT I HAVE SURVEYED THE PROPERTY DESCRIBED HEREON AS SHOWN AND NOTED ON THE PLAT HEREON DRAWN.

DATE 11-19-92
Ken Wanagas

KENNETH B. WANAGAS
PROFESSIONAL LAND SURVEYOR
ILLINOIS NO. 2432 WISCONSIN NO. 1420

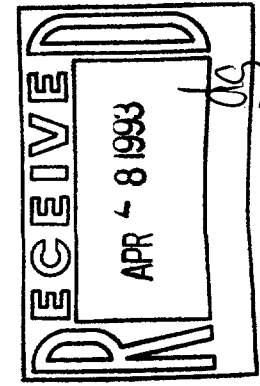

8-224

CA-169A