

KOLB LAND CONSULTING, INC.
LAND SURVEYING • SUBDIVIDING • LAND PLANNING


929 WILLIAMS STREET LAKE GENEVA, WISCONSIN 53147 414 248-3697

ORDERED BY: SHIRLEY ANDREWS
117 GRACE STREET
SHARON, WI. 53585

BLOCK

PLAT OF SURVEY OF

LOTS 8 AND 9, BLOCK 1 OF
HOARDS ADDITION LOCATED
IN THE VILLAGE OF SHARON,
WALWORTH COUNTY, WISCONSIN.

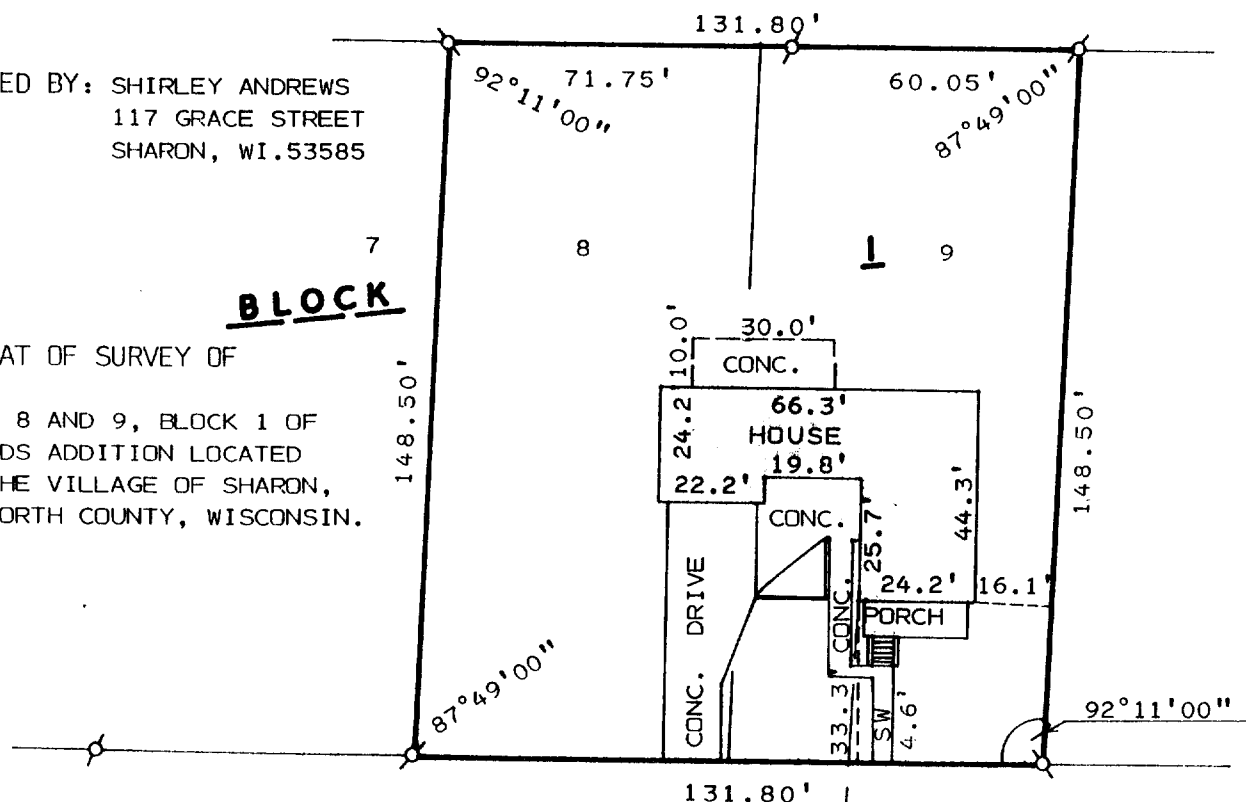

GRACE STREET 66' WIDE

PROSPECT STREET
66' WIDE


LEGEND

- Ø - IRON PIPE FOUND
- - OVERHEAD UTILITY LINE
- SW - SIDEWALK

I HEREBY CERTIFY THAT I HAVE SURVEYED THE ABOVE DESCRIBED PROPERTY AND THAT THE ABOVE MAP IS A TRUE REPRESENTATION THEREOF AND SHOWS THE SIZE AND LOCATION OF THE PROPERTY, ITS EXTERIOR BOUNDARIES, THE LOCATION OF ALL VISIBLE STRUCTURES AND DIMENSIONS OF ALL PRINCIPAL BUILDINGS THEREON, BOUNDARY FENCES, APPARENT EASEMENTS, ROADWAYS AND VISIBLE ENCROACHMENTS, IF ANY, TO THE BEST OF MY KNOWLEDGE AND BELIEF.

THIS SURVEY IS MADE FOR THE USE OF THE PRESENT OWNERS OF THE PROPERTY AND ALSO THOSE WHO PURCHASE, MORTGAGE OR GUARANTEE THE TITLE THERETO WITHIN ONE (1) YEAR FROM DATE HEREOF. SURVEY NOT VALID UNLESS SURVEYOR'S SIGNATURE IS IN RED.

SCALE: 1" = 40'

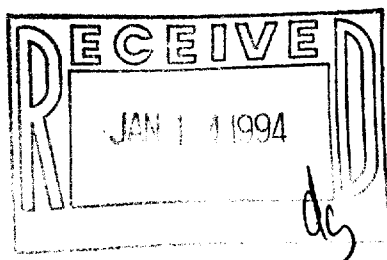

HAROLD H. KOLB

WISCONSIN REGISTERED LAND SURVEYOR, S. 187

DATE APRIL 23, 1993

REVISED _____

REVISED _____