


GEORGE T. DUNHAM
SURVEYING & SUBDIVIDING
DELAVER, WISCONSIN

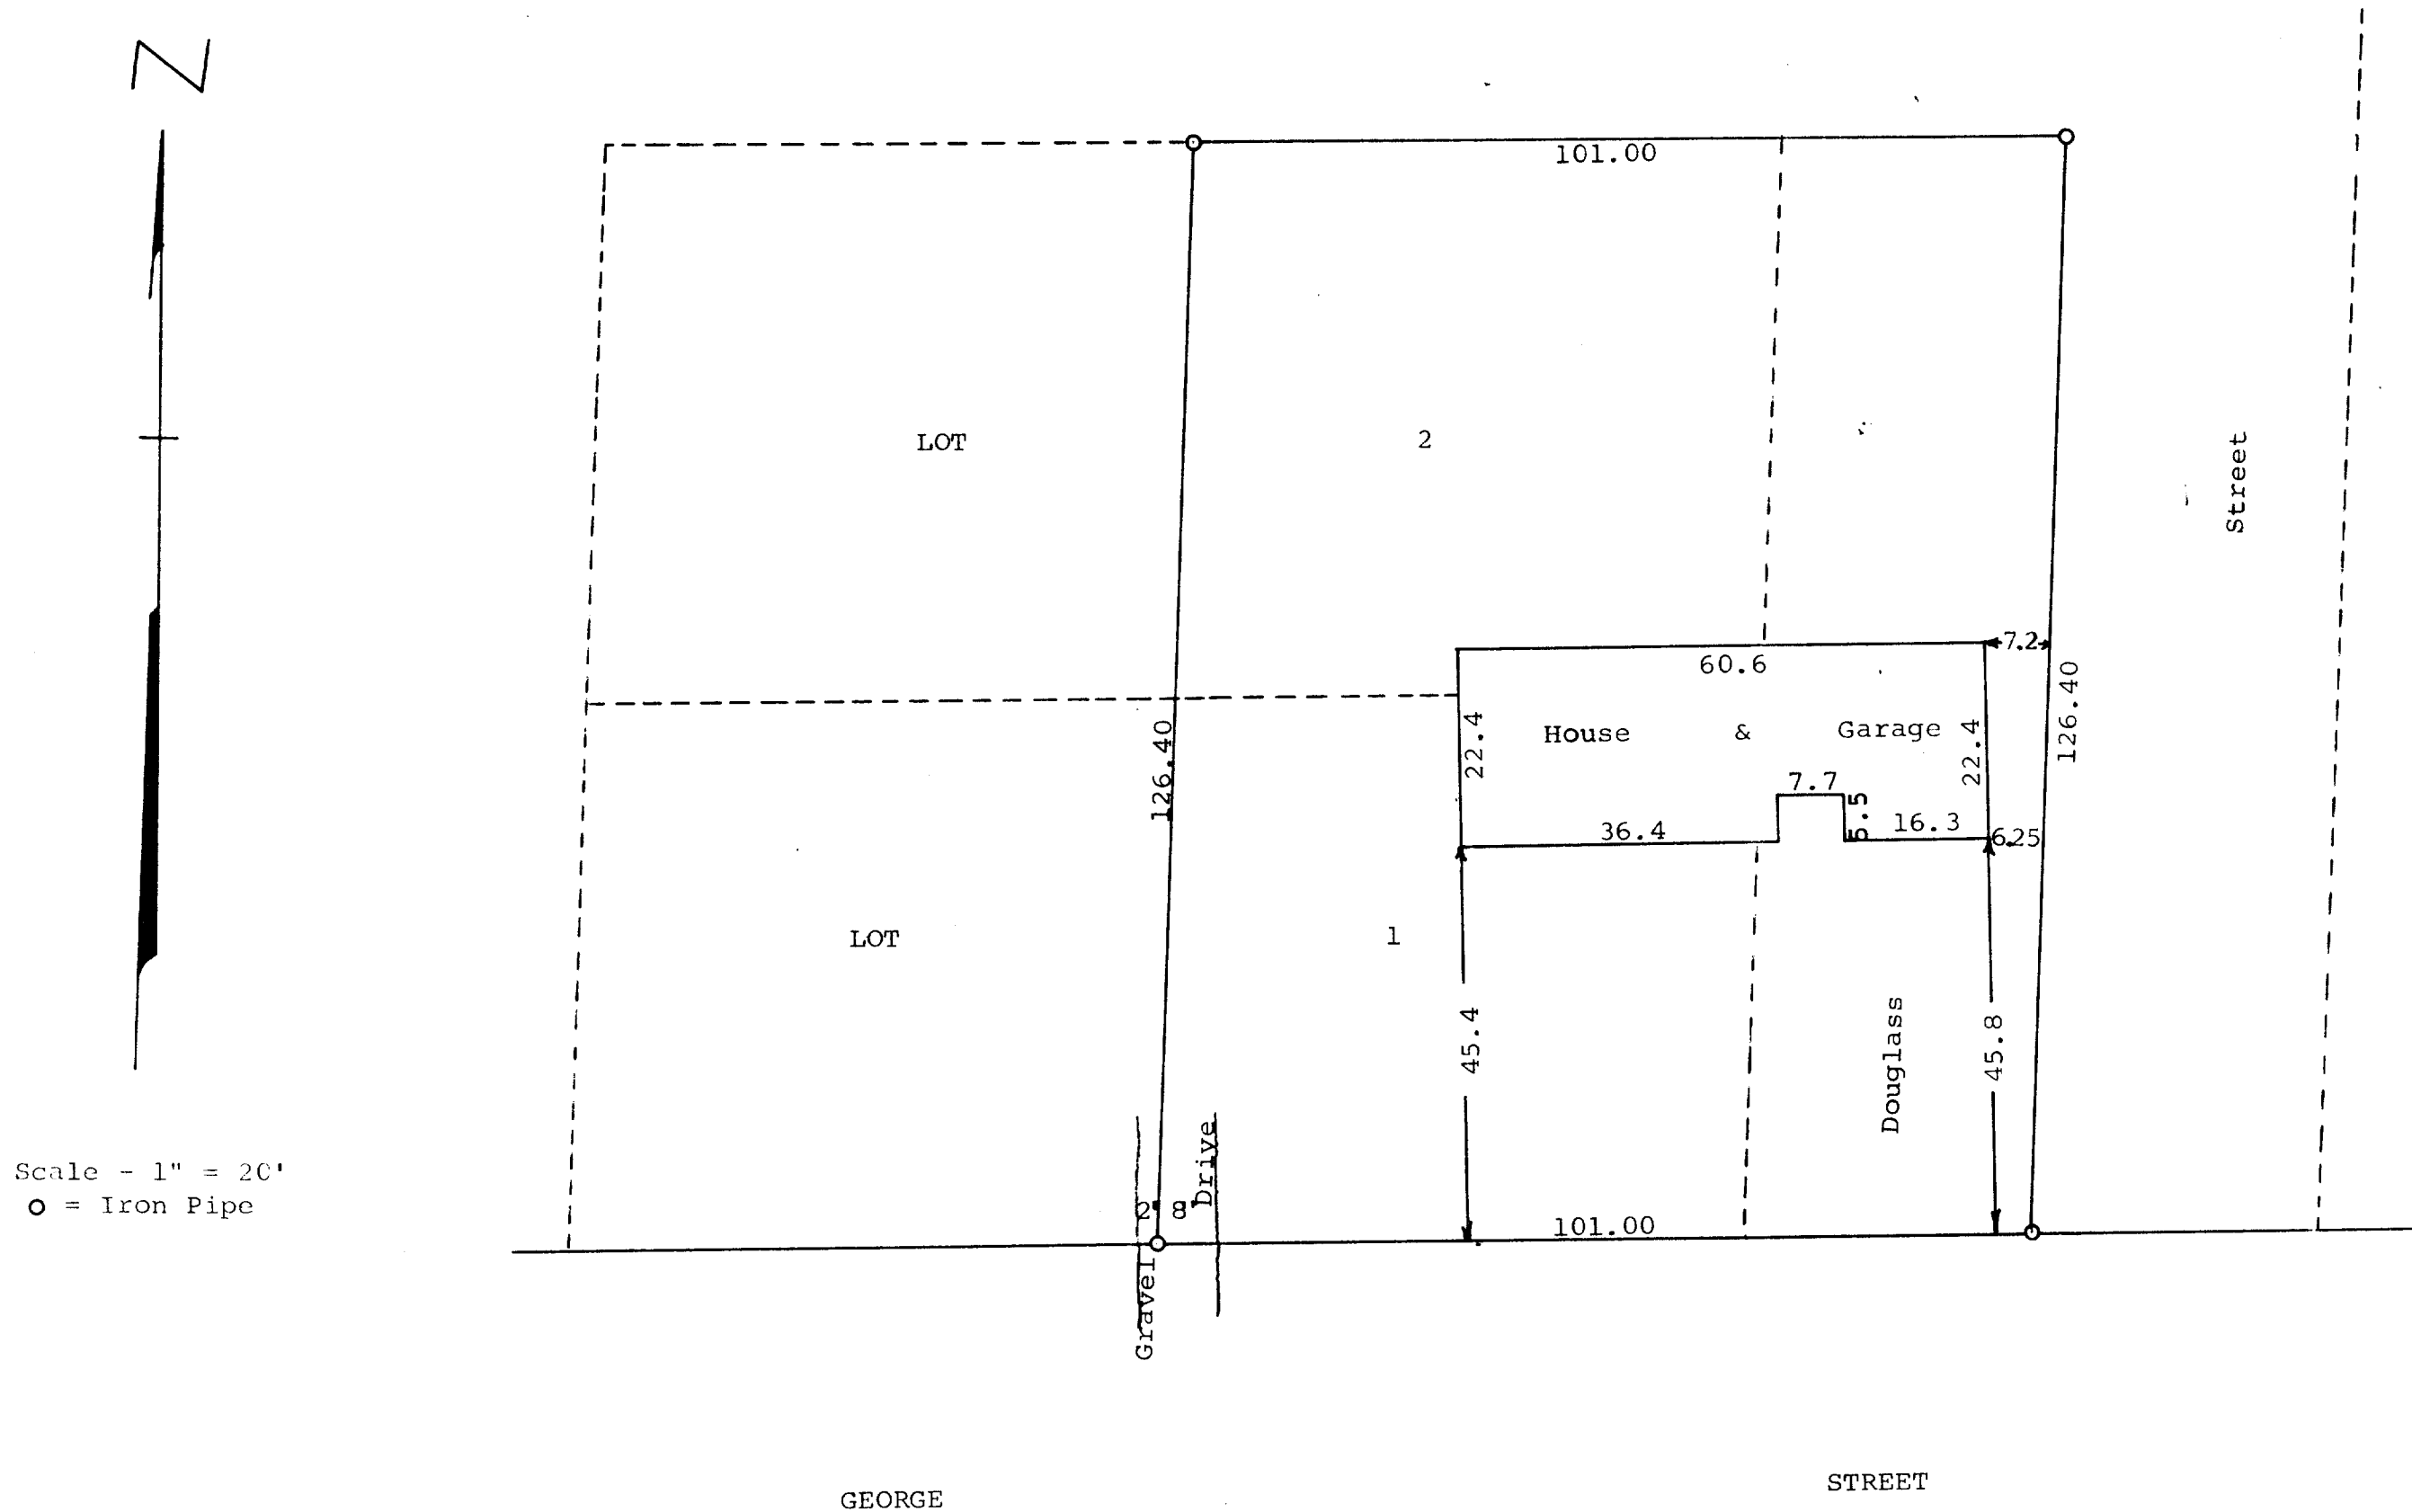

STATE OF WISCONSIN) ss
WALWORTH COUNTY)

I, George T. Dunham, Surveyor, certify that I have surveyed the property described as follows,

The East $\frac{1}{2}$ of Lot 1, the East $\frac{1}{2}$ of Lot 2, Block 4 and the West $\frac{1}{2}$ of Douglass Street all in Brighams Addition to the Village of Sharon, Walworth County, Wisconsin.

and the above plat is an accurate survey and a true representation thereof and correctly shows the exterior boundary lines and location of buildings on said property and the correct measurements thereof.
November 20, 1968

George T. Dunham
George T. Dunham, Surveyor

8-24B

UBA-14