


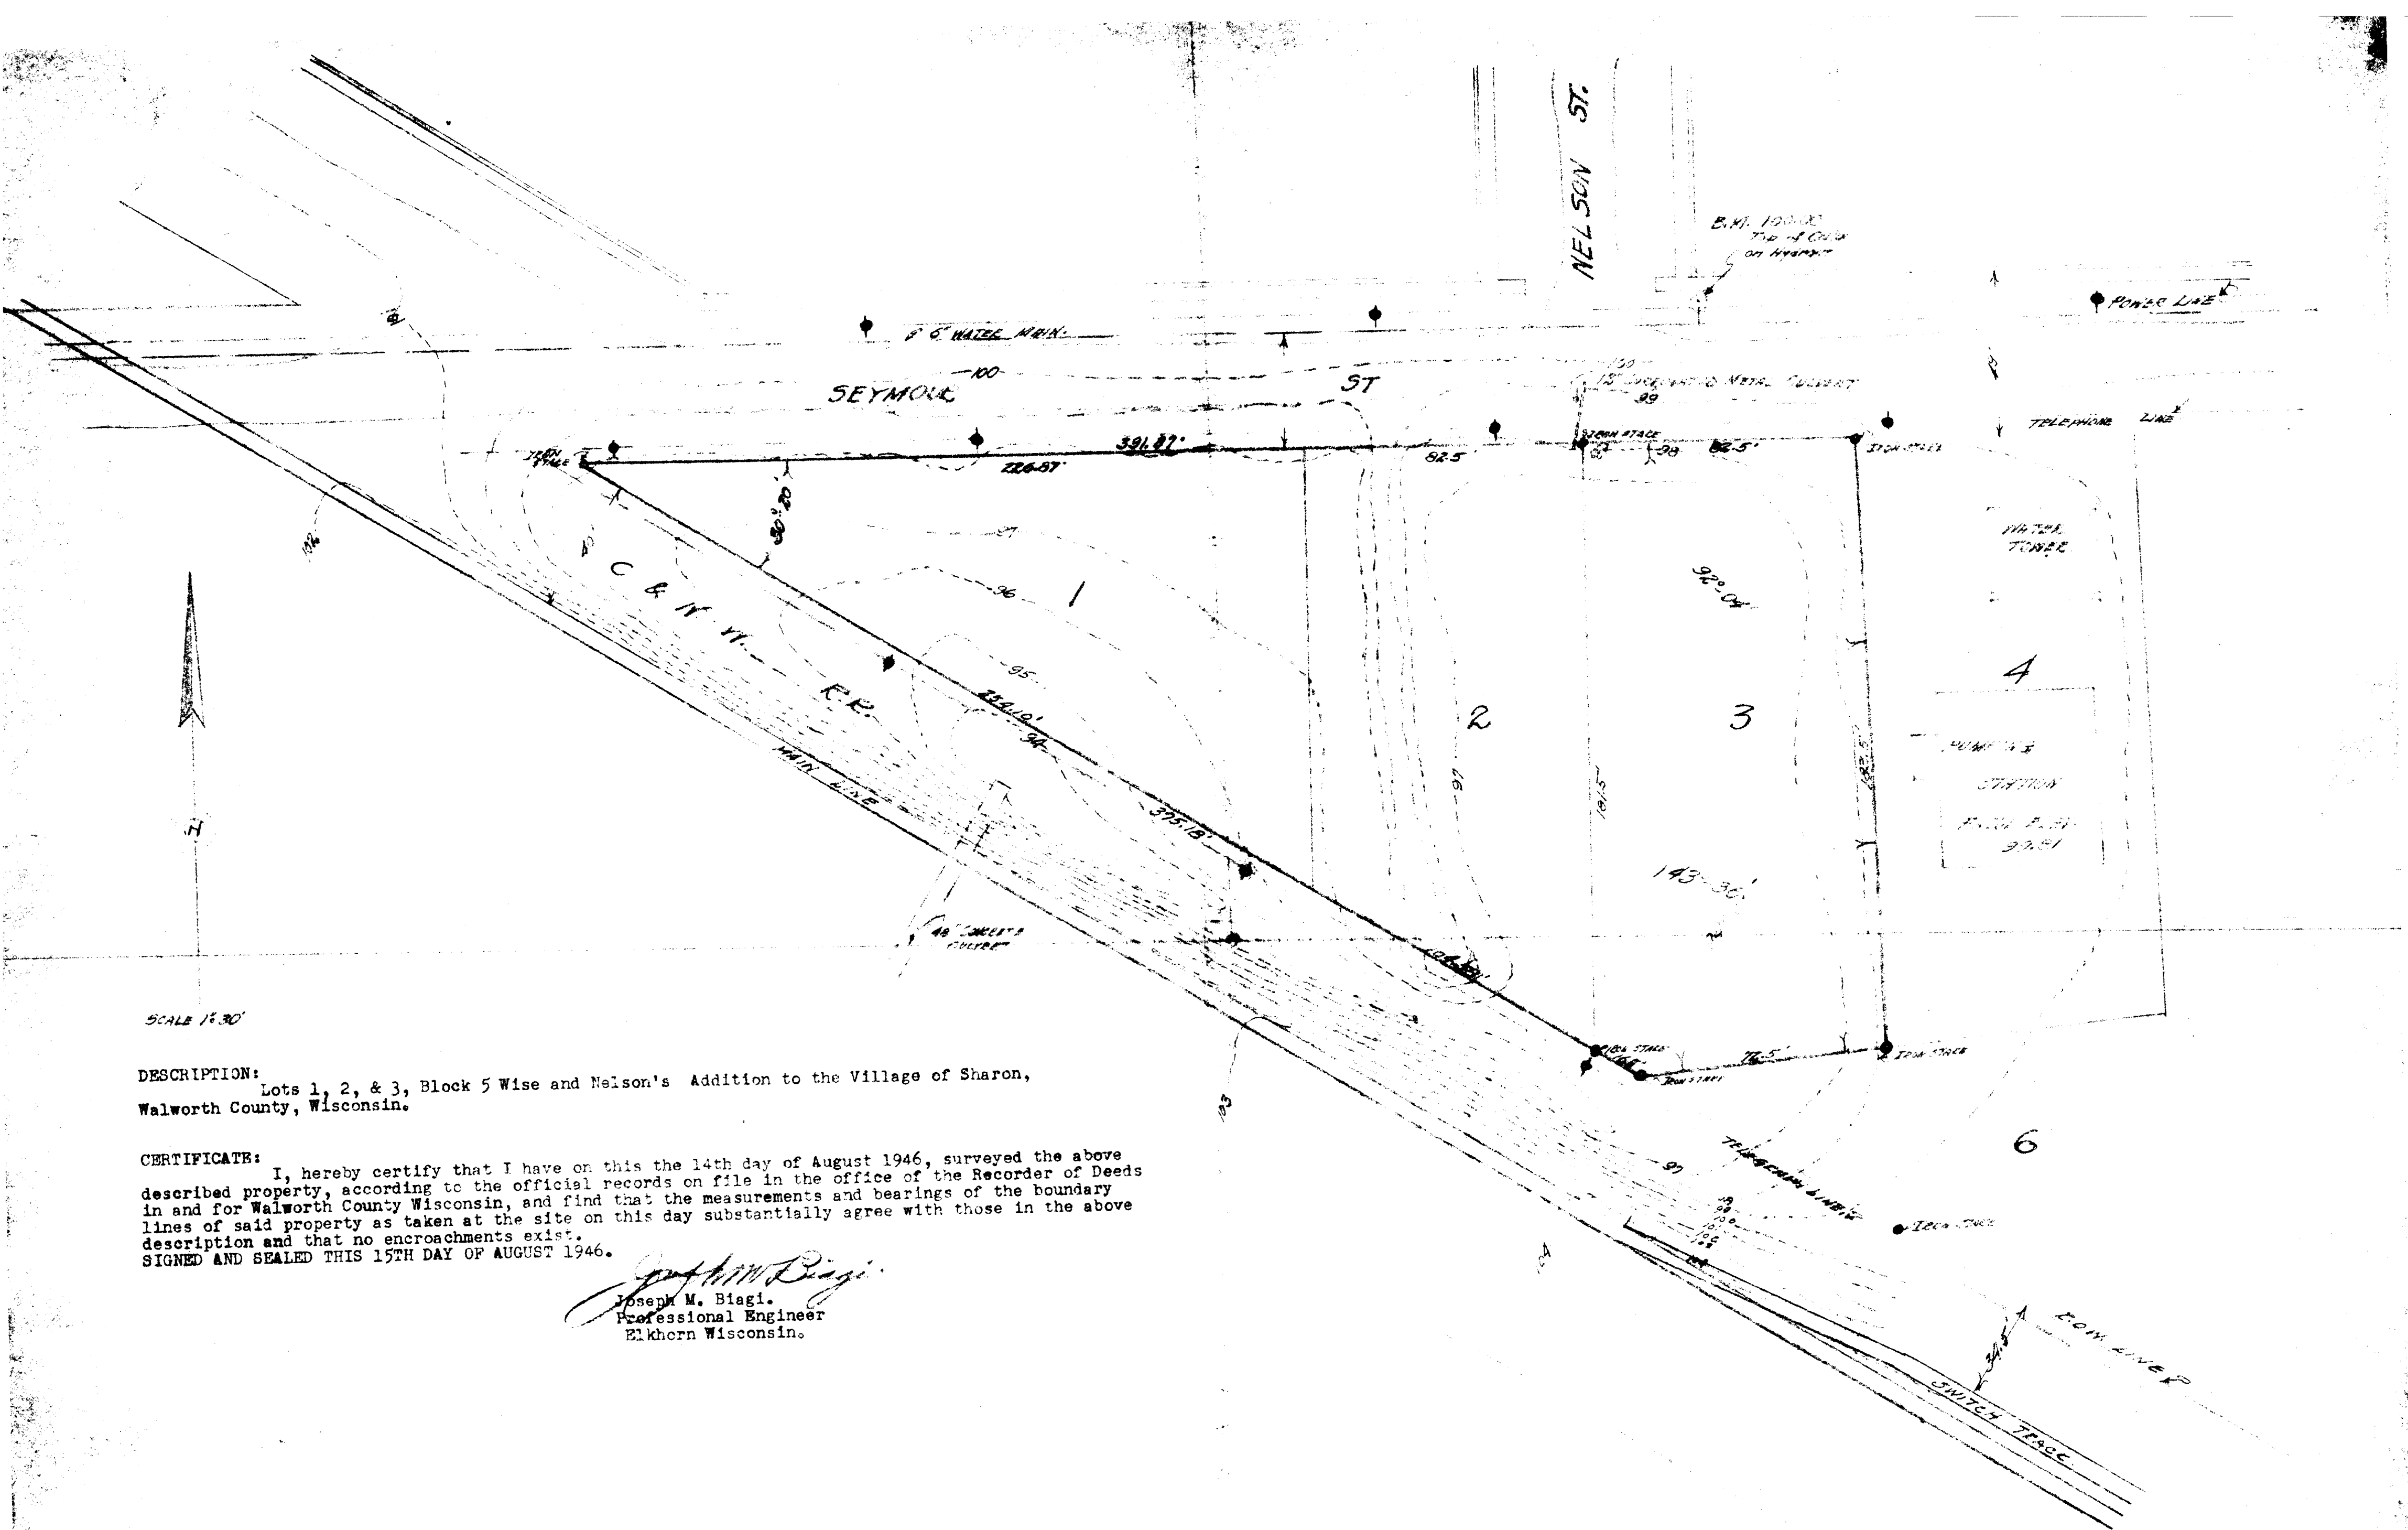

SCALE 1"=30'

DESCRIPTION: Lots 1, 2, & 3, Block 5 Wise and Nelson's Addition to the Village of Sharon, Walworth County, Wisconsin.


CERTIFICATE: I, hereby certify that I have on this the 14th day of August 1946, surveyed the above described property, according to the official records on file in the office of the Recorder of Deeds in and for Walworth County Wisconsin, and find that the measurements and bearings of the boundary lines of said property as taken at the site on this day substantially agree with those in the above description and that no encroachments exist.
SIGNED AND SEALED THIS 15TH DAY OF AUGUST 1946.

Joseph M. Biagi.
Professional Engineer
Elkhorn Wisconsin.

PLAT OF SURVEY AND TOPOGRAPHIC MAP
PROPOSED FACTORY SITE
SHARON WISCONSIN.

BY: Joseph M. Biagi.
Consulting Engineer
Elkhorn Wisconsin.

8-2513

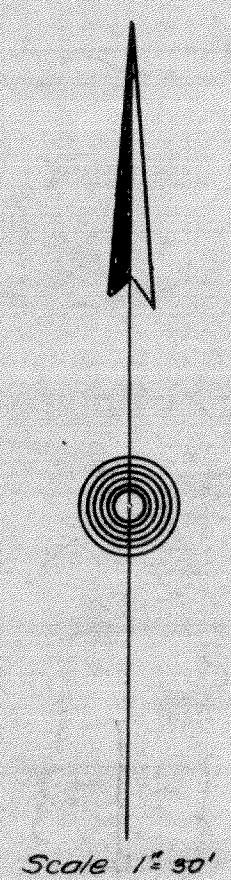

DESCRIPTION: Lots 1 and 2, Block 5, Wise and Nelson's Addition to the Village of Sharon, Walworth County, Wisconsin.

CERTIFICATE: I, hereby certify that I, have surveyed the above described property on this the 29th day of July 1946., according to the official records on file in the office of the Recorder of Deeds in and for Walworth County, Wisconsin, and find that the measurements and bearings of the boundary lines of said property as taken at the site on this day substantially agree with those in the above description and that no encroachments exist.

SIGNED AND SEALED THIS 1ST DAY OF AUGUST 1946.

Joseph M. Biagi
Joseph M. Biagi.
Consulting Engineer
Elkhorn Wisconsin.

SHOW ELEV. & EXACT
LOCATION OF PRES. SIDETRACK
TO TRAIL LINE & LOT LINE

PLAT OF SURVEY AND TOPOGRAPHIC MAP
PROPOSED FACTORY SITE
SHARON WISCONSIN.

By. Joseph M. Biagi.
Consulting Engineer
Elkhorn and Milwaukee

