


DUNHAM SURVEYING, S.C.
SURVEYING & SUBDIVIDING
DELAVER, WISCONSIN 53115

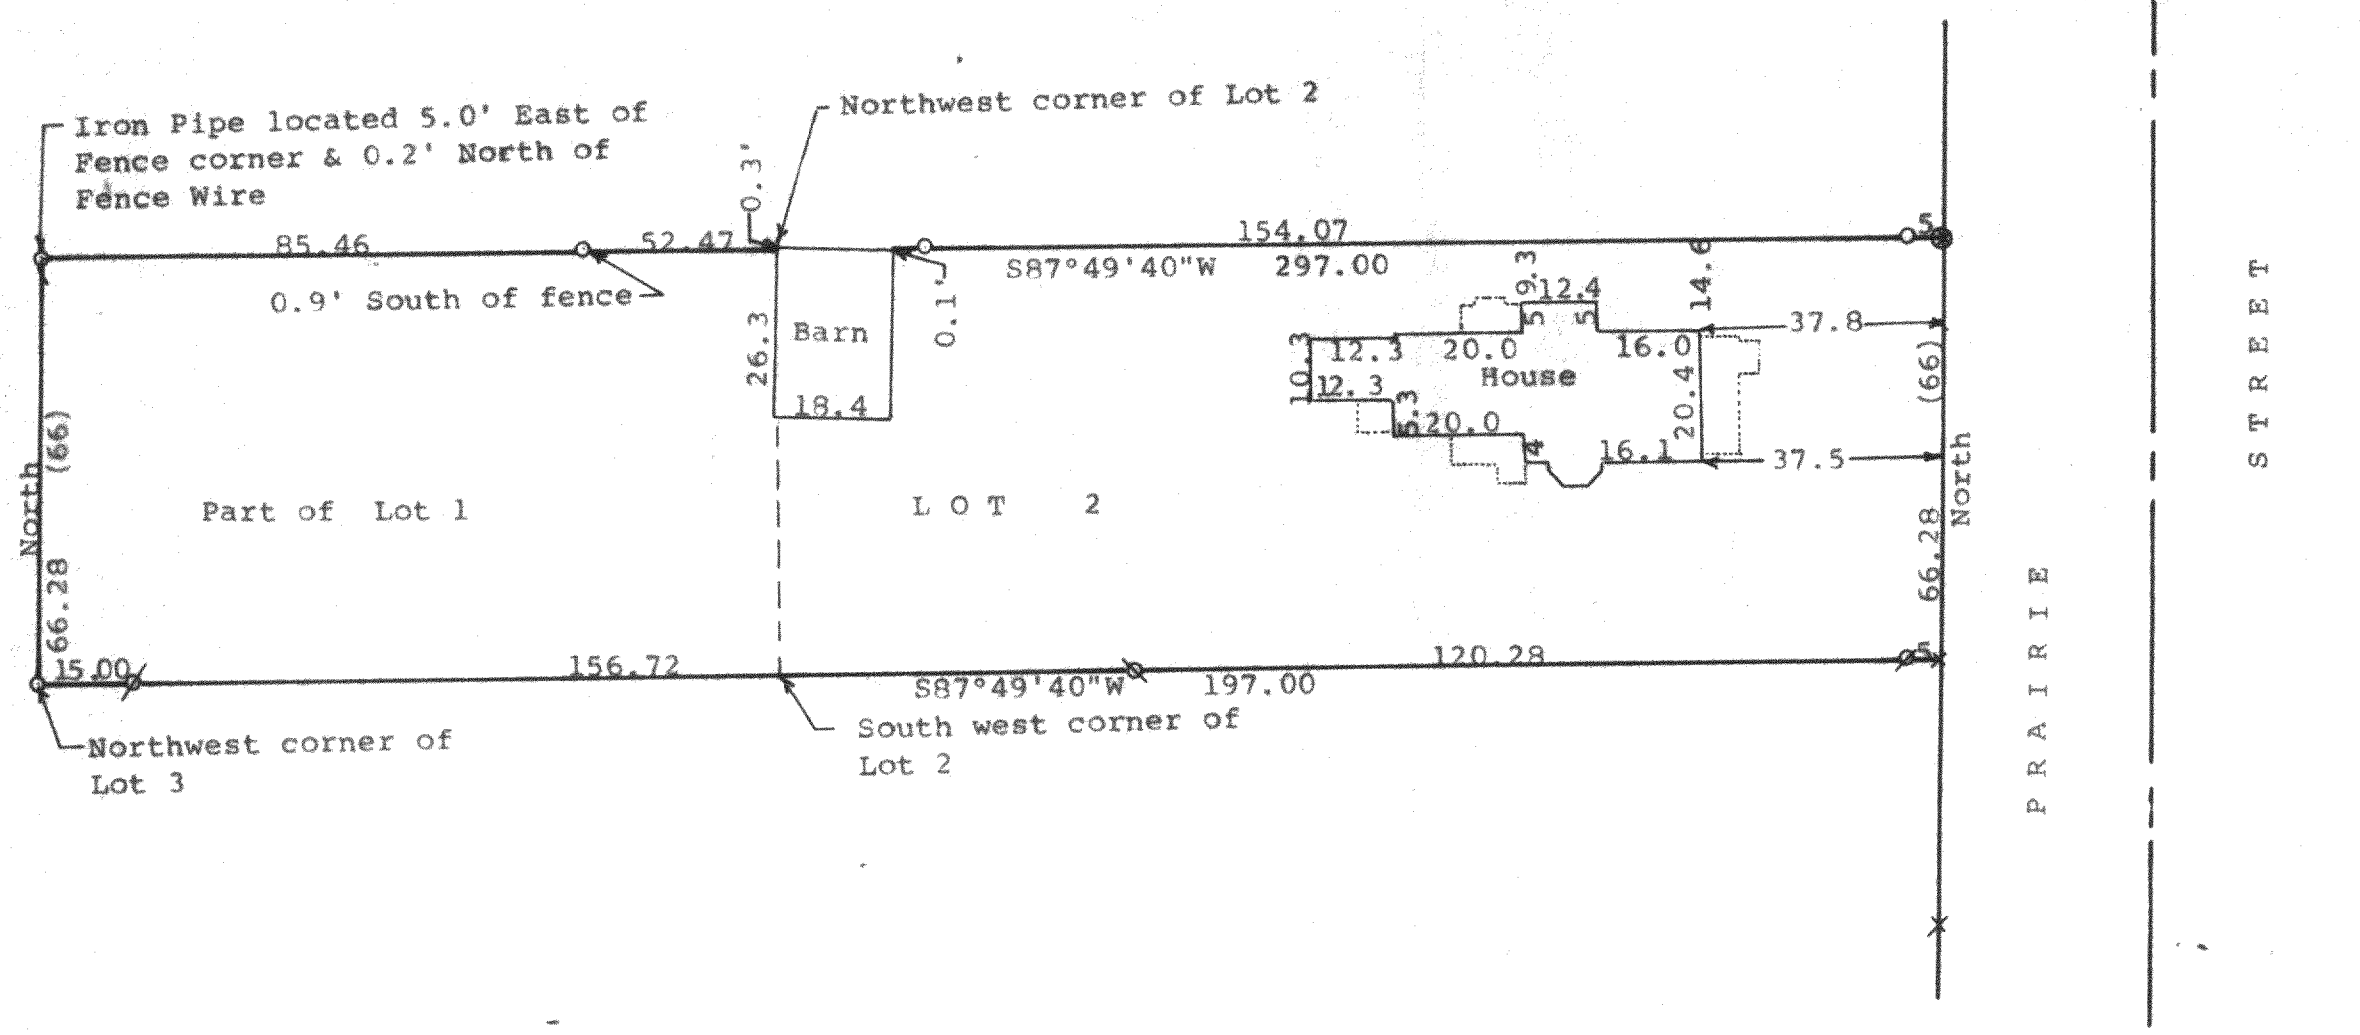

STATE OF WISCONSIN) SS
COUNTY OF WALWORTH)

I, George T. Dunham, Surveyor, certify that I have surveyed the property described as follows:



Lot 2 in Block 10 of Citizens Addition to the Village of Sharon, Walworth County, Wisconsin

Also that part of Lot 1, Block 10 of Said Citizens Addition to the Village of Sharon, Walworth County, Wisconsin, described as follows: Beginning at the Southwest corner of Lot 2 of said Block 10; thence west 7 rods to the Northwest corner of Lot 3 of said Block 10; thence North 4 rods; thence East 7 rods to the northwest corner of said Lot 2; thence South 4 rods to the place of beginning

and that the plat shown hereon is a correct representation thereof and shows the size and location of the property, its exterior boundaries, the location of all visible structures and dimensions of all principal buildings thereon, boundary fences, apparent easements, roadways and visible encroachments, if any, and that I have surveyed the property hereon described, according to the official records, to the best of my knowledge and belief.

August 26, 1993

George T. Dunham
George T. Dunham, Surveyor

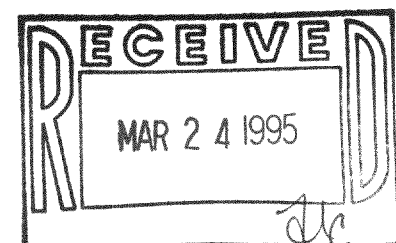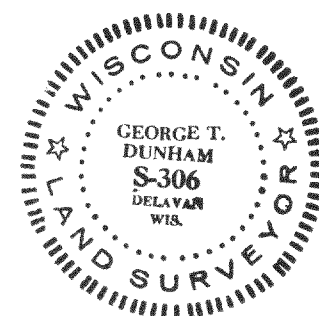

UCA-185
008-270