

ABERNATHY and ASSOCIATES




Kenneth B. Abernathy Jr.

Wisconsin Registered Land Surveyor S-1594

Rt. 3, Box 273
Elkhorn, Wisconsin 53121
Phone: (414) 723-4260 (office)
(414) 723-4813 (residence)

PLAT OF SURVEY

LOT 2 OF CERTIFIED SURVEY MAP NO. 1176 as recorded in Vol. 5 of Certified Survey Maps as Page 241, as Document No. 71839, being part of Lot 4, Block 3 of Wise and Nelson's Addition to Sharon, Walworth County, Wisconsin. EXCEPTING THEREFROM the West 18 1/2 feet of Lot 2 of Certified Survey Map No. 1176.

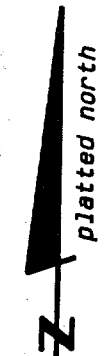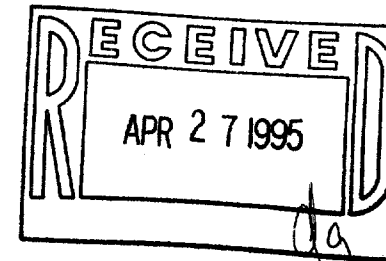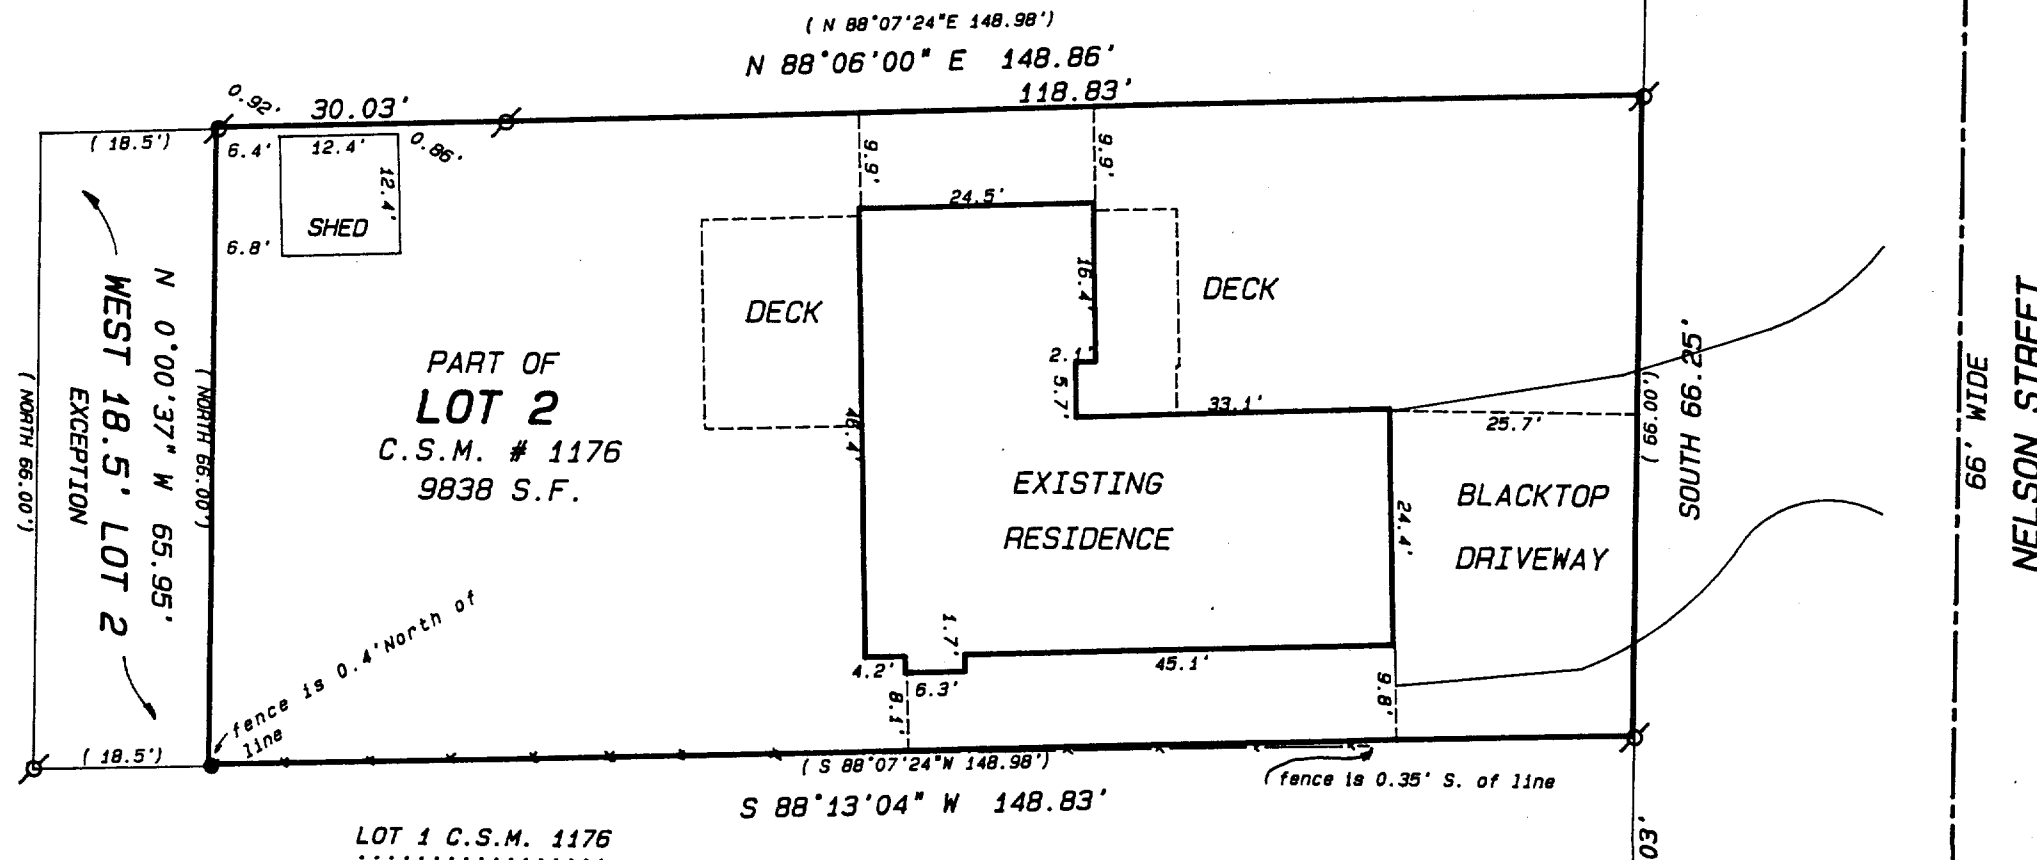

SCALE: 1" = 20 FEET


Legend

- FOUND IRON PIPE
- FOUND IRON ROD
- FOUND BRASS CAPPED MONUMENT
- FOUND CONCRETE MONUMENT
- + CHISEL CUT IN CONCRETE
- SET IRON ROD, 24" LONG, WEIGHING 1.5 LBS./LINEAL FT., 3/4" DIA.
- SET IRON ROD, 30" LONG, WEIGHING 4.5 LBS./LINEAL FT., 1-11/16" DIA.
- (xx) RECORDED AS DIMENSION
- x-x- EXISTING FENCE

Ordered By: Atty. Kim Howarth
Godfrey, Neshek, Worth & Leible, S.C.
P. O. Box 260
Elkhorn, Wi. 53121

Owner: the Harvard State Bank
P.O. Box 40
Harvard, Il. 60033

Subject Property: 243 Nelson St.
Walworth, Wi. 53585

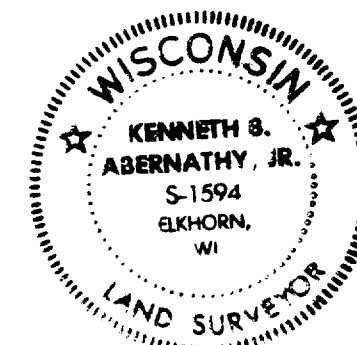

"I hereby certify that I have surveyed the above described property and that the above map is a true representation thereof and shows the size and location of the property, its exterior boundaries, the location of all visible structures and dimensions of all principal buildings thereon, boundary fences, apparent easements, roadways and visible encroachments, if any."

"This survey is made for the use of the present owners of the property, and also those who purchase, mortgage, or guarantee the title thereto within one year from date hereof."

Kenneth B. Abernathy, Jr.

KENNETH B. ABERNATHY, JR.
WISCONSIN REGISTERED LAND SURVEYOR,
S-1594

Date: 4-20-95 Job No. 95.412

UA-1176-2

008-275