


DUNHAM SURVEYING, S. C.
 SURVEYING & SUBDIVIDING
 DELAYAN, WISCONSIN 53115

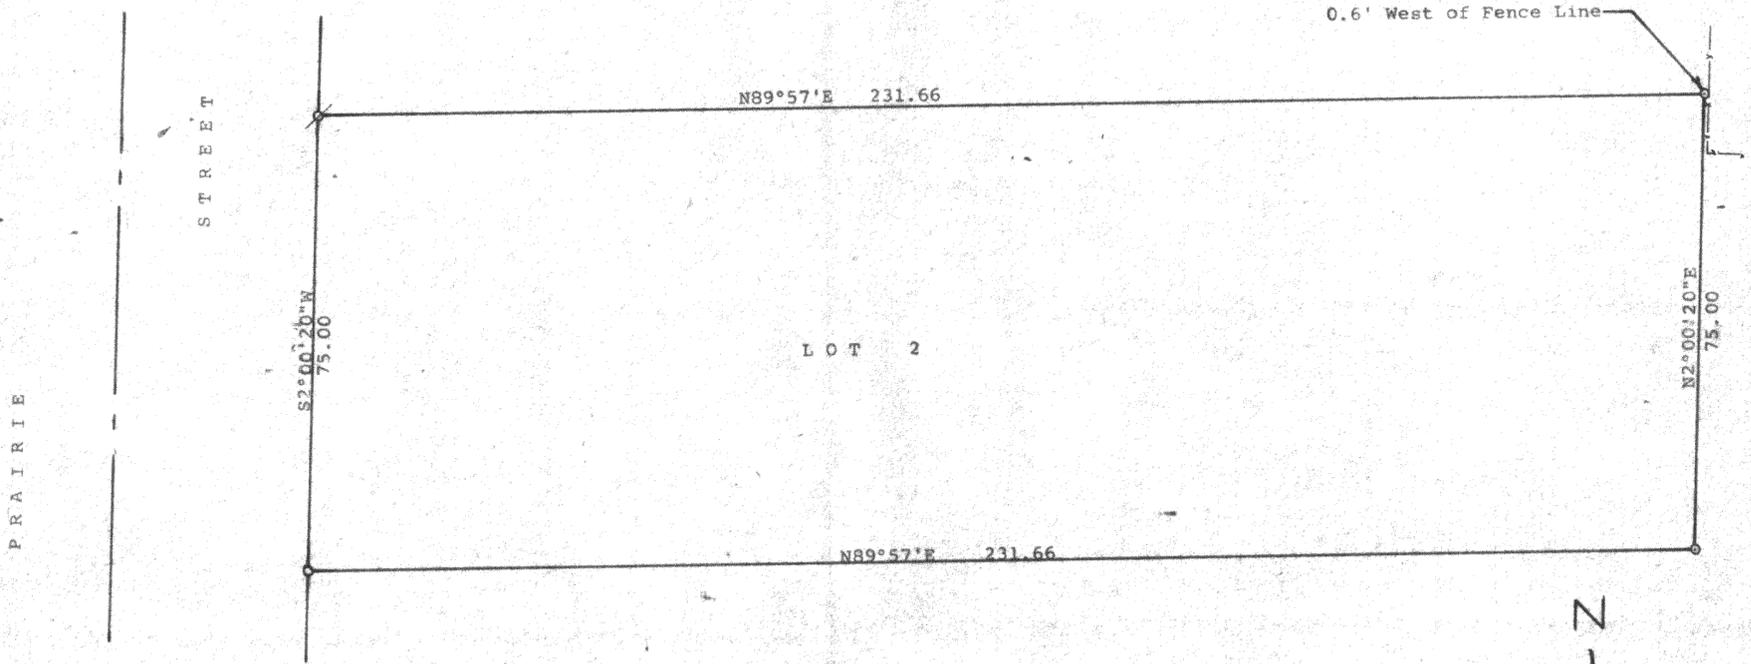

STATE OF WISCONSIN)
 COUNTY OF WALWORTH) SS


I, George T. Dunham, Surveyor certify that I have surveyed the property described as follows:

Lot 2 of Certified Survey No. 2465, recorded in Volume 12 of Certified Surveys on Page 153, in the Office of the Register of Deeds for Walworth County, Wisconsin, on July 1, 1994, land being a part of Lot 36 in Block 9 of Citizens Addition to the Village of Sharon, Walworth County, Wisconsin


and that the plat shown hereon is a correct representation thereof and shows the size and location of the property, its exterior boundaries, the location of all visible structures and dimensions of all principal buildings thereon, boundary fences, apparent easements, roadways and visible encroachments, if any, and that I have surveyed the property hereon described, according to the official records, to the best of my knowledge and belief.
 February 20, 1996

George T. Dunham
 George T. Dunham, Surveyor

Scale - 1" = 20'
 O = 1" Iron Pipe Found
 Ø = 1 1/4" Iron Pipe Found
 Bearings are those shown on the recorded plat of CSM No. 2465
 --- = Fence Line
 Survey ordered by:
 Action Realty
 P. O. Box 324
 Harvard, IL. 60033

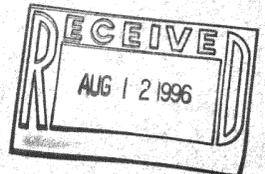

DUNHAM SURVEYING, S. C.
 SURVEYING & SUBDIVIDING
 DELAVAN, WISCONSIN 53115

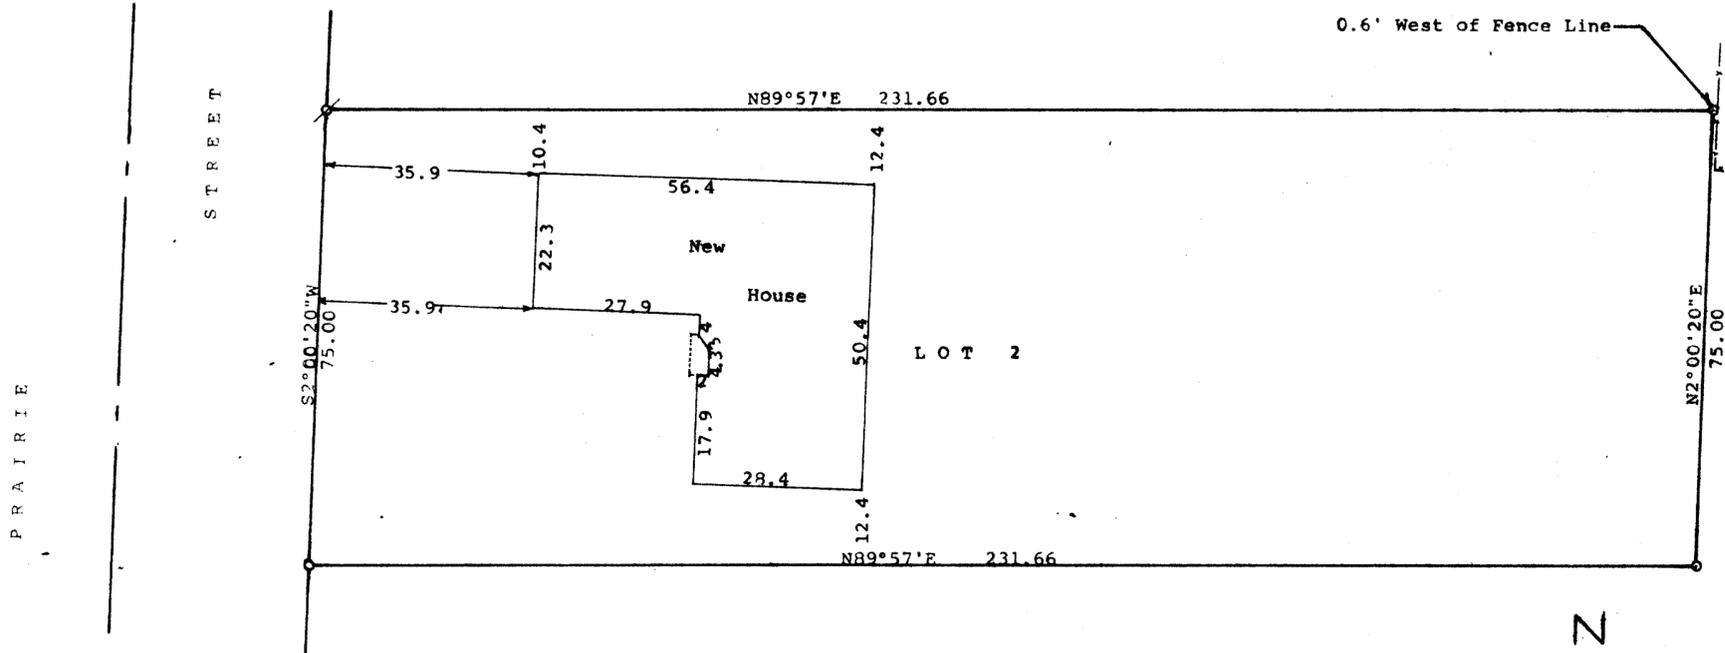

STATE OF WISCONSIN)
 COUNTY OF WALWORTH) SS

I, George T. Dunham, Surveyor certify that I have surveyed the property described as follows:

Lot 2 of Certified Survey No. 2465, recorded in Volume 12 of of Certified Surveys on Page 153, in the Office of the Register of Deeds for Walworth County, Wisconsin, on July 1, 1994, land being a part of Lot 36 in Block 9 of Citizens Addition to the Village of Sharon, Walworth County, Wisconsin



and that the plat shown hereon is a correct representation thereof and shows the size and location of the property, its exterior boundaries, the location of all visible structures and dimensions of all principal buildings thereon, boundary fences, apparent easements, roadways and visible encroachments, if any, and that I have surveyed the property hereon described, according to the official records, to the best of my knowledge and belief.

February 20, 1996

Updated and recertified to this 2nd day of May, 1996

George T. Dunham
 George T. Dunham, Surveyor

Scale - 1" = 20'
 o = 1" Iron Pipe Found
 ø = 1 1/4" Iron Pipe Found
 Bearings are those shown on the recorded plat of CSM No. 2465
 --- = Fence Line
 Survey ordered by:
 Action Realty
 P. O. Box 324
 Harvard, IL. 60033
 Updating and recertification ordered by:
 First Federal Janesville
 2821 Milton Avenue
 Janesville, WI 53545

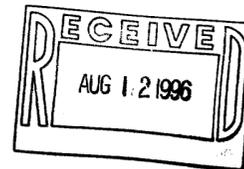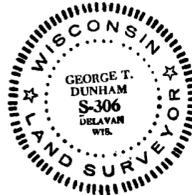

UA-2465-2
 008-287