


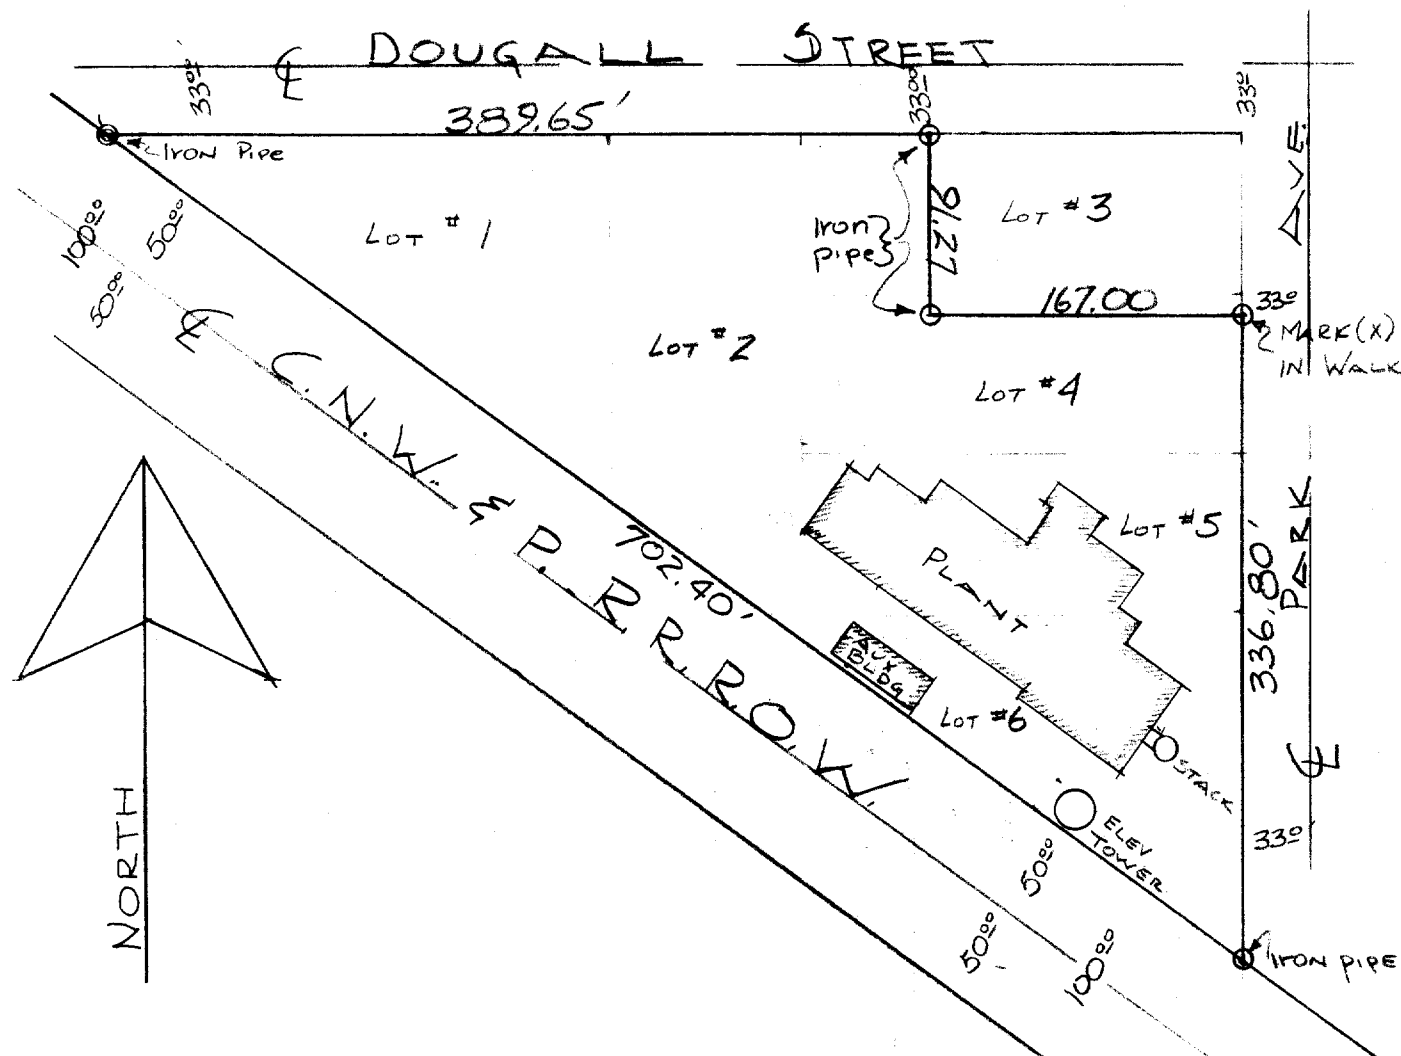

DESCRIPTION: Lots #1, #2, #3, #4, #5, #6 of Block 3 of the Sharon Land Improvement Company's Addition to the Village of Sharon, Walworth County, Wisconsin; Excepting therefrom a piece of land bounded and described as follows: Commencing at the North East corner of said Block 3, thence running West 167.00 feet to an iron stake, thence South 91.27 feet to an iron stake, thence East 167.00 feet to an "X" in the sidewalk, thence North 91.27 feet to the place of beginning.

CERTIFICATE: I, James F. Biagi surveyor do hereby certify that I have surveyed the property hereon described, and that the location of all of the improvements are as shown on the drawing above.

SIGNED AND SEALED THIS 21ST DAY OF APRIL 1960.



James F. Biagi RLS 272