


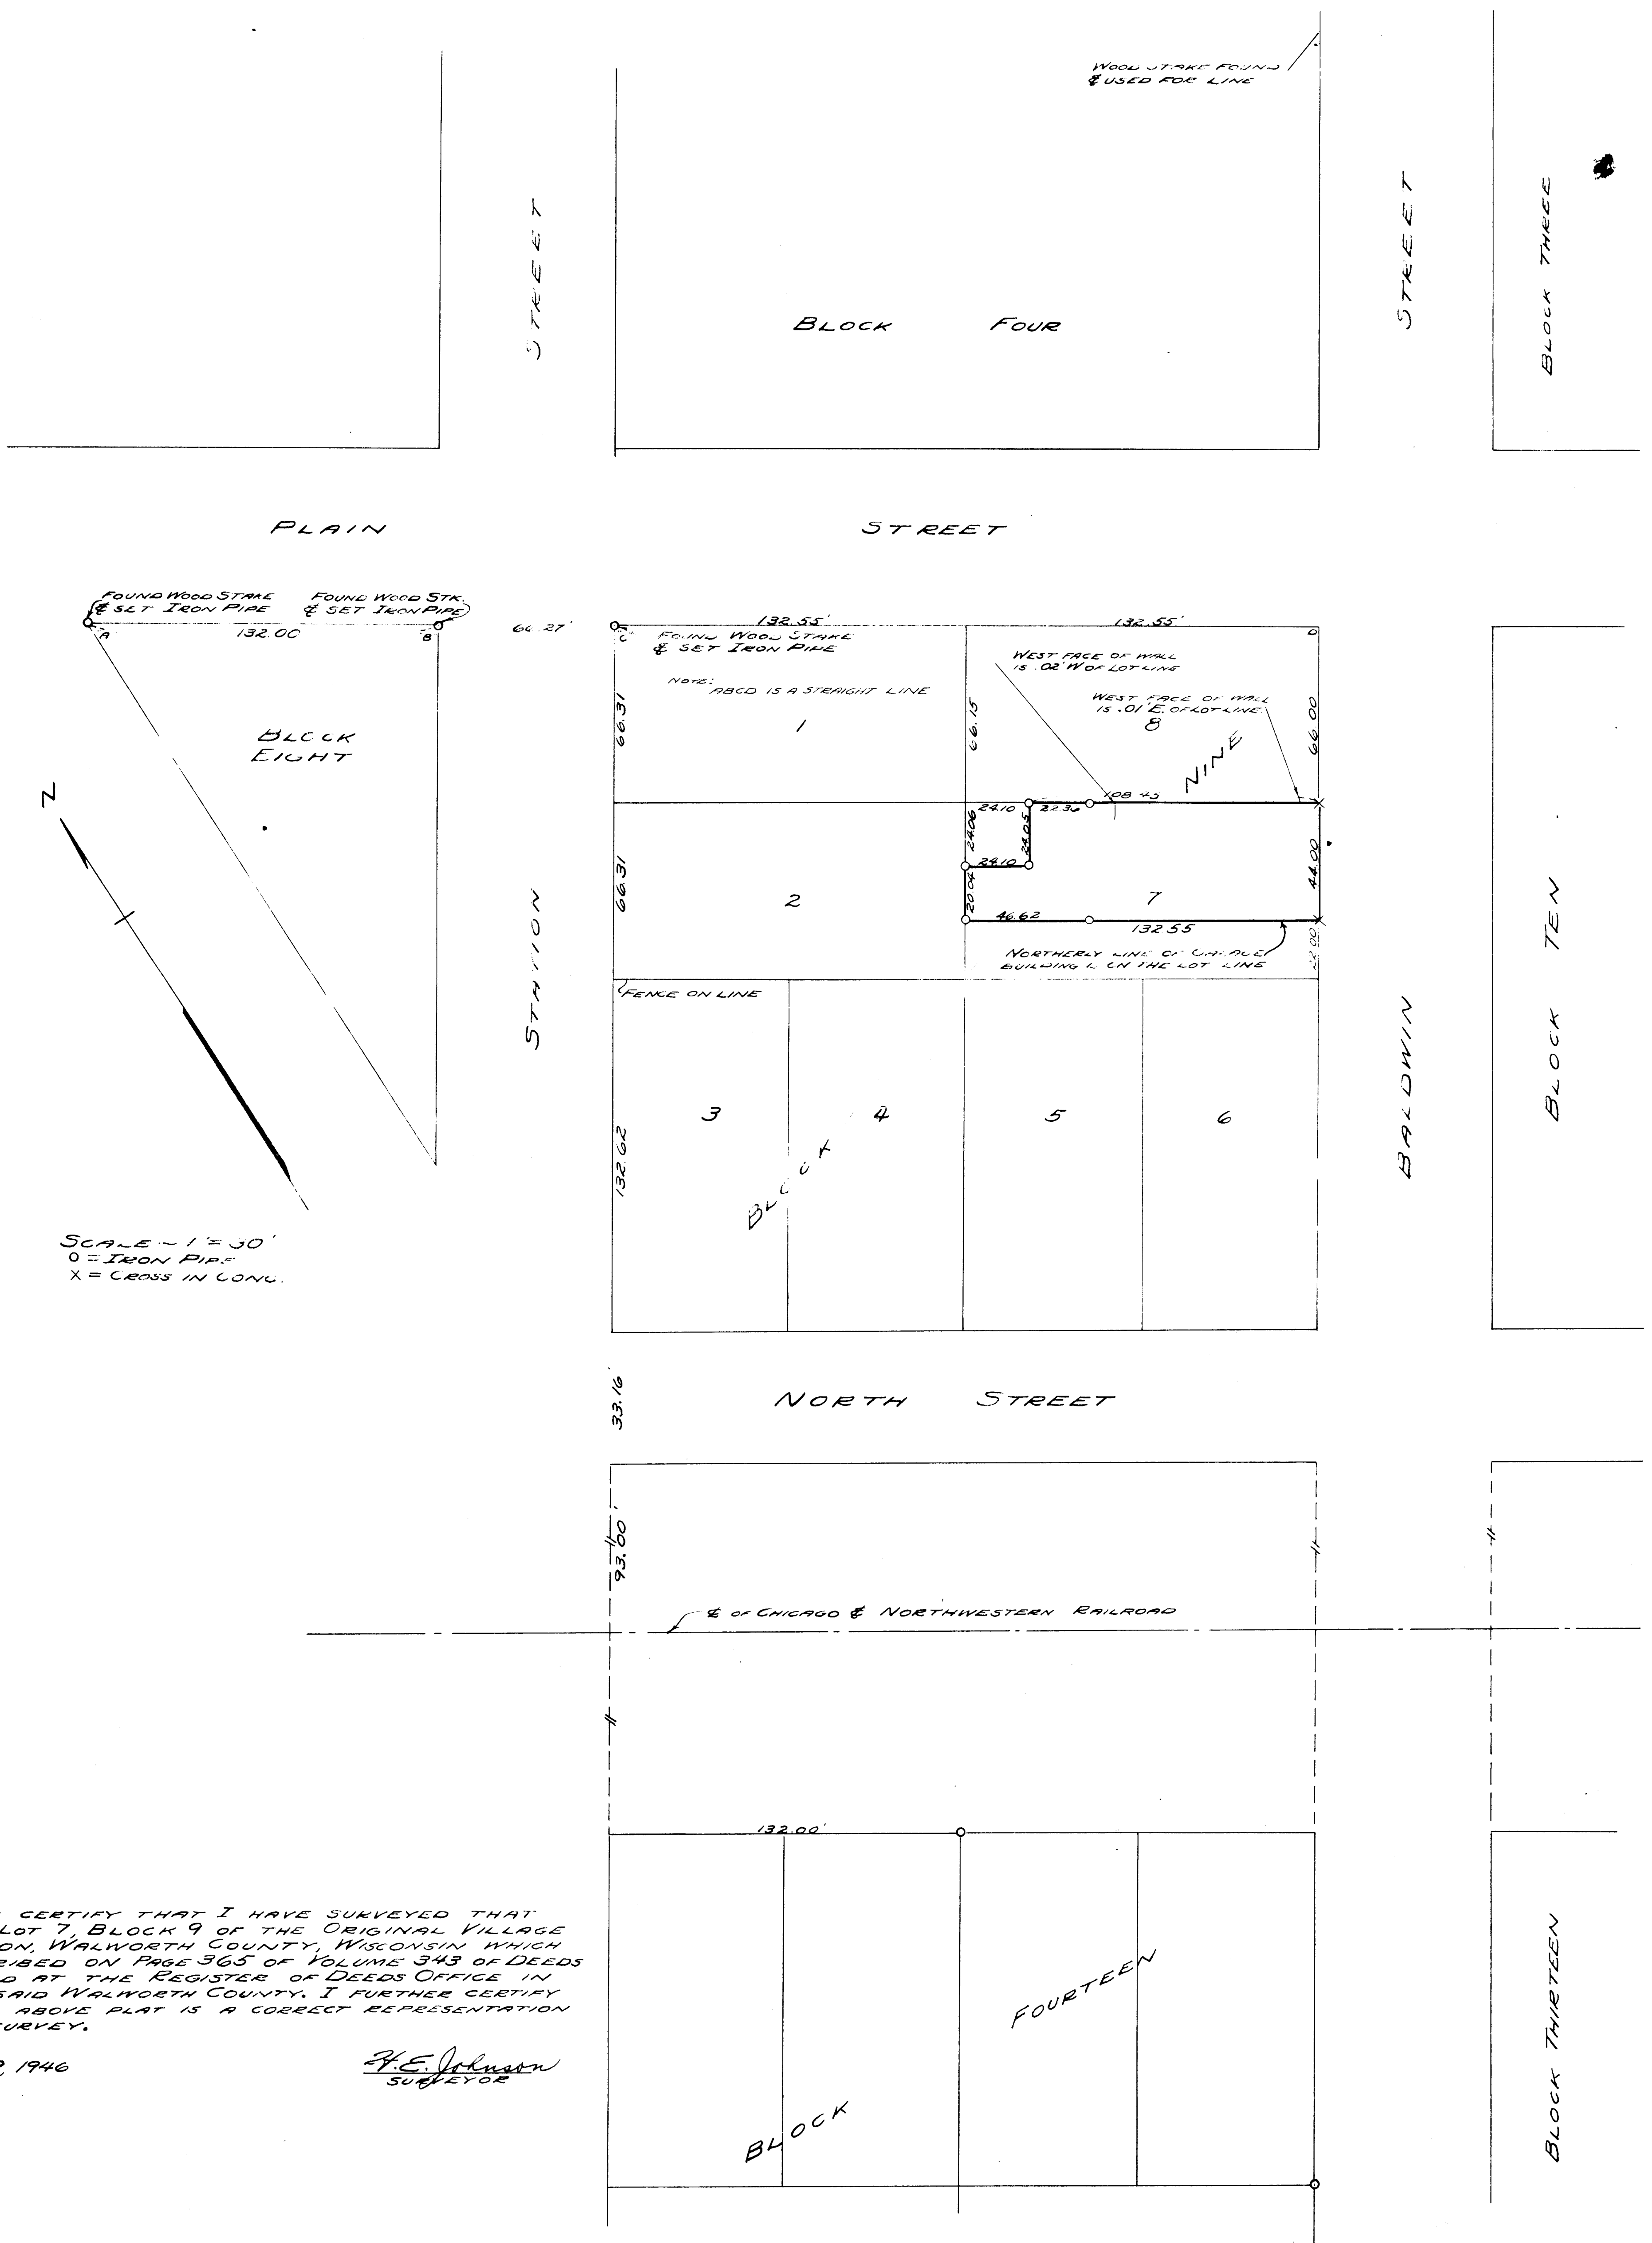

I HEREBY CERTIFY THAT I HAVE SURVEYED THAT PART OF LOT 7, BLOCK 9 OF THE ORIGINAL VILLAGE OF SHARON, WALWORTH COUNTY, WISCONSIN WHICH IS DESCRIBED ON PAGE 365 OF VOLUME 343 OF DEEDS ON RECORD AT THE REGISTER OF DEEDS OFFICE IN AND FOR SAID WALWORTH COUNTY. I FURTHER CERTIFY THAT THE ABOVE PLAT IS A CORRECT REPRESENTATION OF SAID SURVEY.

MARCH 29, 1946

F. E. Johnson
SURVEYOR