



ABELL
SURVEYING & MAPPING

1140 SEQUOIA STREET • DELAVAN, WISCONSIN 53115
414-728-6737

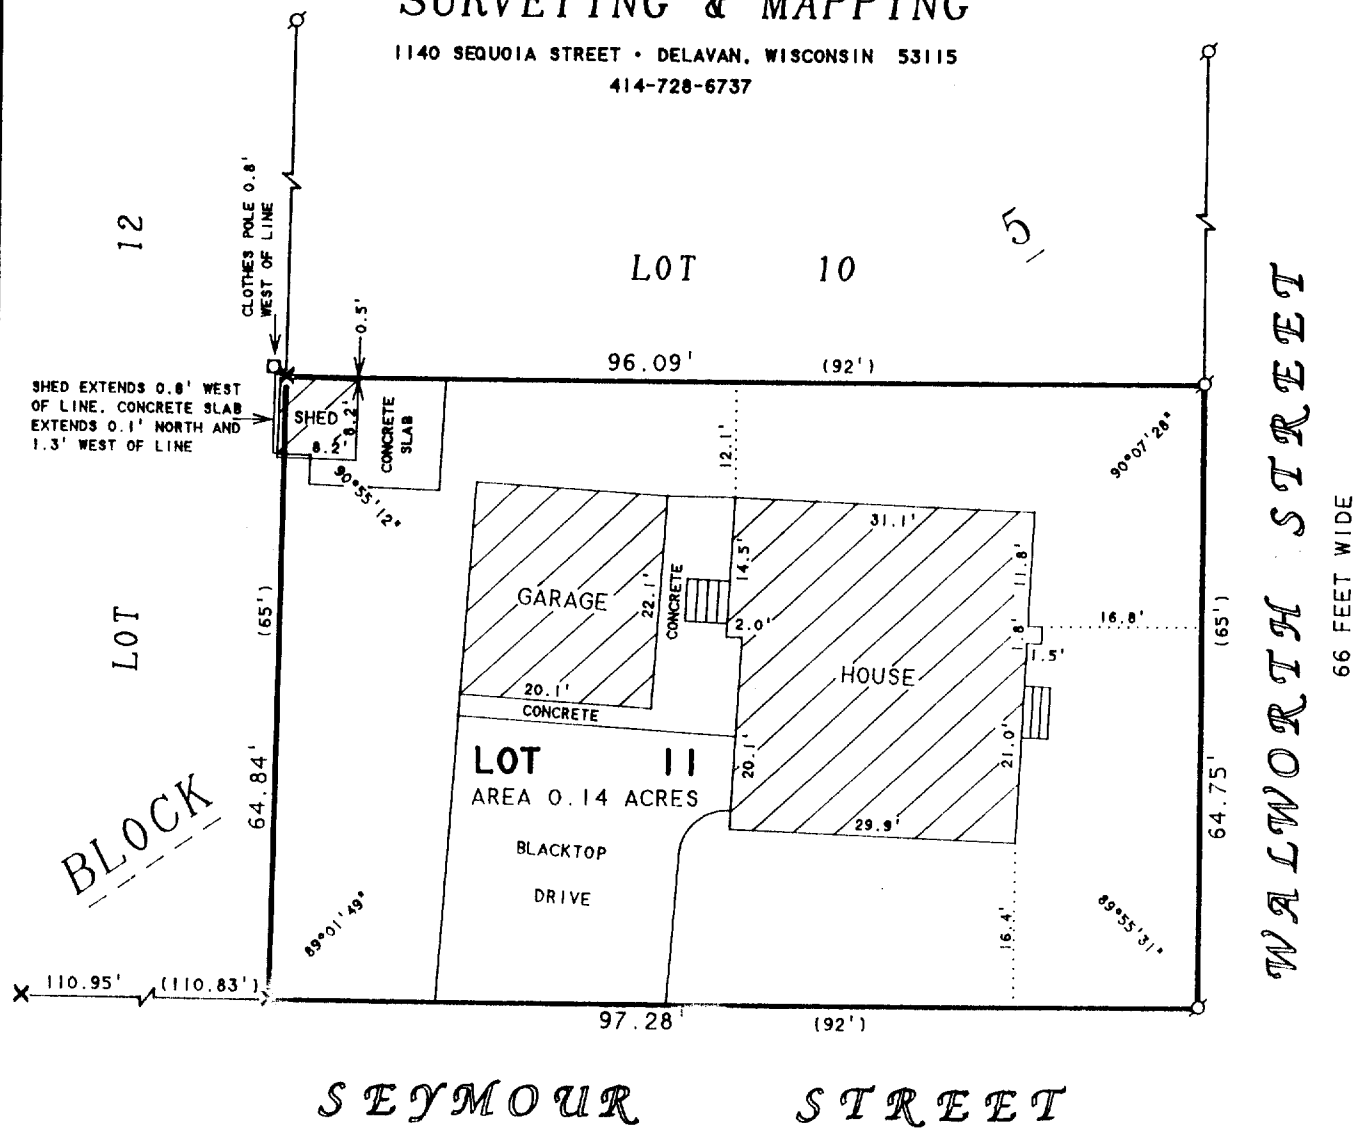

NOTE: THE SOUTH LINE OF BLOCK 5, CITIZENS ADDITION WAS FOUND TO HAVE AN OVERRUN OF 5.65 FEET. USING THE EXISTING MONUMENTATION FOUND IN THE FIELD, IT WAS DETERMINED THAT THE MAJOR PORTION OF THE OVERRUN WAS PLACED IN THE SOUTHEASTERN PART OF THE BLOCK.

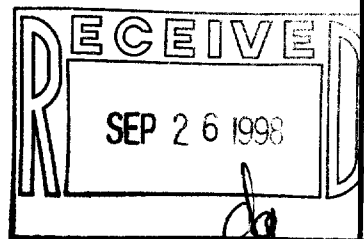

ORDERED BY: MARY E. GRAY
215 WALWORTH STREET
SHARON, WI 53585

PLAT OF SURVEY OF

LOT 11, BLOCK 5, CITIZENS ADDITION-NORTH SIDE,
LOCATED IN THE VILLAGE OF SHARON, WALWORTH
COUNTY, WISCONSIN.

N



SCALE 1"=20'

LEGEND

- - IRON PIPE FOUND
- x - CUT CROSS IN CONCRETE FOUND
- () - RECORDED AS

I HEREBY CERTIFY THAT I HAVE SURVEYED THE ABOVE DESCRIBED PROPERTY AND THAT THE ABOVE MAP IS A TRUE REPRESENTATION THEREOF AND SHOWS THE SIZE AND LOCATION OF THE PROPERTY, ITS EXTERIOR BOUNDARIES, THE LOCATION OF ALL VISIBLE STRUCTURES AND DIMENSIONS OF ALL PRINCIPAL BUILDINGS THEREON, BOUNDARY FENCES, APPARENT EASEMENTS, ROADWAYS AND VISIBLE ENCROACHMENTS, IF ANY, TO THE BEST OF MY KNOWLEDGE AND BELIEF.

THIS SURVEY IS MADE FOR THE USE OF THE PRESENT OWNERS OF THE PROPERTY, AND ALSO THOSE WHO PURCHASE, MORTGAGE, OR GUARANTEE THE TITLE THERETO WITHIN ONE (1) YEAR FROM DATE HEREON.

David F. Abell

DAVID F. ABELL
WISCONSIN REGISTERED LAND SURVEYOR, S-1596

July 30, 1998

DATE: July 30, 1998 JOB NUMBER - 98103
NOTE: THIS IS NOT A CERTIFIED COPY UNLESS SEALED.

UCA-92

008-308