


ABELL
SURVEYING & MAPPING
1140 SEQUOIA STREET • DELAVAN, WISCONSIN 53115
414-728-6737

GEORGE STREET
66 FEET WIDE

LOT 1

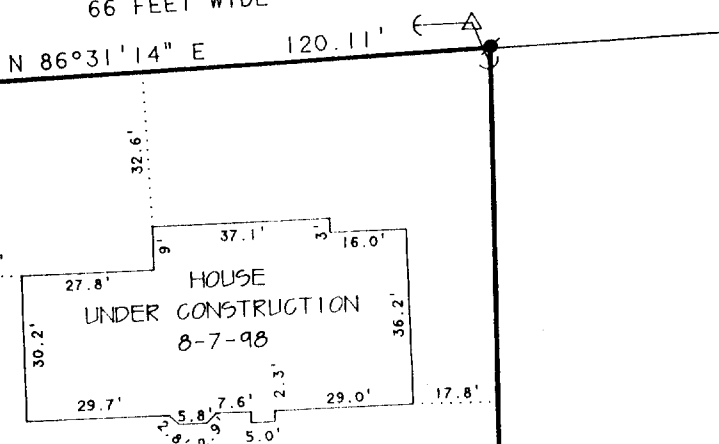


LOT 2
AREA 1.02 ACRES

PLAT OF SURVEY OF

LOT 2, CERTIFIED SURVEY MAP NO. 2626, LOCATED
IN THE NORTHEAST 1/4 OF SECTION 32, T1N, R15E,
VILLAGE OF SHARON, WALWORTH COUNTY, WISCONSIN.

NOTE: BEARINGS ARE REFERENCED TO
CERTIFIED SURVEY MAP NO. 2626.

ORDERED BY: PHILLIP GOTTMAN
P.O. BOX 24
SHARON, WI 53585

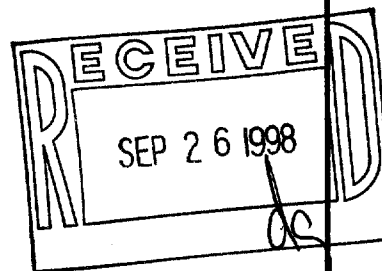

N



SCALE 1"=40'

LEGEND

- - IRON ROD FOUND
- - CONCRETE MONUMENT FOUND
- △ - UTILITY POLE
-) - GUY WIRE

I HEREBY CERTIFY THAT I HAVE SURVEYED THE ABOVE DESCRIBED PROPERTY AND THAT THE
ABOVE MAP IS A TRUE REPRESENTATION THEREOF AND SHOWS THE SIZE AND LOCATION OF
THE PROPERTY, ITS EXTERIOR BOUNDARIES, THE LOCATION OF ALL VISIBLE STRUCTURES
AND DIMENSIONS OF ALL PRINCIPAL BUILDINGS THEREON, BOUNDARY FENCES, APPARENT
EASEMENTS, ROADWAYS AND VISIBLE ENCROACHMENTS, IF ANY, TO THE BEST OF MY
KNOWLEDGE AND BELIEF.

THIS SURVEY IS MADE FOR THE USE OF THE PRESENT OWNERS OF THE PROPERTY, AND ALSO
THOSE WHO PURCHASE, MORTGAGE, OR GUARANTEE THE TITLE THERETO WITHIN ONE (1) YEAR
FROM DATE HEREON.

David F. Abell

DAVID F. ABELL
WISCONSIN REGISTERED LAND SURVEYOR, S-1596

August 12, 1998

DATE: August 12, 1998 JOB NUMBER - 94095
NOTE: THIS IS NOT A CERTIFIED COPY UNLESS SEALED.

008-310

UA-2626-2