

PLAT OF SURVEY

LOT 23 OF BLOCK 4 OF CITIZENS
ADDITION TO THE VILLAGE OF
SHARON, WALWORTH COUNTY, WISCONSIN



ORDERED BY: BEV LONG
CENTURY 21 AFFILIATED
50 W. GENEVA ST.
P.O. BOX 367
WILLIAMS BAY, WI. 53191

NOTES:

PLAT RECORDED IN CABINET 3 SLIDE 49 OF WALWORTH
COUNTY PLATS


THIS SURVEY RETRACES A PREVIOUS PLAT OF SURVEY
PREPARED BY MATTHEW J. STAHL DATED 10/25/97 WHICH
WAS NOT RECORDED IN THE WALWORTH COUNTY SURVEYORS
OFFICE AND WHICH DID NOT MEET MINIMUM STANDARDS AS
DEFINED BY THE WISCONSIN ADMINISTRATIVE CODE UNDER
SECTION A-E 7.06 (3).

OWNERS: LUANN KLINE, STEVEN ADDIE, NANCY ADDIE AND
JUDY TURNBULL
181 PRAIRIE
P.O. BOX 179
SHARON, WI. 53585

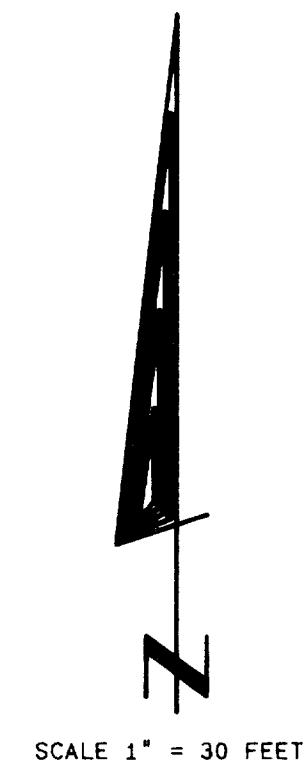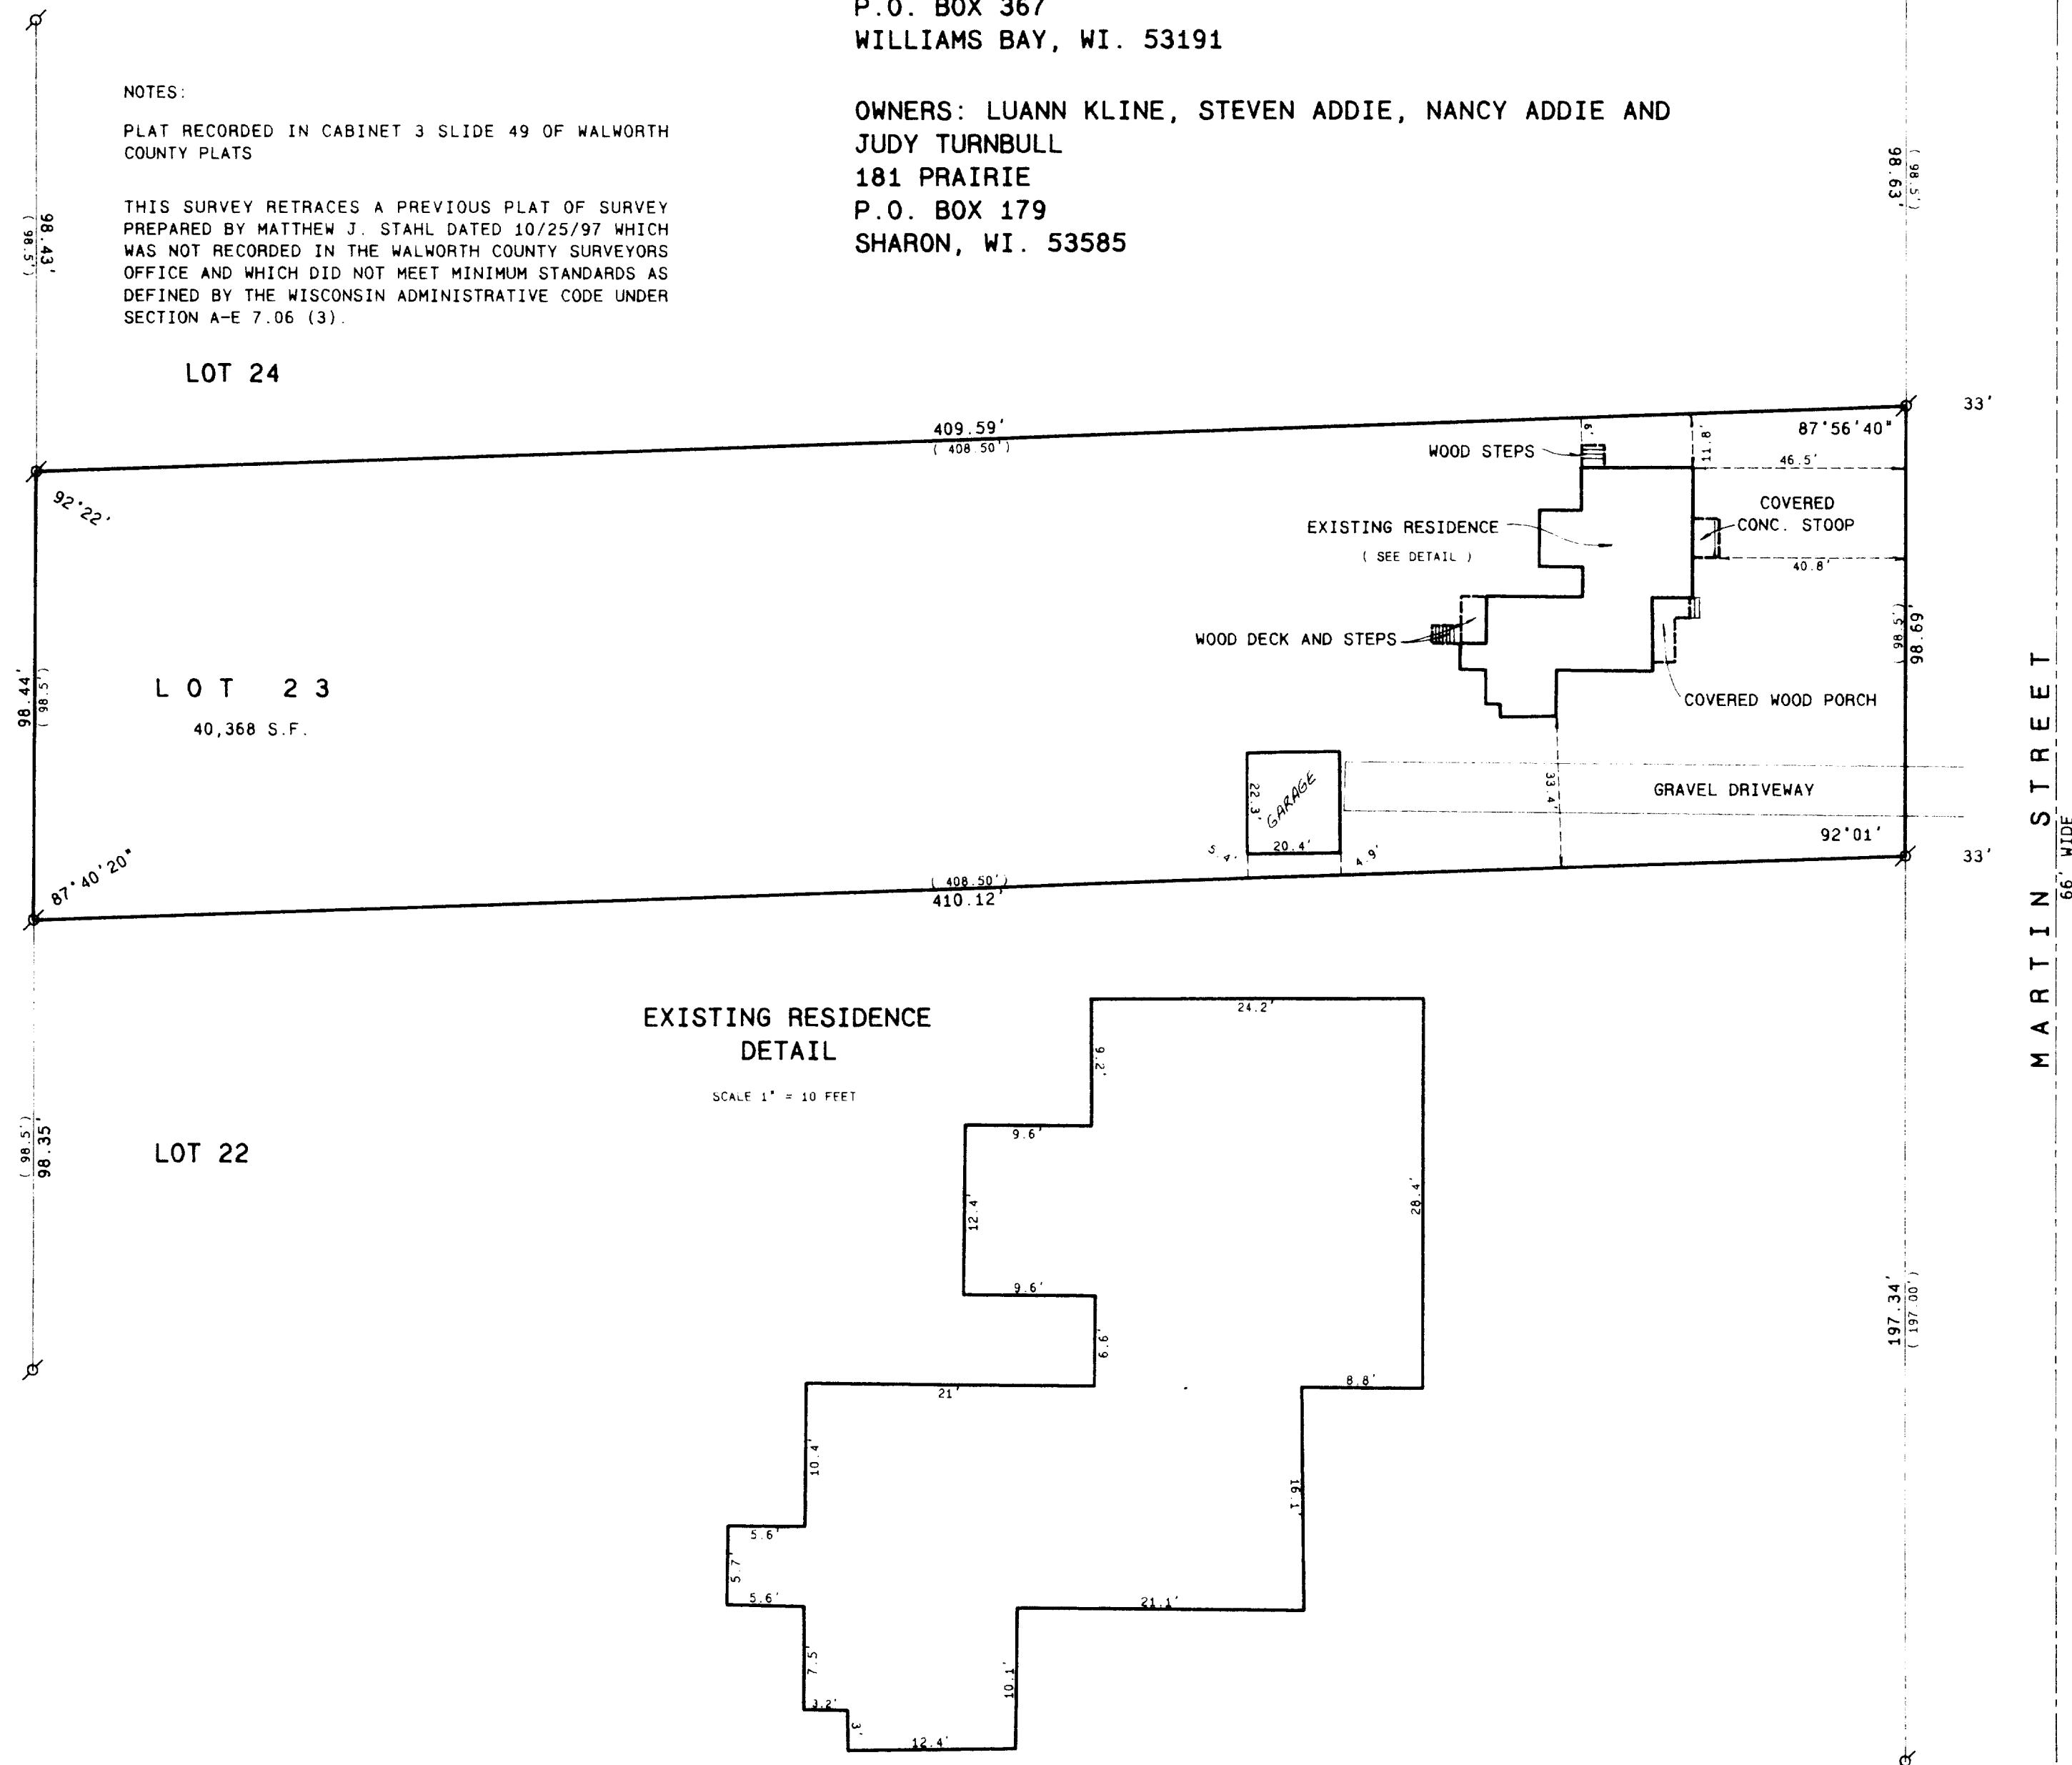

Legend

- FOUND IRON PIPE
- FOUND IRON ROD
- FOUND BRASS CAPPED MONUMENT
- FOUND CONCRETE MONUMENT
- CHISEL CUT IN CONCRETE
- SET IRON ROD, 24" LONG, WEIGHING 1.5 LBS. LINEAL FT., 3/4" DIA.
- SET IRON ROD, 30" LONG, WEIGHING 4.5 LBS. LINEAL FT., 1-11/16" DIA.
- (xx) RECORDED AS DIMENSION
- EXISTING FENCE

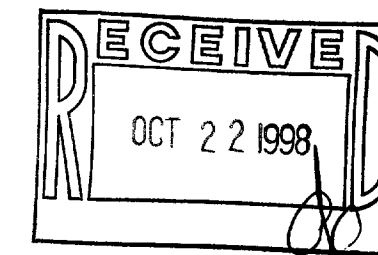

SCALE: 1" = 30 FEET

I hereby certify that the above described property has been surveyed by me or under my direction and that the above map is a true representation thereof and shows the size and location of the property, its exterior boundaries, the location of all visible structures and dimensions of all principal buildings thereon, boundary lines, adjacent owners, roadways and visible encroachments, if any.

This survey is made for the use of the present owners of the property and also those who purchase, mortgage, or guarantee the title thereto within one year from date hereof.

Kenneth B. Abernathy, Jr.
KENNETH B. ABERNATHY, JR.
WISCONSIN REGISTERED LAND SURVEYOR,
S-1594
Date: JUNE 15, 1998 Job No. 98-604

008-313
UCA-67