
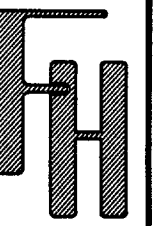


STATE 21 1999
JAN 21 1999

PLAT OF SURVEY

LOT 8 OF BLOCK 2 OF
WISE & NELSON'S SOUTH SIDE ADDITION
TO THE VILLAGE OF SHARON
WALWORTH COUNTY, WISCONSIN

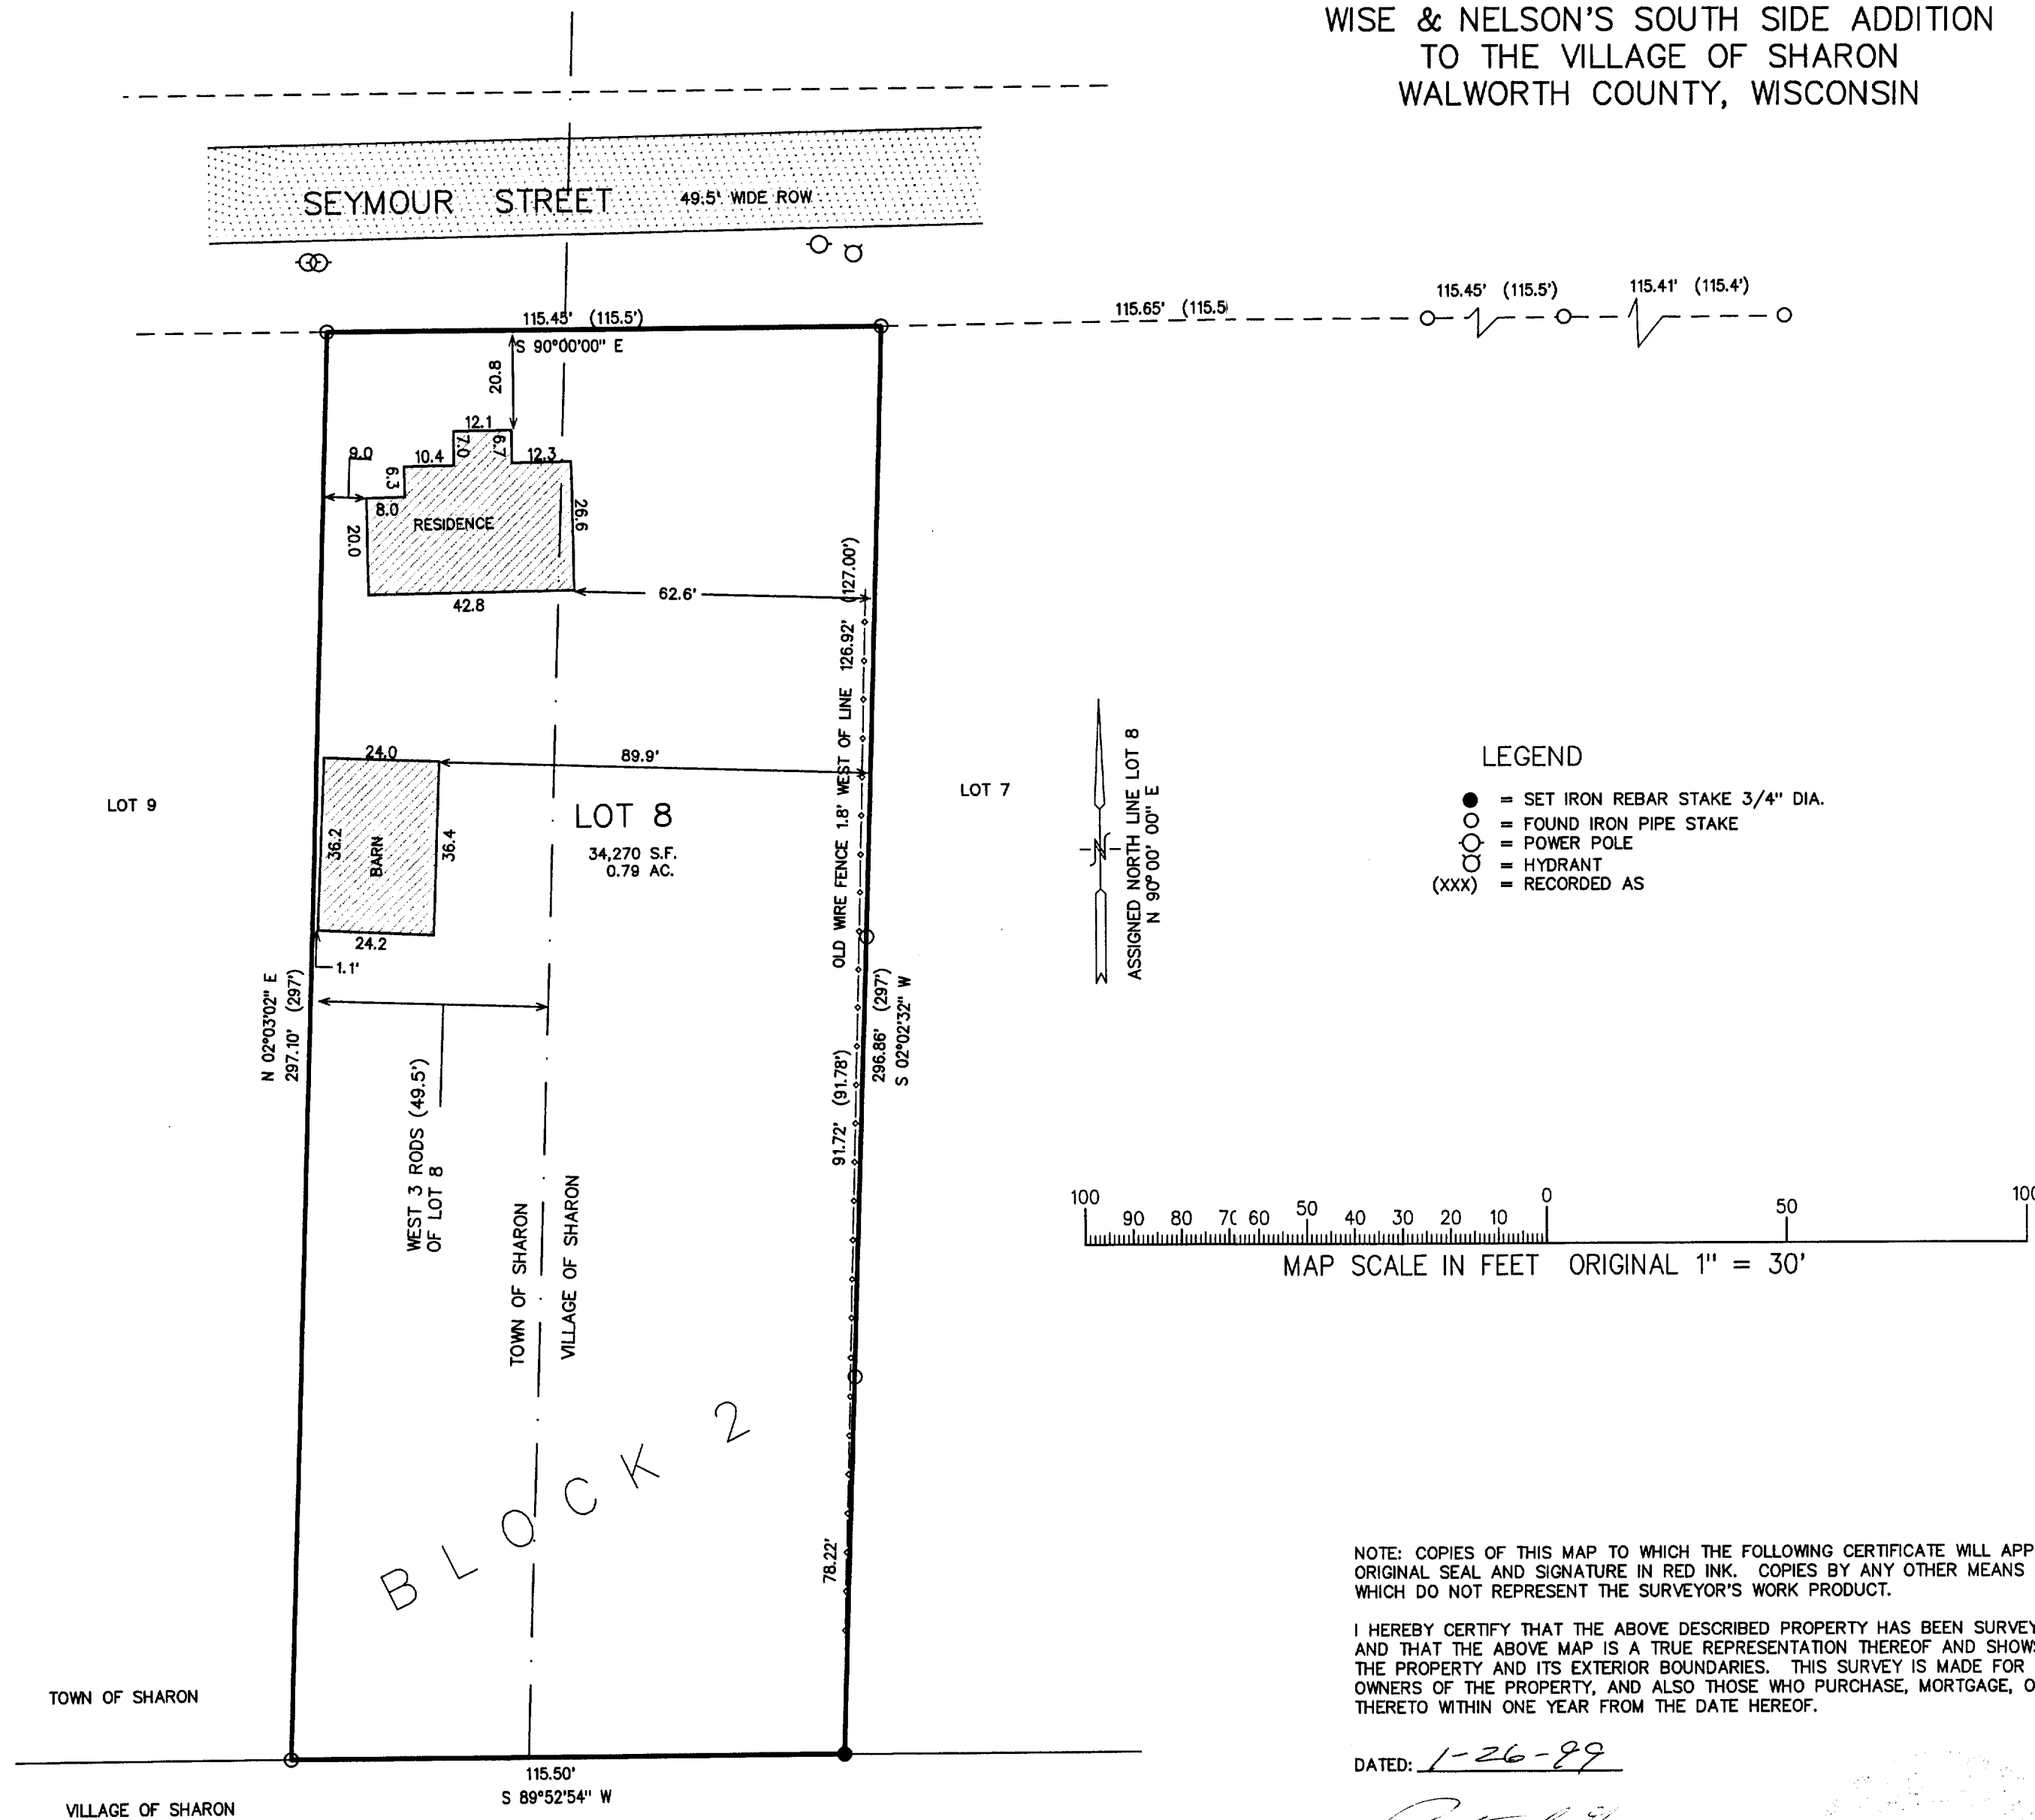


WORK ORDERED BY:
THE VILLAGE OF SHARON
PO BOX 379
SHARON, WI. 53585

FARRIS, HANSEN & ASSOCIATES, INC.
Engineering, Architecture, Surveying
7 Ridgway Court P.O. Box 437
ELKHORN, WISCONSIN 53121
Office: (414) 723-2098
Fax: (414) 723-5886

REVISIONS

PROJECT NO.
5196
DATE:
01-22-99
SHEET NO.
1 OF 1

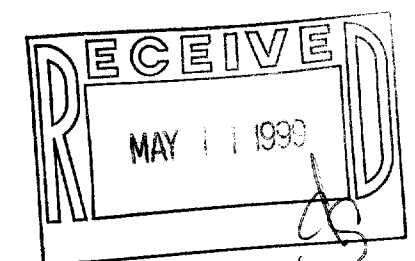

UWS-17
HWA-21

008-323