

HOGANSON & ROBERS, INC.
CONSULTING ENGINEERS & LAND SURVEYORS


PHONE (414) 763-2652

116 E CHESTNUT ST.


BURLINGTON, WIS. 53105

PLAT OF SURVEY
of
Lot 1, Block 1 Citizens North Side Addition
Village of Sharon, Walworth Co. Wisconsin

Center
of
E. Col. Hwy
in Right

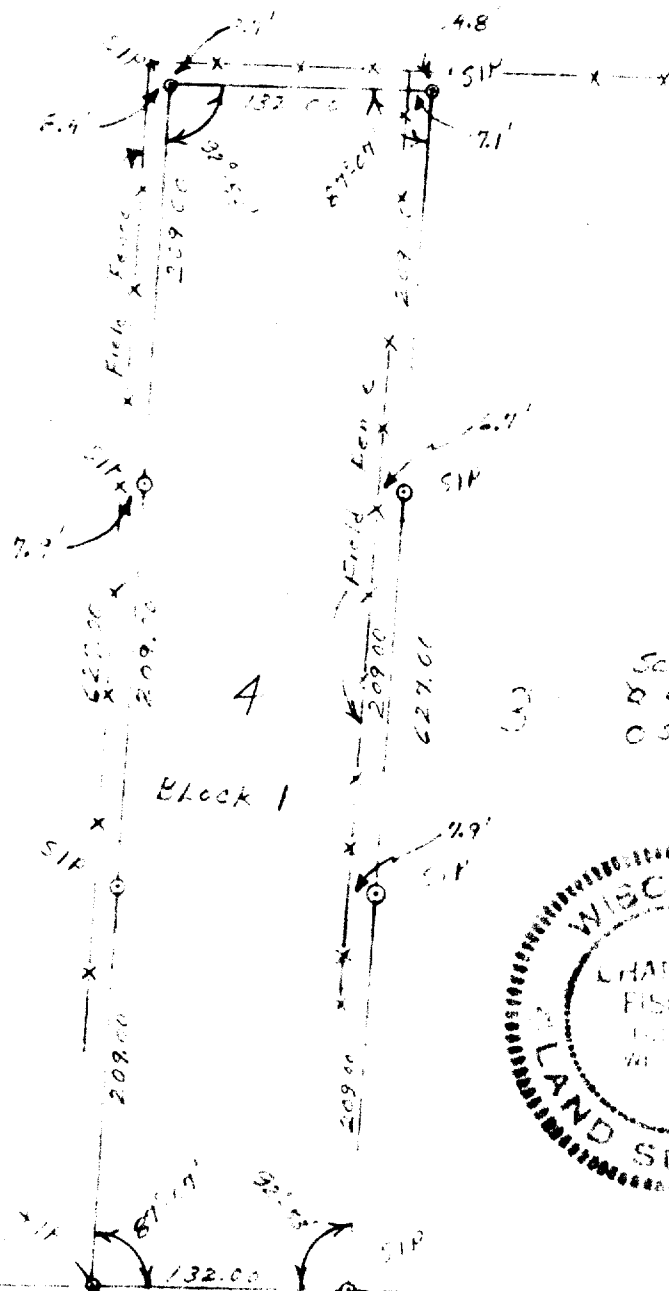

SCALE 1"=100'
X SIP - IRON PIPE
O SIP - SET IRON PIPE

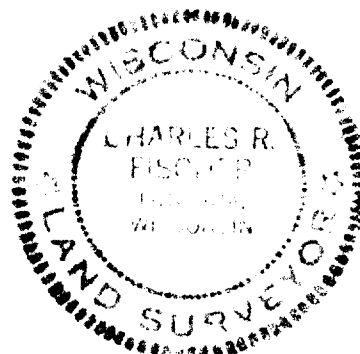

SE CORNER
SECTION 25-1-15

SE CORNER
SECTION 25-1-15

E. Col. Hwy W
SCHOOL SITE 66' R-C-W

I HEREBY CERTIFY THAT WE HAVE SURVEYED THE LANDS DESCRIBED
ABOVE ACCORDING TO OFFICIAL RECORDS AND THAT THE PLAT
DRAWN HEREON IS A CORRECT REPRESENTATION OF SAID SURVEY.

WIS. REG. LAND SURVEYOR

DATE 5/21/70

8-33

JOB NO. 700076

12 A-11