


ABELL SURVEYING & MAPPING

1140 SEQUOIA STREET • DELAVAN, WISCONSIN 53115
262-728-6737

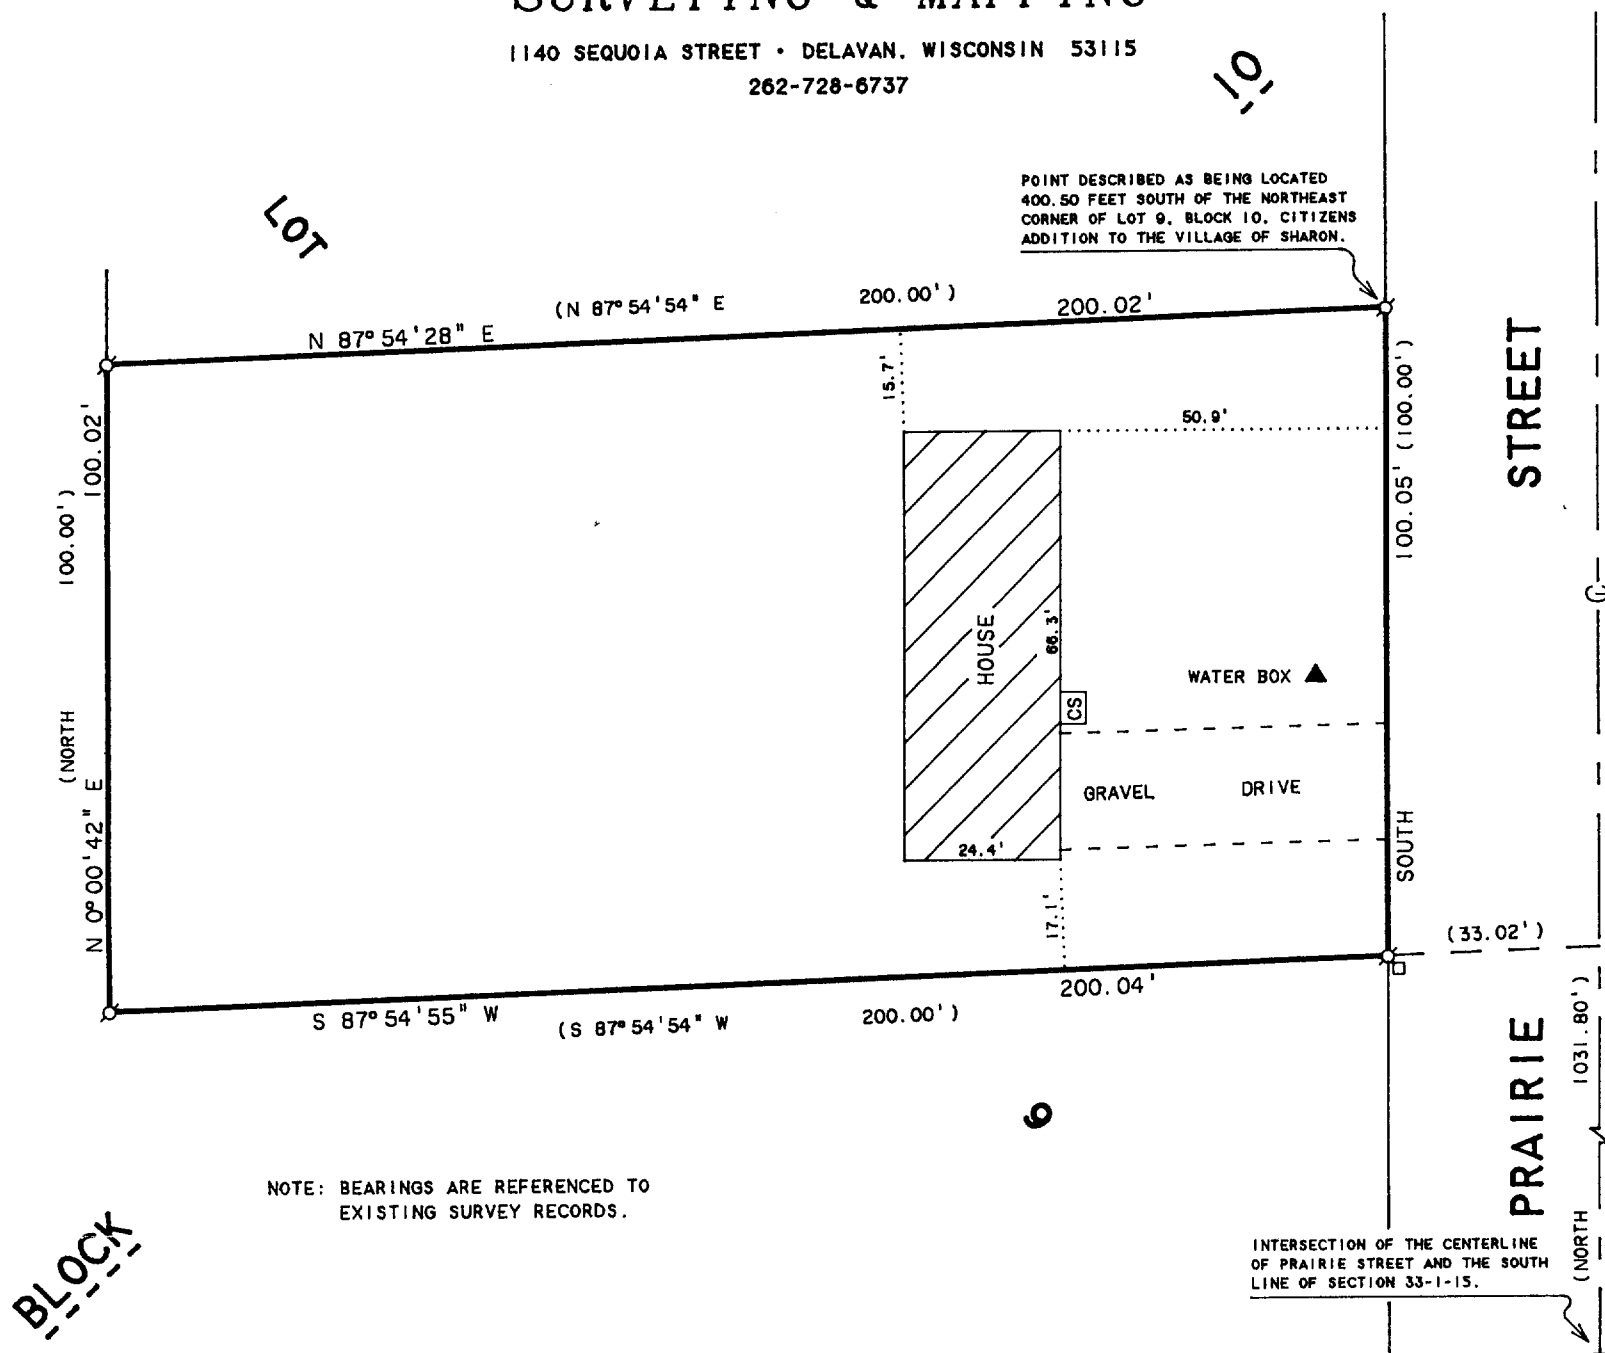

PLAT OF SURVEY OF

A part of Lot 9 in Block 10 of Citizens Addition to the Village of Sharon, Walworth County, Wisconsin, Described as follows: Commencing at the intersection of the Centerline of Prairie Street and the South line of Section 33, T1N, R15E, thence North along the center line of said Prairie Street 1031.80 feet; thence S 87° 54' 54" W 33.02 feet to the West line of Prairie Street and the place of beginning; thence continue S 87° 54' 54" W 200.00 feet; thence North 100.00 feet; thence N 87° 54' 54" E 200.00 feet to a point on the West line of Prairie Street described as being located 400.50 feet South of the Northeast corner of said Lot 9; thence South 100.00 feet to the place of beginning.

N



SCALE 1"=30'


LEGEND

- - IRON PIPE FOUND
- CS - CONCRETE STOOP
- - UTILITY PED.
- () - RECORDED AS

ORDERED BY: ANCHOR SAVINGS & LOAN
P.O. BOX 997
LAKE GENEVA, WI. 53147

REVISED AND RECERTIFIED: AUGUST 1, 2000
ORDERED BY: RE/MAX GENEVA REALTY, LTD.
101 BROAD STREET
LAKE GENEVA, WI 53147

FOR: M & I BANK C/O ODGEN
ATTN: SHEILA SANDERS
1665 N. WATER STREET
P.O. BOX 510800
MILWAUKEE, WI 53203

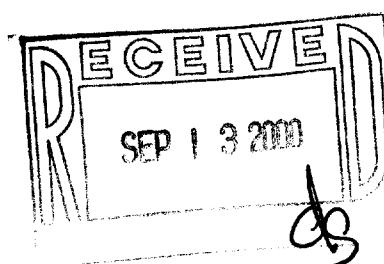

I HEREBY CERTIFY THAT I HAVE SURVEYED THE ABOVE DESCRIBED PROPERTY AND THAT THE ABOVE MAP IS A TRUE REPRESENTATION THEREOF AND SHOWS THE SIZE AND LOCATION OF THE PROPERTY, ITS EXTERIOR BOUNDARIES, THE LOCATION OF ALL VISIBLE STRUCTURES AND DIMENSIONS OF ALL PRINCIPAL BUILDINGS THEREON, BOUNDARY FENCES, APPARENT EASEMENTS, ROADWAYS AND VISIBLE ENCROACHMENTS, IF ANY, TO THE BEST OF MY KNOWLEDGE AND BELIEF.

THIS SURVEY IS MADE FOR THE USE OF THE PRESENT OWNERS OF THE PROPERTY, AND ALSO THOSE WHO PURCHASE, MORTGAGE, OR GUARANTEE THE TITLE THERETO WITHIN ONE (1) YEAR FROM DATE HEREON.

David F. Abell

DAVID F. ABELL
WISCONSIN REGISTERED LAND SURVEYOR, S-1596

August 4, 1992

DATE: August 4, 1992 JOB NUMBER - 92143A
NOTE: THIS IS NOT A CERTIFIED COPY UNLESS SEALED.

UCA-192B

008-345