

ROBERS & FISCHER, INC.

CONSULTING ENGINEERS & LAND SURVEYORS

PHONE (414) 763-2652

116 E. CHESTNUT ST.

BURLINGTON, WIS. 53105

Part of Survey

48


Lot 11, Block 3, Division's Addition
to the Village of Sharon, Walworth
County, Wisconsin.



— LEGEND —

○ IRON PIPE

SCALE 1" = 60'

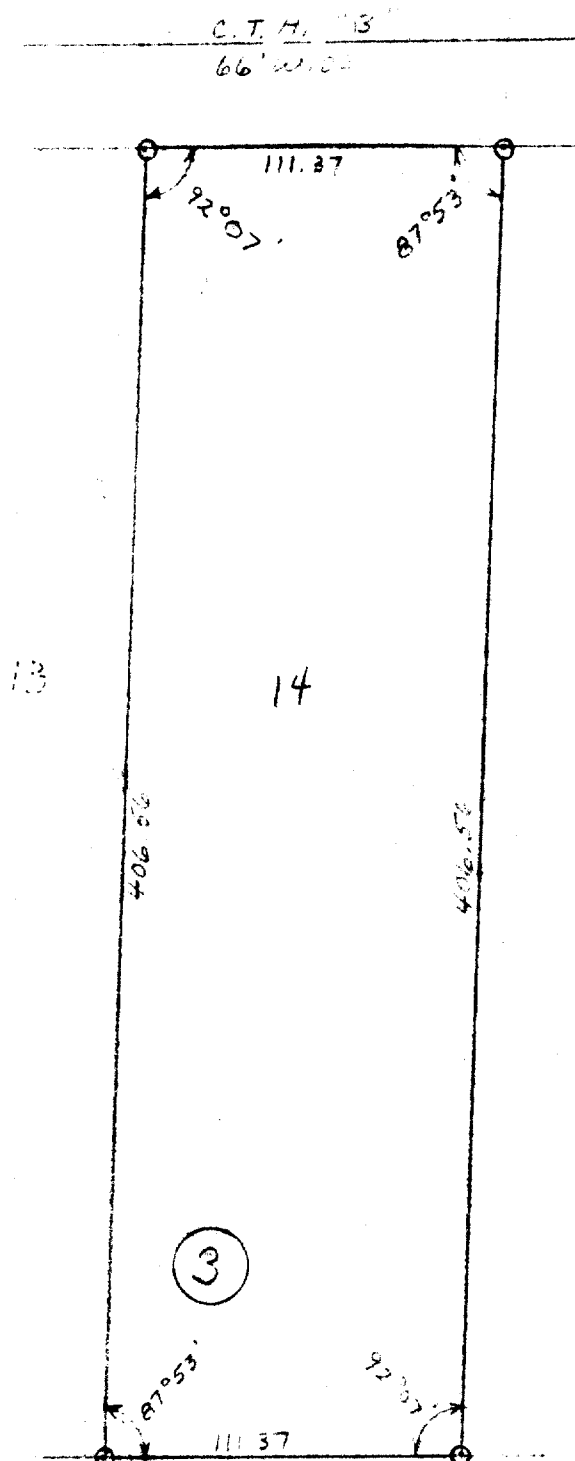

I HEREBY CERTIFY THAT WE HAVE SURVEYED THE LANDS DESCRIBED
ABOVE ACCORDING TO OFFICIAL RECORDS AND THAT THE PLAT
DRAWN HEREON IS A CORRECT REPRESENTATION OF SAID SURVEY.

Charles R. Fischer
WIS. REG. LAND SURVEYOR 5-821

DATE 7-17-70

8-35

JOB NO. 70099-A

UCA-38