


CHURCH STREET

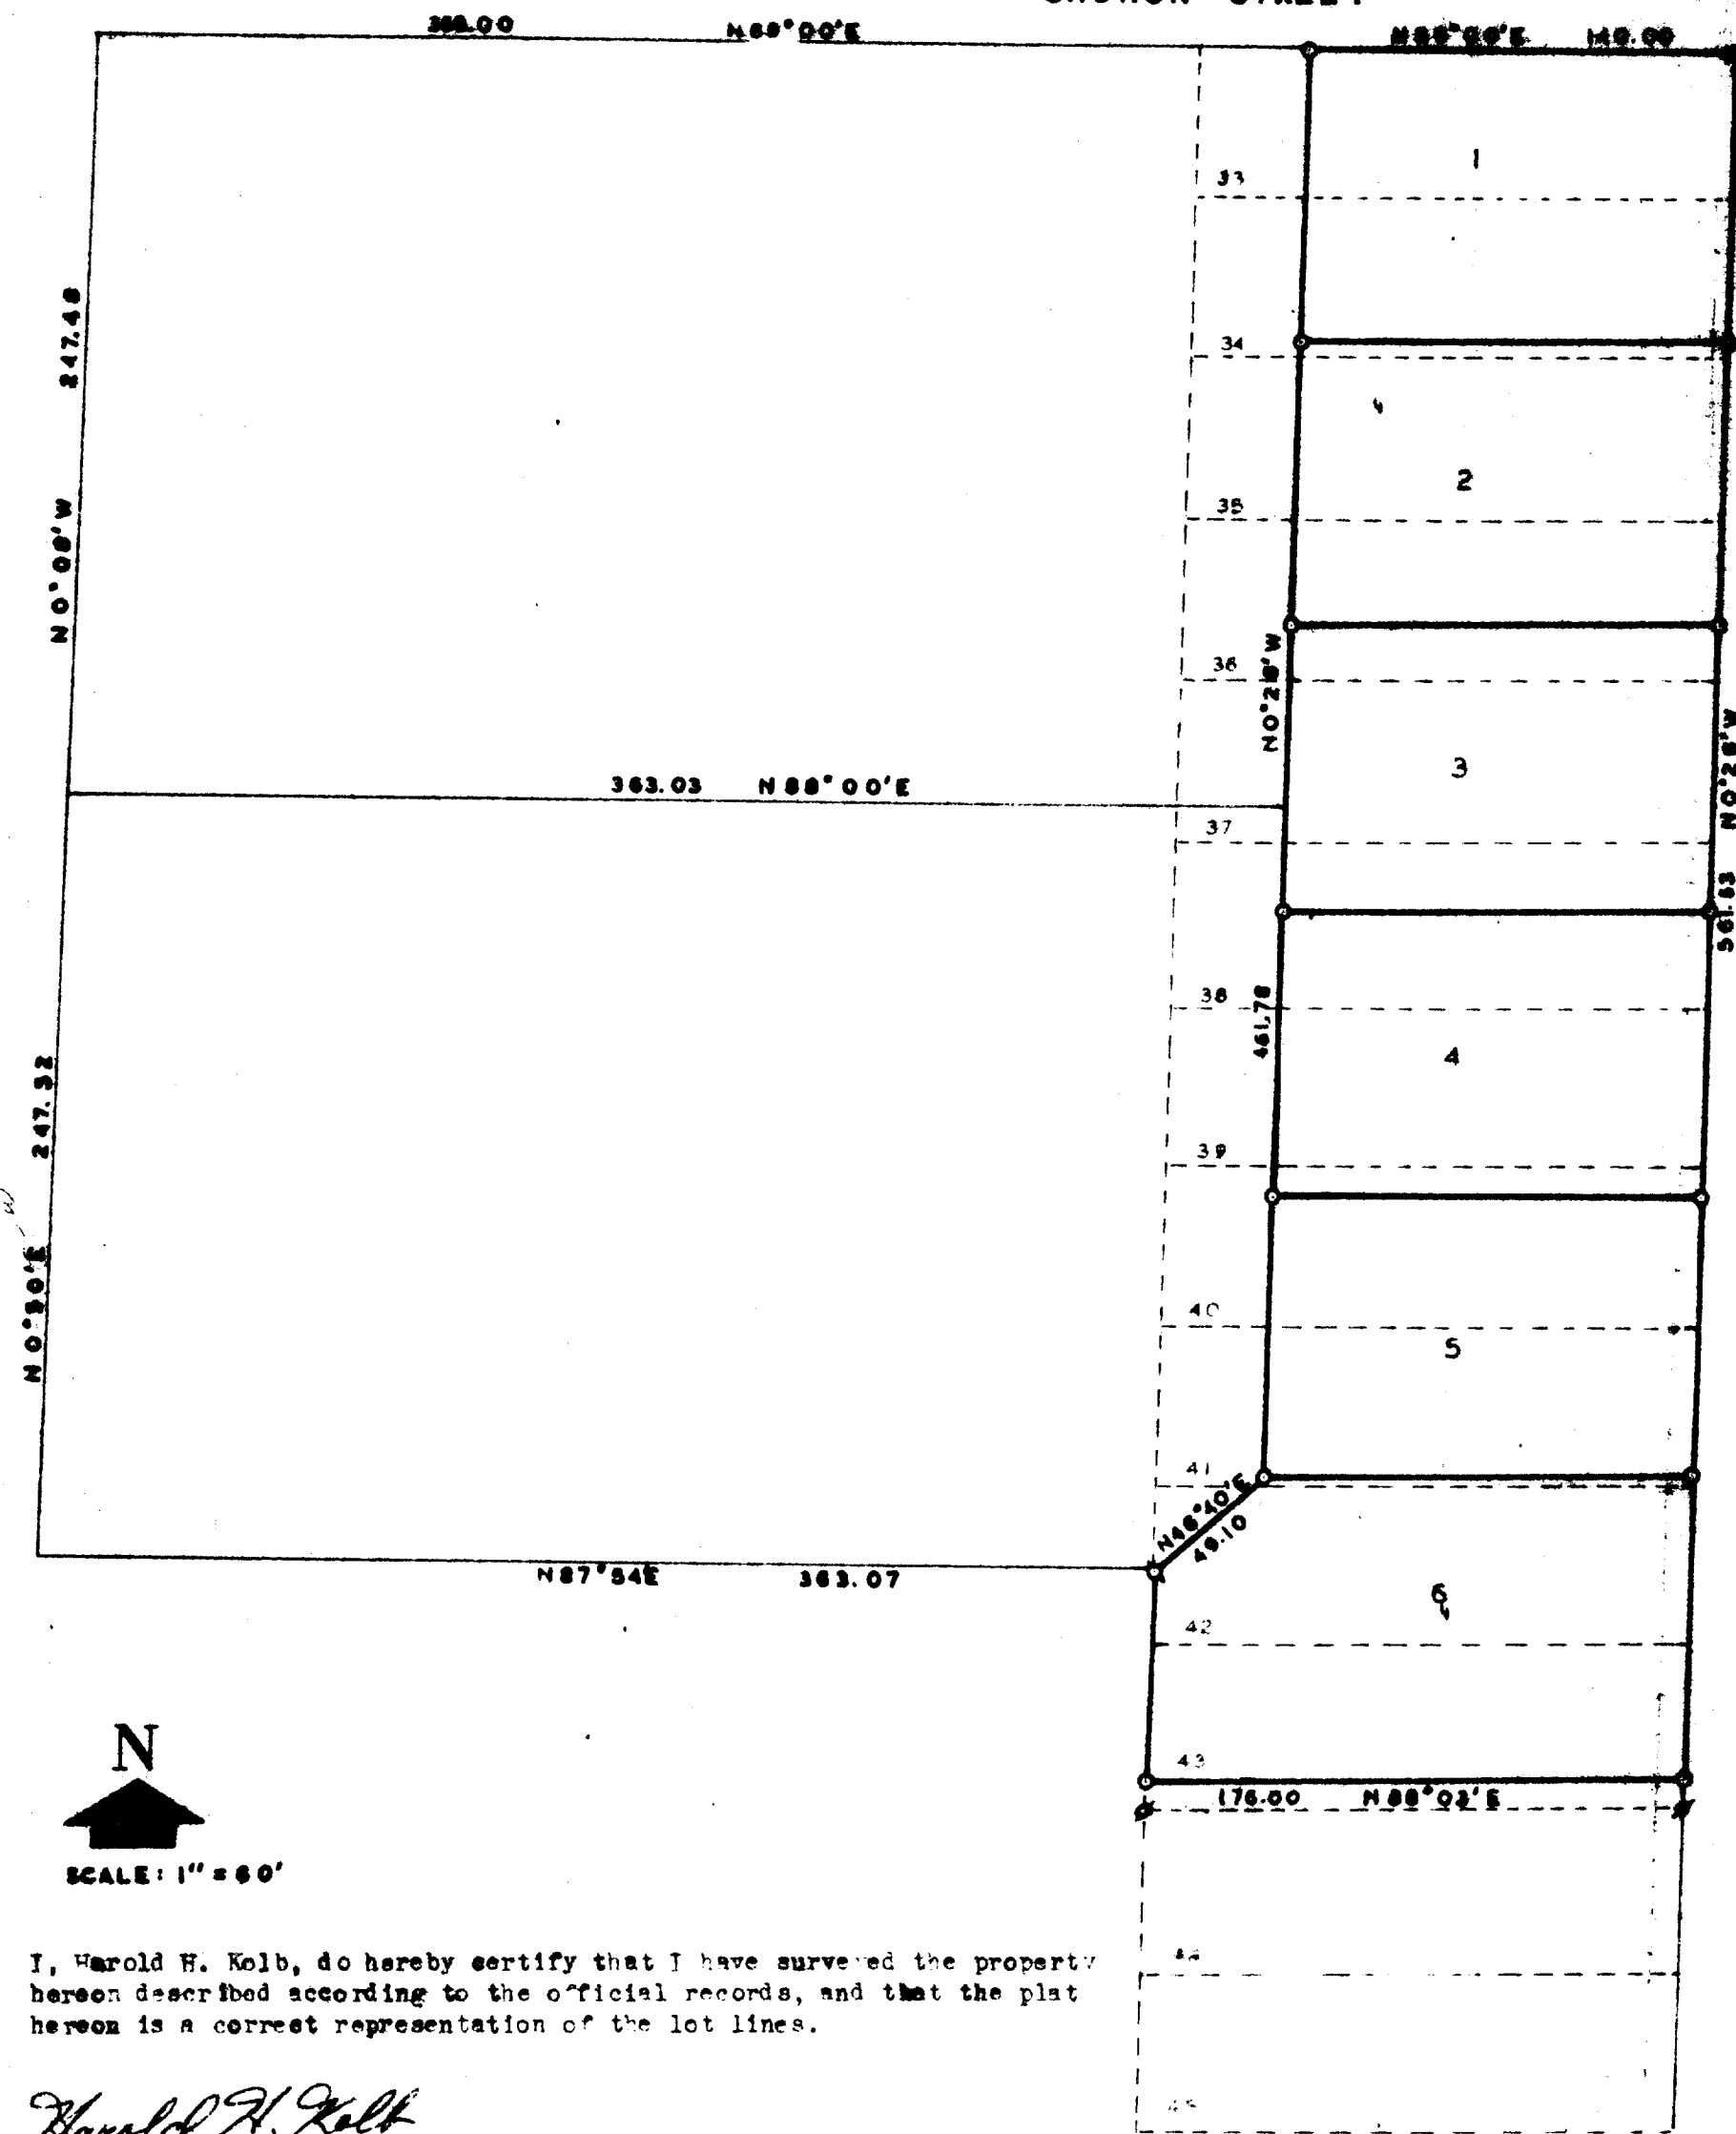

I, Harold H. Kolb, do hereby certify that I have surveyed the property hereon described according to the official records, and that the plat hereon is a correct representation of the lot lines.

Harold H. Kolb

Harold H. Kolb
Wisconsin Registered Land Surveyor, S-187
Date Aug 29, 1967

CENTER STREET

