


DUNHAM SURVEYING, S.C.
SURVEYING & SUBDIVIDING
DELAVER, WISCONSIN 53115

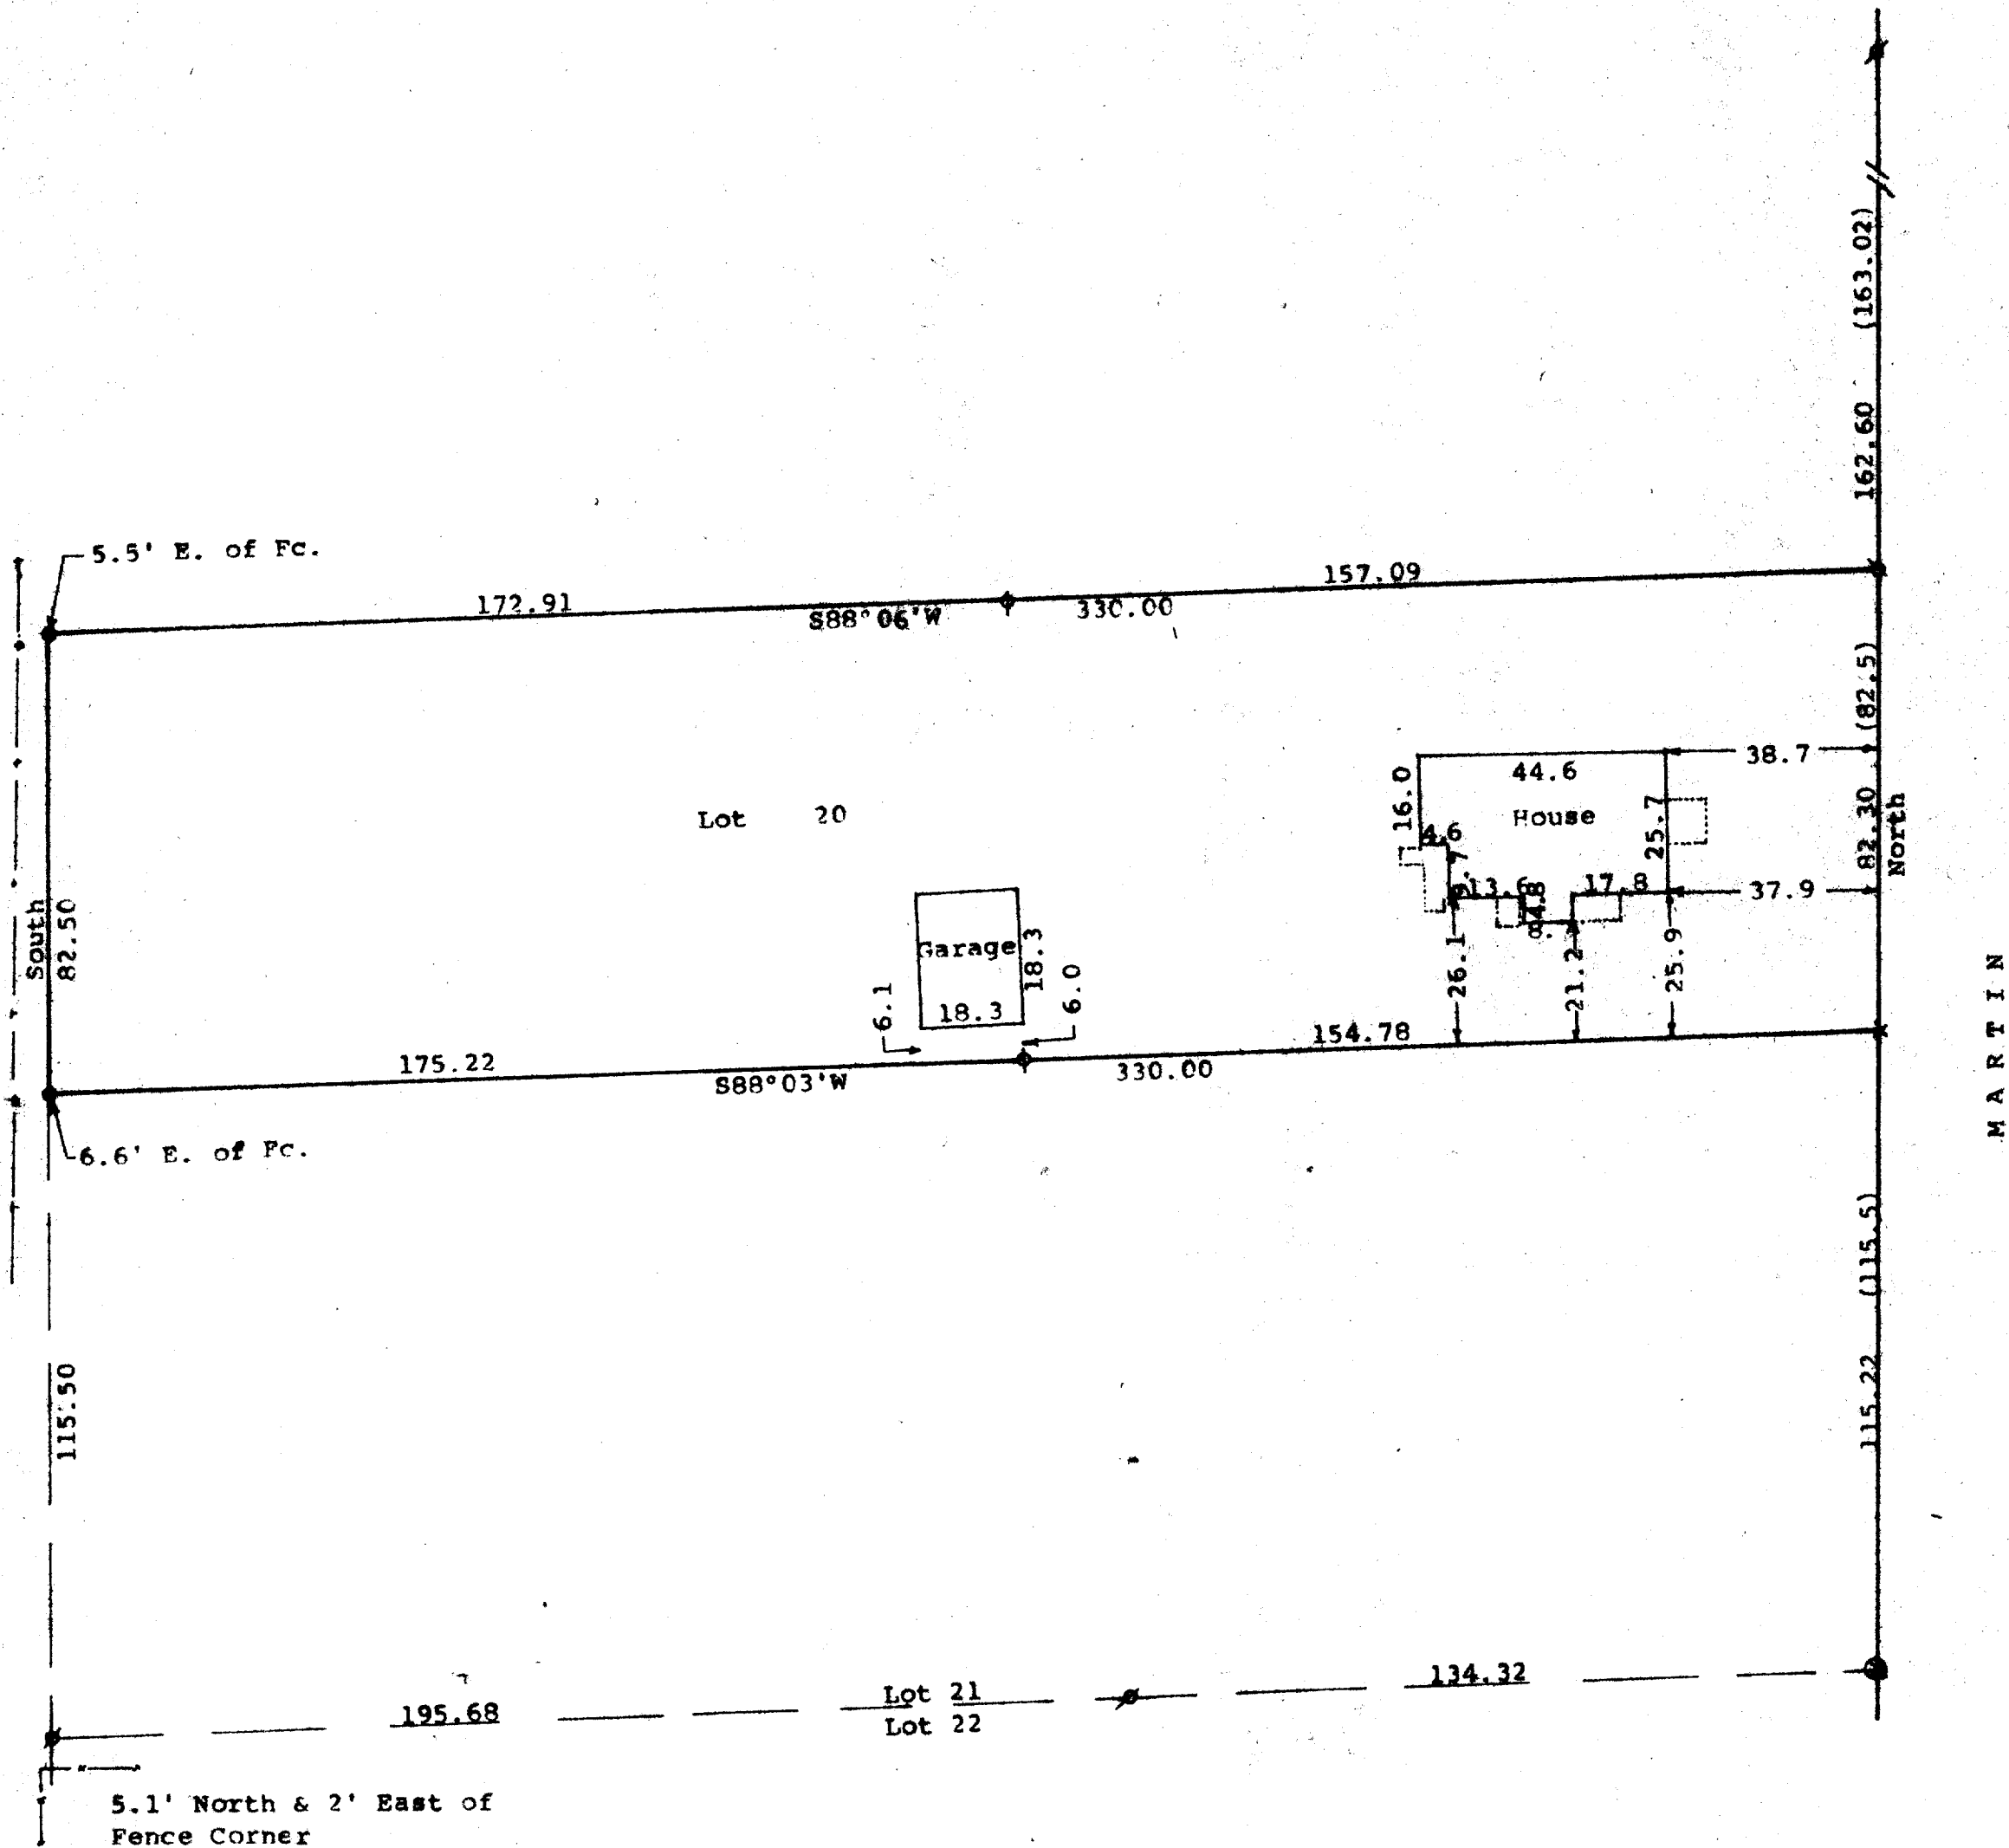


STATE OF WISCONSIN)
COUNTY OF WALWORTH) SS.

I, George T. Dunham, Surveyor, Surveyor, certify that I have surveyed the property described as follows:

Lot 20 in Block 9 of Citizens Addition to the Village of Sharon, Walworth County, Wisconsin

and that the plat shown hereon is a correct representation thereof and shows the size and location of the property, its exterior boundaries, the location of all visible structures and dimensions of all principal buildings thereon, boundary fences, apparent easements, roadways and visible encroachments, if any, and that I have surveyed the property hereon described, according to the official records, to the best of my knowledge and belief.
November 25, 1996

George T. Dunham
George T. Dunham, Surveyor

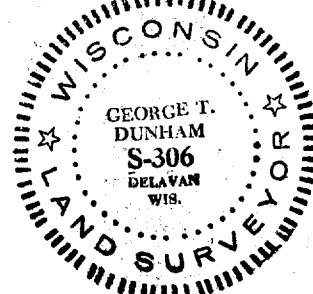

Scale - 1" = 30'
⊗ = Found cross in Con.
x = Cut cross in Conc.
Ø = 3/4" Iron Pipe
Found
⊗ = 3/4" Iron Pipe Set
● = 1" Iron Pipe Set
⊕ = 1/2" Iron Pipe Set
Bearings reference to the west line of Martin Street with the assumed bearing of North.
Survey ordered by:
The Rauland Agency
118 Kenosha Street
Walworth, WI 53184
--- = Fence Line
(0.00) = recorded distance

