


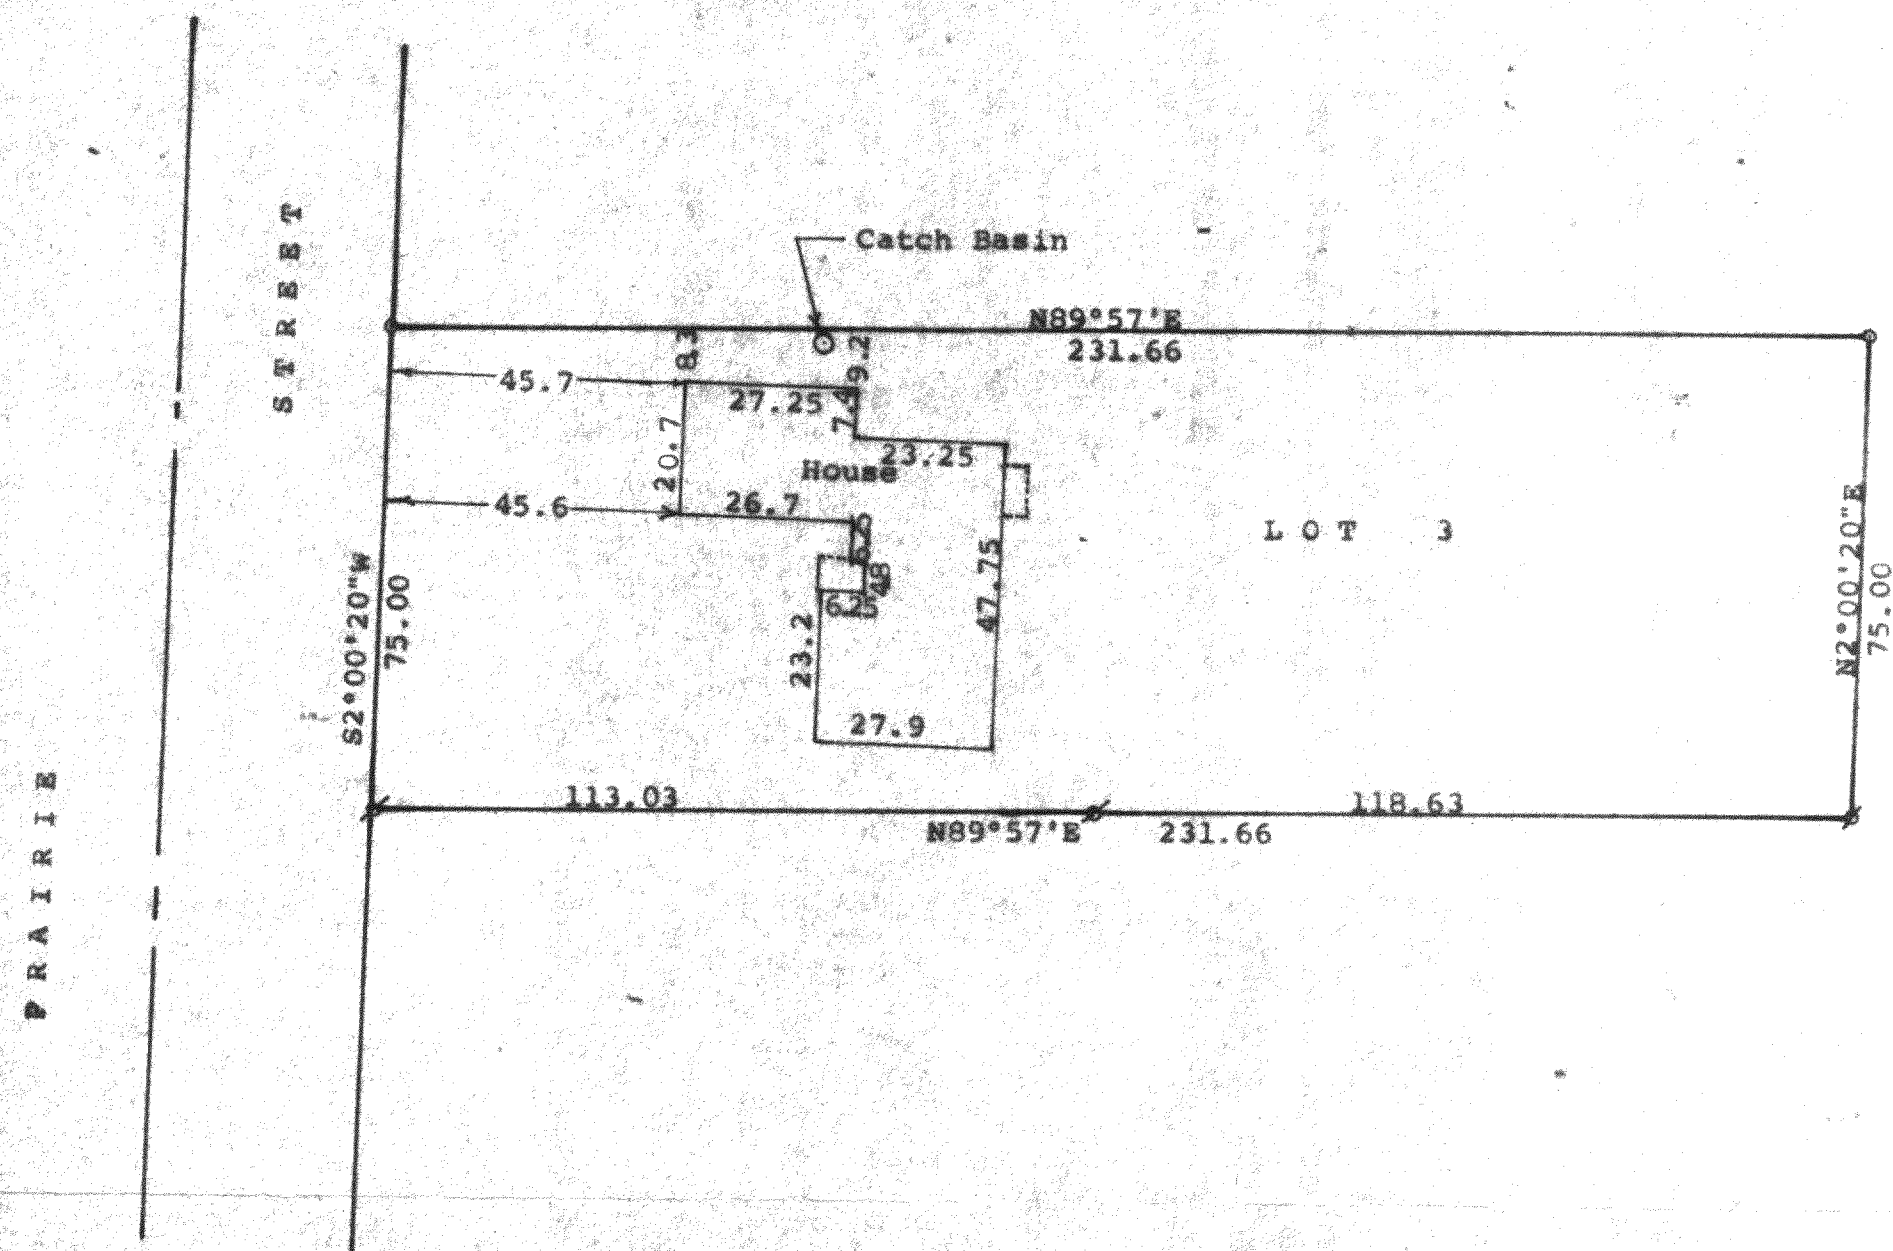

Scale - 1" = 30'
 o = 1" Iron Pipe Found
 ø = 3/4" Iron Pipe Found
 Survey ordered by: Don Paulson
 162 Prairie Street
 Sharon, WI 53585
 Bearings are those on the recorded plat
 of Certified Survey No. 2465

George D. Dunham
George D. Dunham, Surveyor

