


GEORGE T. DUNHAM
SURVEYING & SUBDIVIDING
DELAVAN, WISCONSIN

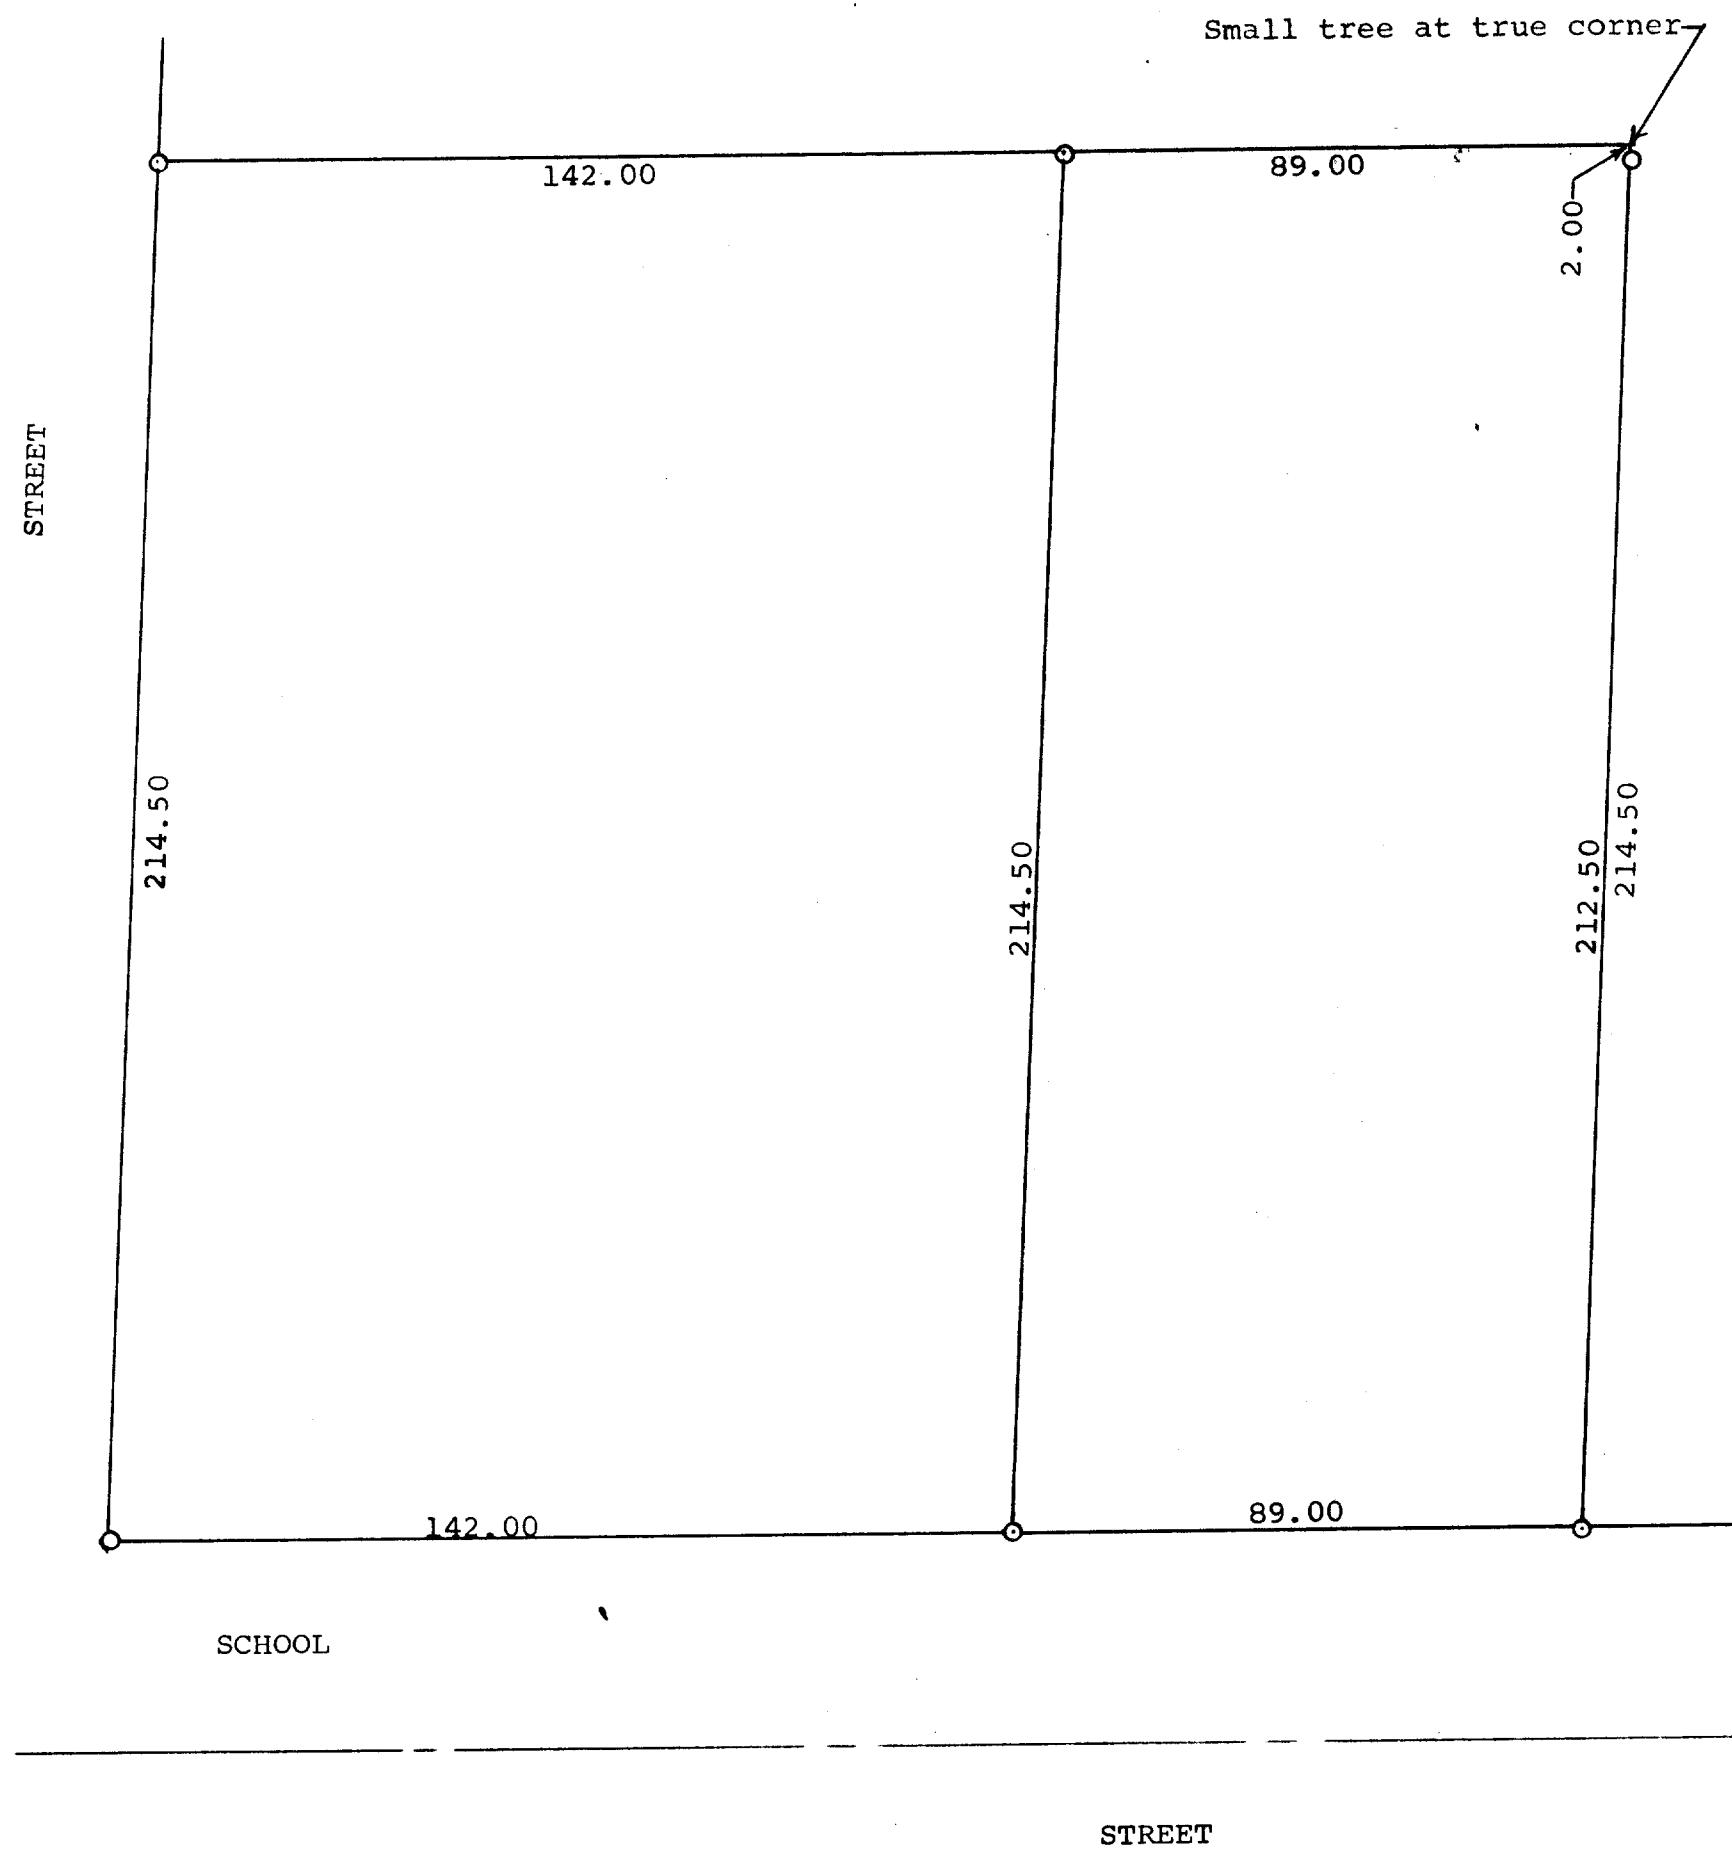

Plat of survey of part of Lot 2, Block 2 of Citizens Addition to
the Village of Sharon, Walworth County, Wisconsin.
September 21, 1970

George T. Dunham
George T. Dunham, Surveyor