

PLAT OF SURVEY
-OF-

LOT 1 OF CERTIFIED SURVEY MAP NO. 3359,
BEING A REDIVISION OF PART OF LOT 30 OF BLOCK
9 OF CITIZENS ADDITION - SOUTH SIDE, LOCATED
IN PART OF THE SOUTHEAST 1/4 OF THE SOUTH-
WEST 1/4 OF SECTION 33, TOWN 1 NORTH, RANGE
15 EAST, VILLAGE OF SHARON, WALWORTH COUNTY,
WISCONSIN.

SURVEY FOR: SOUTHEASTERN WISCONSIN HOUSING CORP.

SURVEY ADDRESS: 162 PRAIRIE STREET

I HEREBY CERTIFY THAT THE EXISTING DWELLING (UNDER
CONSTRUCTION) SHOWN ON THIS PLAT OF SURVEY IS
LOCATED AS SHOWN THUS (), DATED THIS 19TH DAY
OF AUGUST, 2003.


Robert J. Wetzel
ROBERT J. WETZEL S-1778

SCALE:

1" = 30'


"I hereby certify that I have surveyed the above described
property and that the above map is a correct representation thereof
and shows the size and location of the property, its exterior
boundaries, the location of all visible structures and dimensions
of all principal buildings thereon, boundary fences, apparent
easements, roadways and encroachments, if any."

"This survey is made for the use of the present owners of the
property, and those who purchase, mortgage, or guarantee the
title thereto within one year from date hereof."


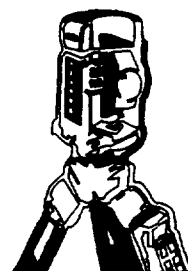


B.W. SURVEYING, INC.

LAND SURVEYS
MAPPING AND PLANNING
412 N. PINE STREET
BURLINGTON, WI 53105
(262)-767-0225

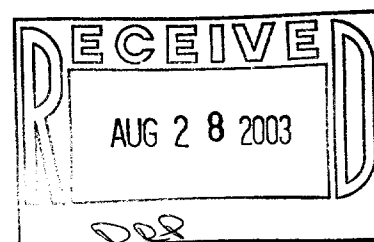

PRAIRIE STREET

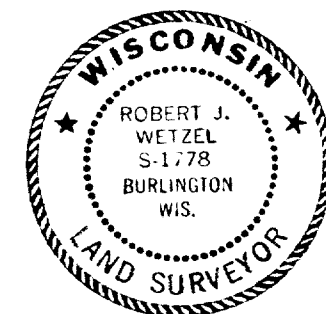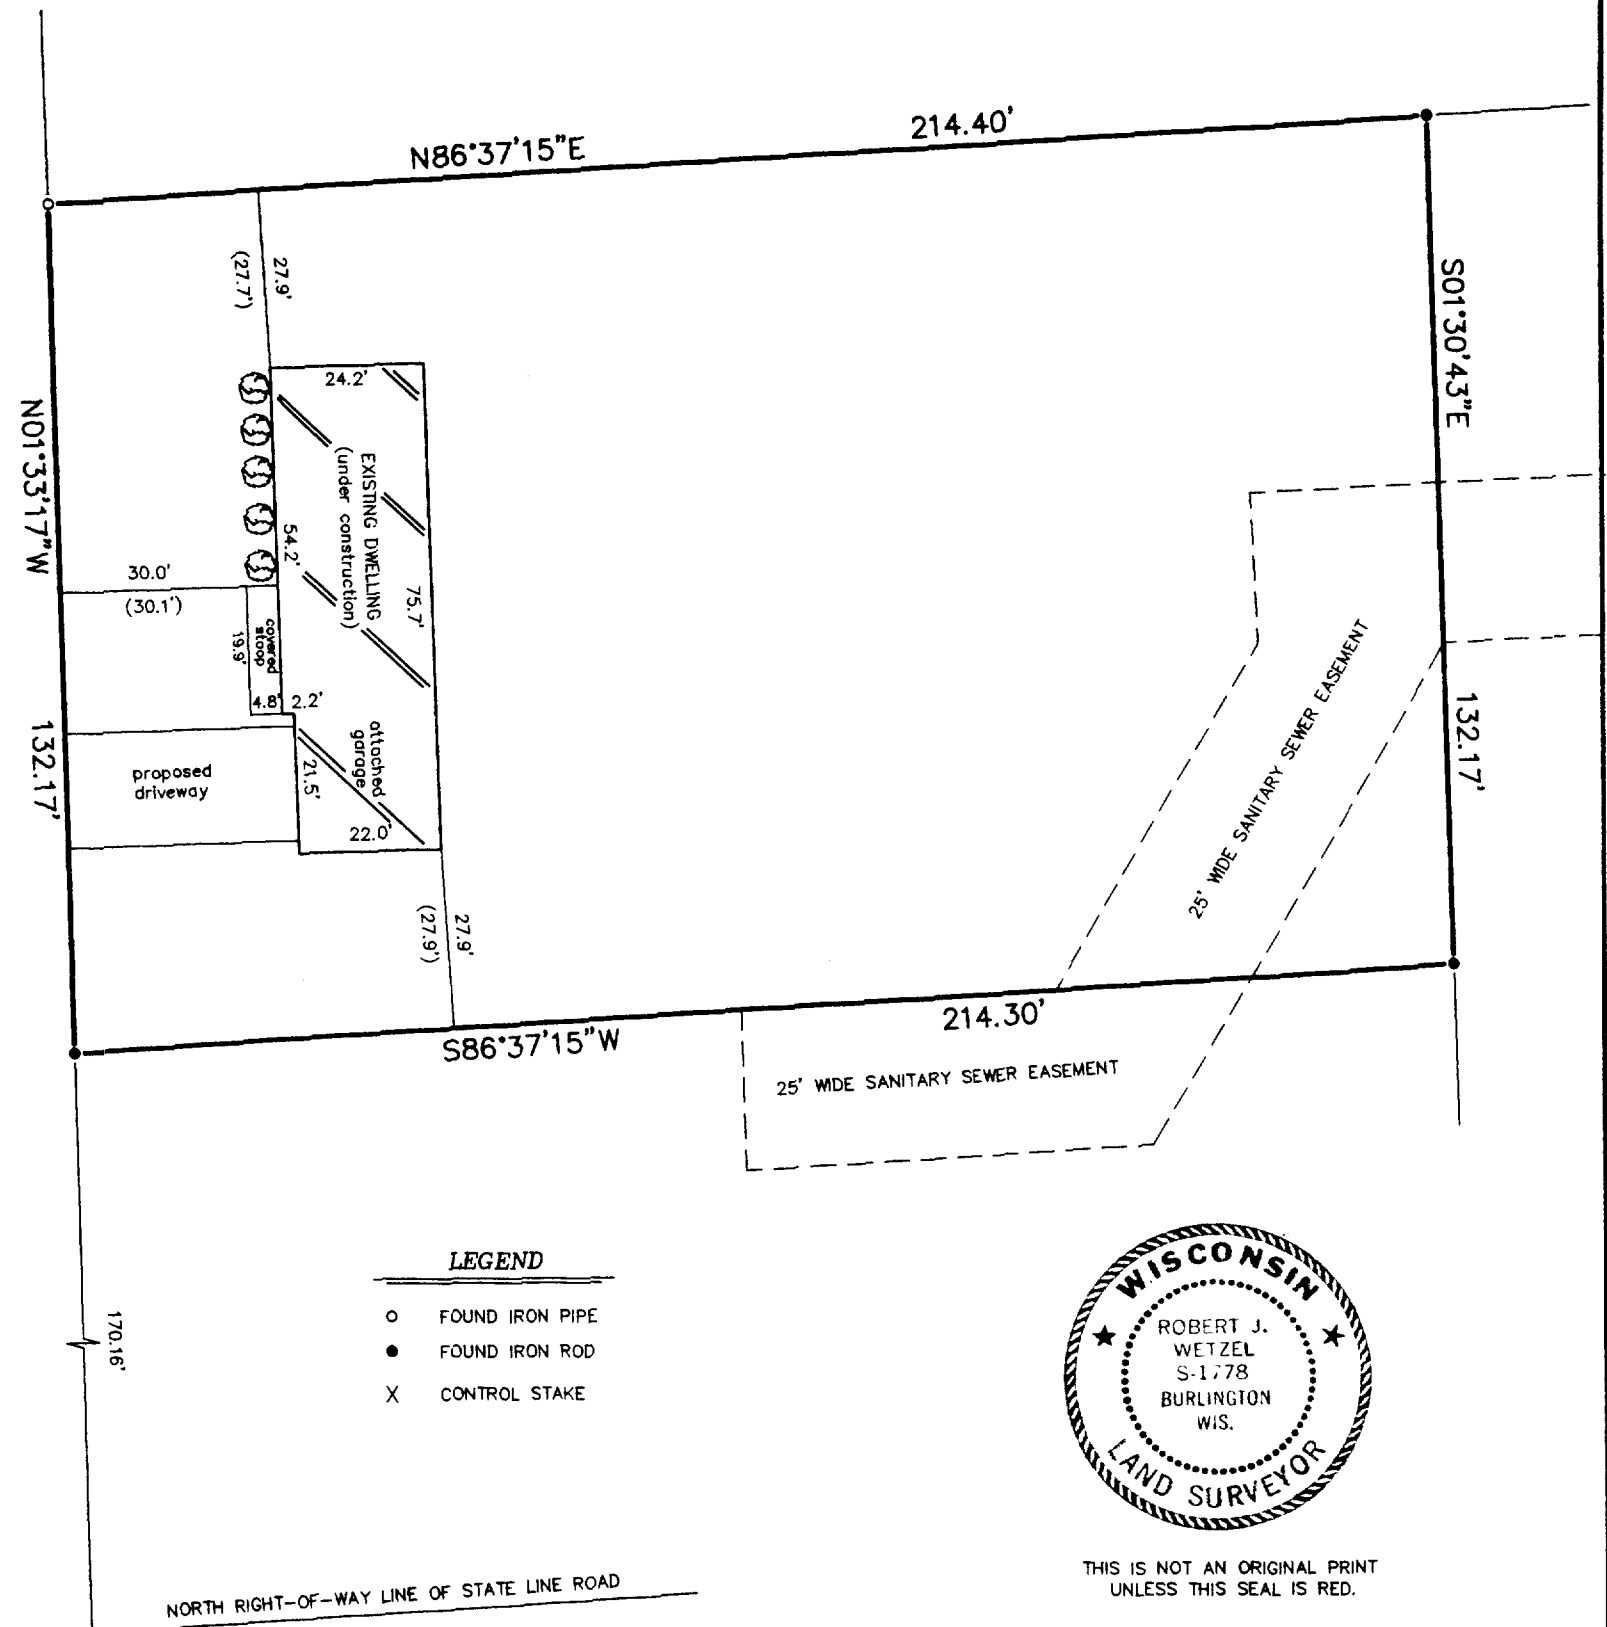

THIS IS NOT AN ORIGINAL PRINT
UNLESS THIS SEAL IS RED.

Robert J. Wetzel
ROBERT J. WETZEL S-1778
JULY 3, 2003 5903
DATE JOB NUMBER

UA3359-1

008-382