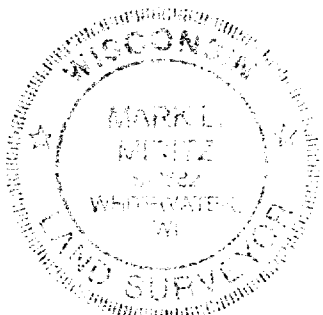
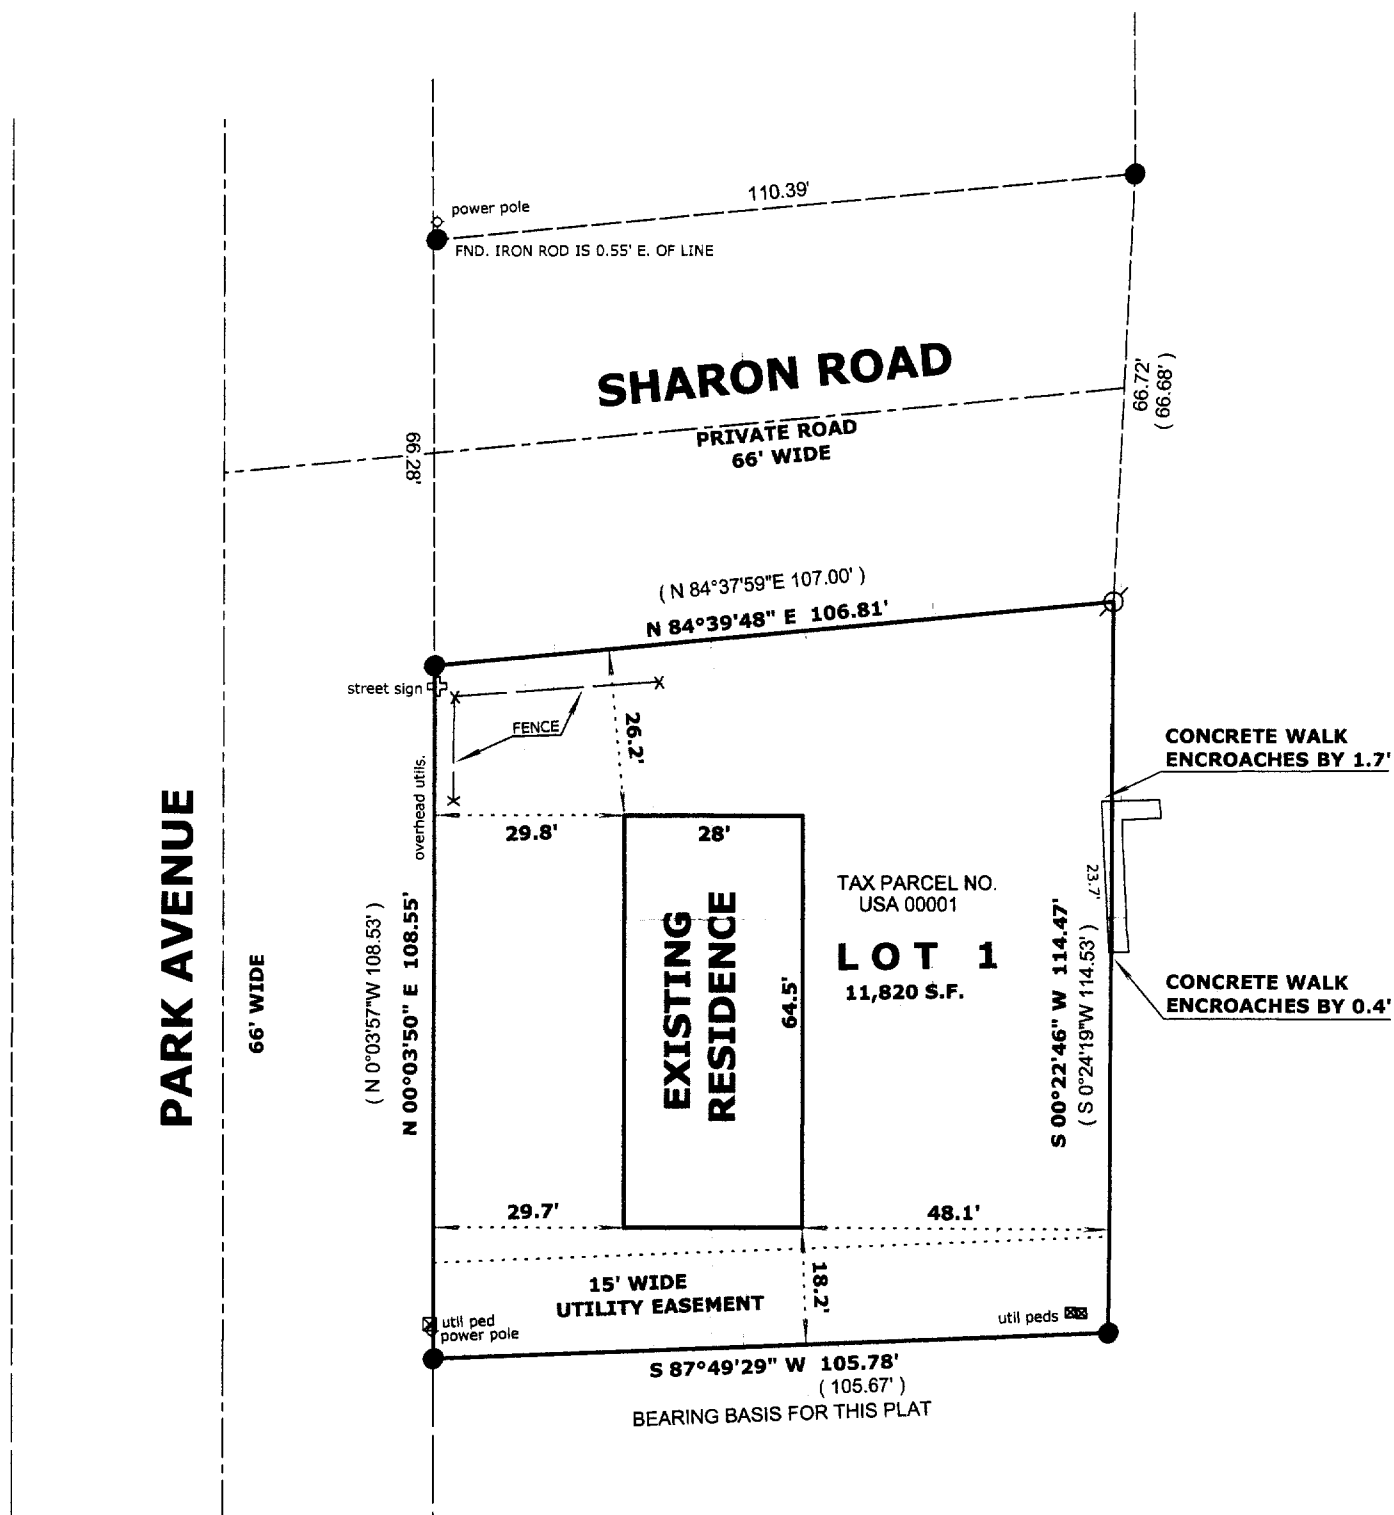


LAND-MARK SURVEYING**Mark L. Miritz**

Wisconsin Registered Land Surveyor S-2582

N9330 Knuteson Drive
Whitewater, WI 53190
Phone: (262) 495-3284
FAX : (262) 495-8421
LAND-MARKSURVEYING.COM**PLAT OF SURVEY****LOT 1 OF SHARON EAST SUBDIVISION,
LOCATED IN THE NORTHEAST 1/4 OF
SECTION 33, TOWN 1 NORTH, RANGE
15 EAST, VILLAGE OF SHARON,
WALWORTH COUNTY, WISCONSIN.****OWNERS: RICHARD and NICOLETTE CEISEL
N2447 SHADY SIDE DR.
LAKE GENEVA, WI. 53147**

NOV 17

SMF

"I hereby certify that the above described property has been surveyed by me or under my direction and that the above map is a true representation thereof and shows the size and location of the property, its exterior boundaries, the location of all visible structures and dimensions of all principal buildings thereon, boundary fences, apparent easements, roadways and visible encroachments, if any."

"This survey is made for the use of the present owners of the property, and also those who purchase, mortgage, or guarantee the title thereto within one year from date hereof."

**MARK L. MIRITZ
WISCONSIN REGISTERED
LAND SURVEYOR S-2582**

REVISED OCT. 19, 2005 TO SHOW RESIDENCE "AS BUILT"

DATE: JUNE 16, 2005 JOB NO. 05.610

USA-1

008-415