
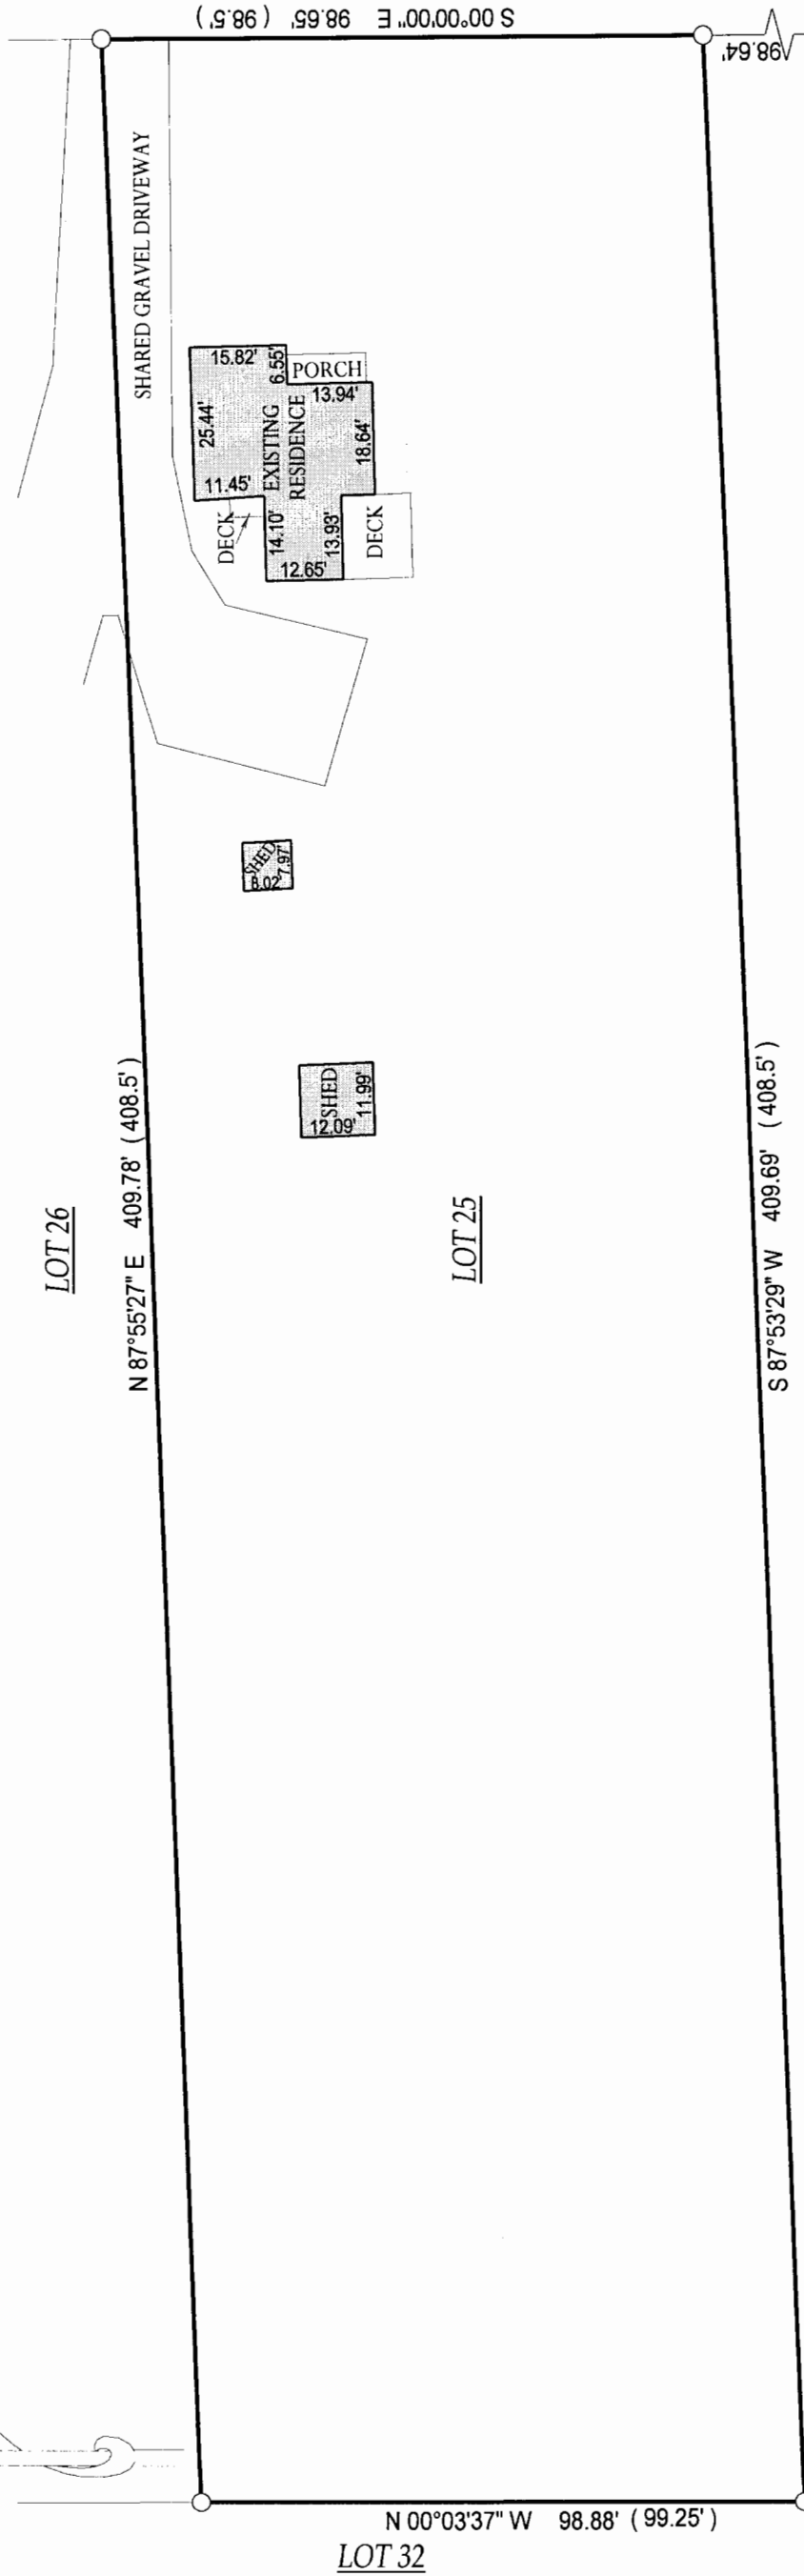


PREPARED FOR:
CHERYL HANSEN
REMAX GENEVA
101 BROAD ST, SUITE 102
LAKE GENEVA, WI 53147

PLAT OF SURVEY
-OF-
LOT 25, BLOCK 4, OF CITIZENS
ADDITION TO THE VILLAGE OF SHARON,
WALWORTH COUNTY, WISCONSIN.

PATHFINDER SURVEYING INC.
W2888 KRUEGER ROAD, UNIT "D"
LAKE GENEVA, WI, 53147
262-248-3697

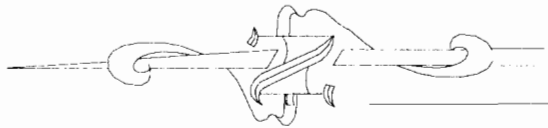

- () = RECORDED AS
□ = FOUND IRON BAR
○ = FOUND IRON PIPE
● = SET IRON PIPE
■ = SET IRON BAR

SCALE: 1" = 30'

JOB #: 06-264

TAX ID #: UCA 00069

COMPARE LEGAL DESCRIPTION ABOVE AND DRAWING WITH DEED. FOR BUILDING RESTRICTIONS AND EASEMENTS NOT SHOWN REFER TO DEED, ABSTRACT SOURCES AND LOCAL MUNICIPAL CODES. NOTIFY THE SURVEYOR IMMEDIATELY OF ANY DISCREPANCY.


"I hereby certify that the above described property was surveyed under my supervision and that the above map, to the best of my knowledge and belief, is a true representation thereof and shows the size and location of all visible structures, apparent easements and encroachments if any." This survey is made for the present owners of the property, and those who purchase, mortgage, or guarantee the title thereto, within one year from the date hereof.

NOTE: BASIS OF BEARING IS MARTIN STREET ASSUMED NORTH-SOUTH.

DATED THE 6th DAY OF JUNE, 2006.

JUL 28 2006

SMF

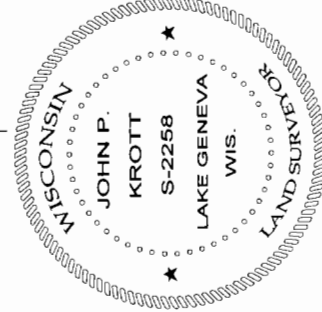

John P. Krott

JOHN KROTT S - 2258
Wisconsin Registered Land Surveyor
(original if signed in red)

008-423