


GEORGE T. DUNHAM
SURVEYING & SUBDIVIDING
DELAVAN, WISCONSIN

SCHOOL

STREET



Scale - 1" = 20'
○ = Iron Pipe

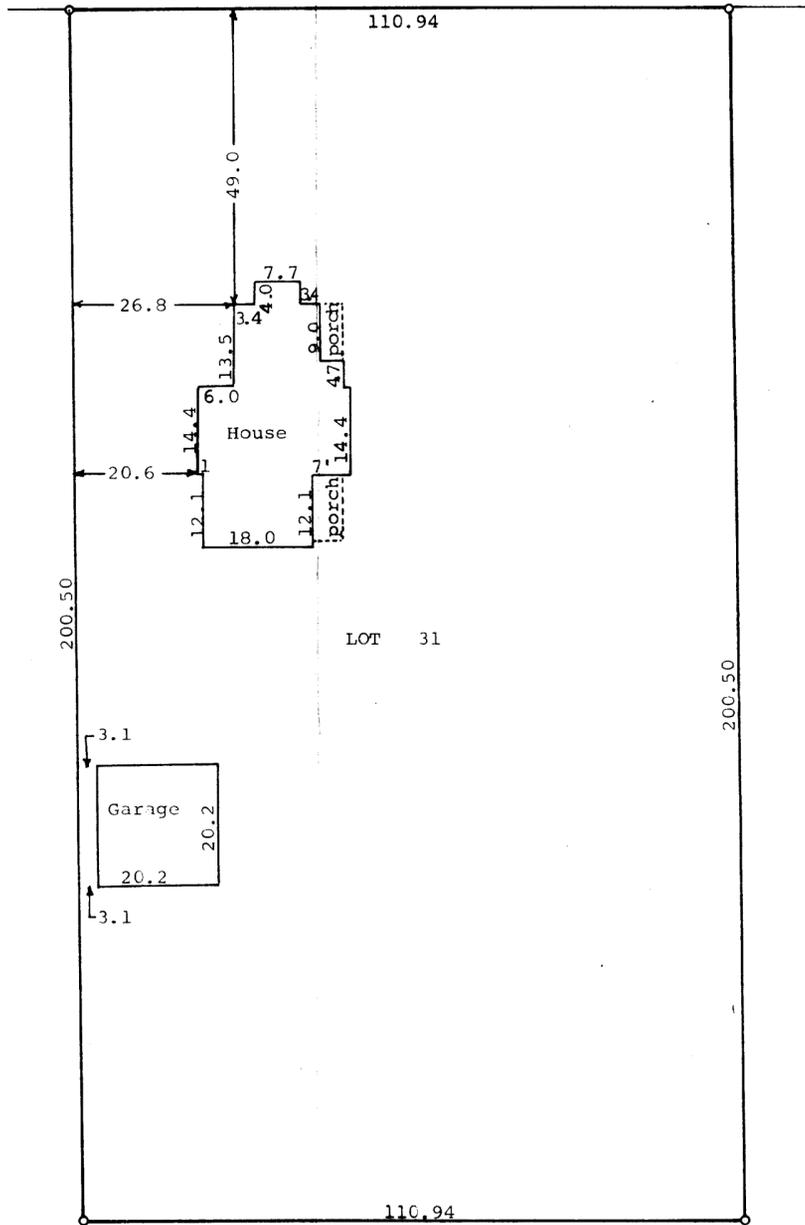

STATE OF WISCONSIN) SS
COUNTY OF WALWORTH) SS
I, George T. Dunham, Surveyor, certify that I have surveyed
the property described as follows,
Lot 31, Block 4, Citizens Addition to the Village of Sharon
as per plat thereof recorded in the Office of the Register of
Deeds in and for the County of Walworth and State of Wisconsin,
and that the above plat is an accurate survey and a true representation
thereof and correctly shows the exterior boundary lines and location of
buildings on said property and the correct measurements thereof.
September 17, 1971

George T. Dunham
George T. Dunham, Surveyor

