


GEORGE T. DUNHAM
SURVEYING & SUBDIVIDING
DELAVAN, WISCONSIN

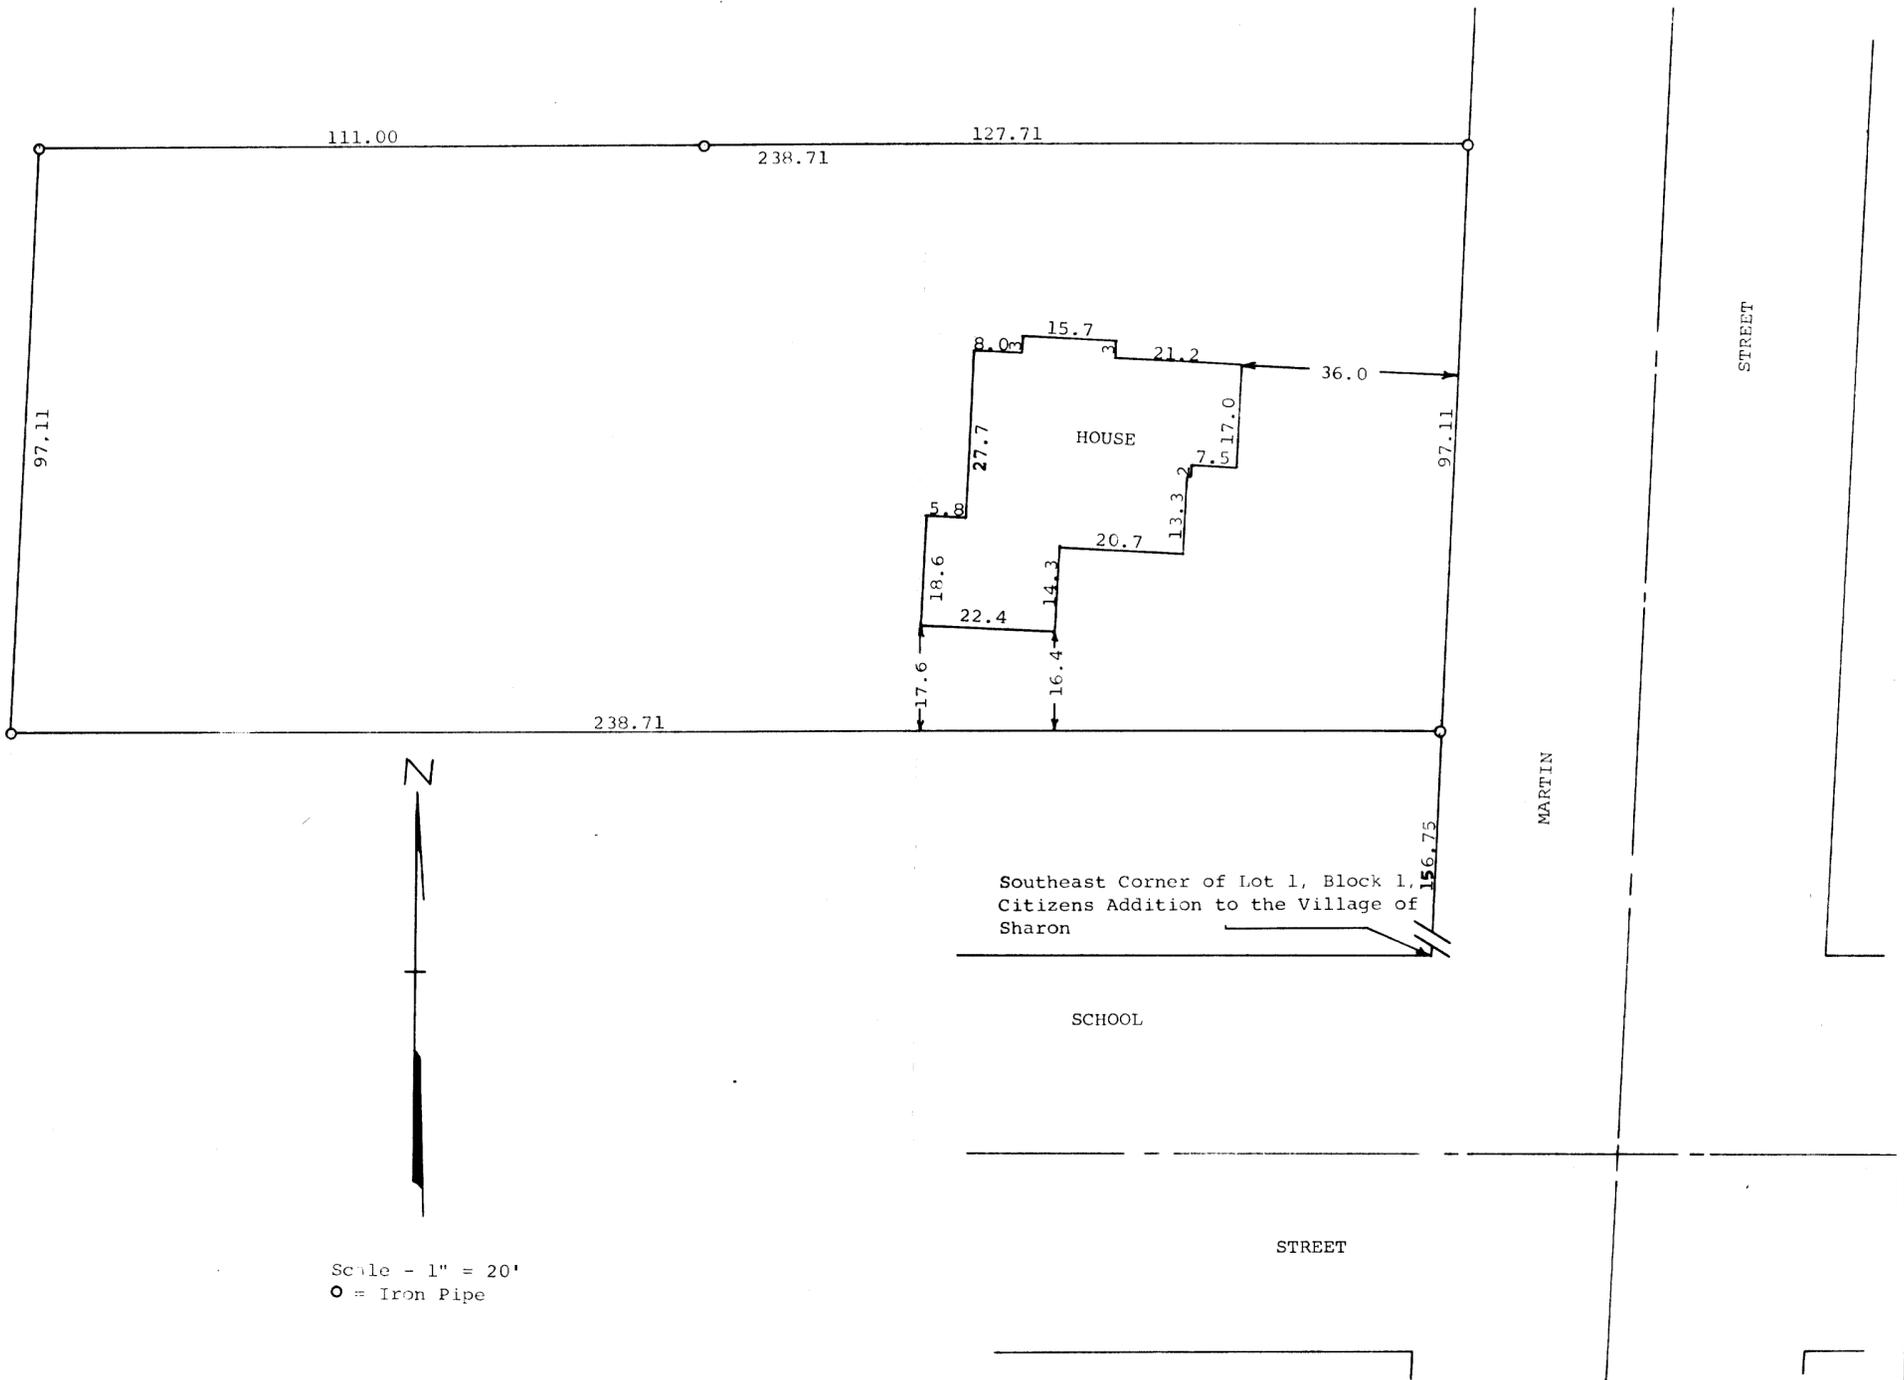

Scale - 1" = 20'
○ = Iron Pipe

STATE OF WISCONSIN) SS
COUNTY OF WALWORTH)

I, George T. Dunham, Surveyor, certify that I have surveyed the property described as follows,

A Parcel of land located in Lot 1, Block 1 of Citizens Addition to the Village of Sharon, Walworth County, Wisconsin, described as follows, to-wit: Commencing at the southeast corner of said Lot 1; thence North along the east line of said lot 156.75 feet to the place of beginning; thence Westerly parallel with the south line of said Lot 1, 238.71 feet to the west line of said Lot 1; thence North along the said west line 97.11 feet; thence Easterly parallel with the south line of said Lot 1, 238.71 feet to the east line of said Lot 1; thence southerly along said east line 97.11 feet to the place of beginning,

and that the above plat is an accurate survey and a true representation thereof and correctly shows the exterior boundary lines and location of buildings on said property and the correct measurements thereof.
July 21, 1971

George T. Dunham
George T. Dunham, Surveyor

