

North 1/4 Corner
Section 35-1-15
N 88°51'31"E 246.53'
E 230°7'48.00"

North line of the Northeast 1/4 of Section 35-1-15
N 88°51'31"E 246.53'


(S 88°51'31" 246.53' State Plane
N 88°51'31"E 246.53'
E 230°7'48.00"

Plat of Survey

of

Lot 1 of Certified Survey Map No. 4490,
recorded in Vol. 29 of Certified Survey Maps of Walworth County on Page 173 and
located in the Northeast 1/4 of Section 32, and the Northwest 1/4 of Section 33,
Town 1 North, Range 15 East, Village of Sharon, Walworth County, Wisconsin.

Surveyed for:
Farm-City Elevator, Inc.
104 Wisconsin Street
Darien, Wisconsin 53114

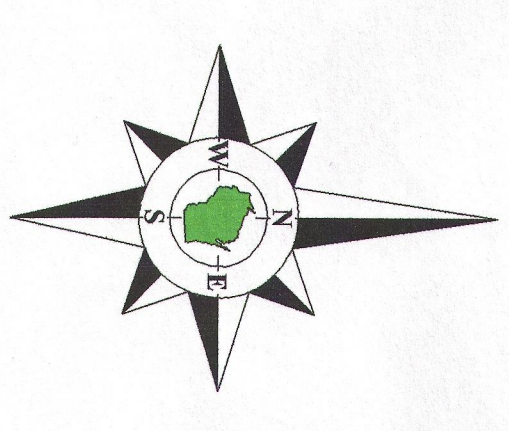

Bearing reference to the Wisconsin State
Plane Coordinate System, South Zone.



Tax Parcel
UWV 00001
Exception
Doc. No. 579746.

Natural Way
Exception Vol. 628, Page
1307, Doc. No. 276589

New Factory Road
(66' Wide)

Railroad R.O.W.
(100' Wide)

Detail
1" = 20'

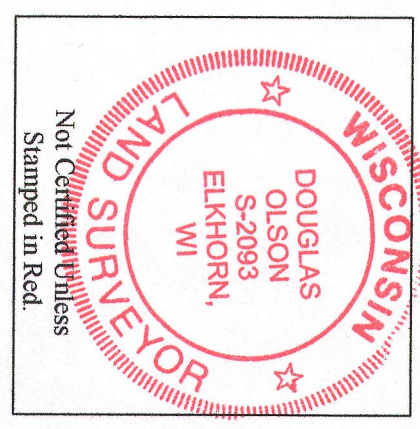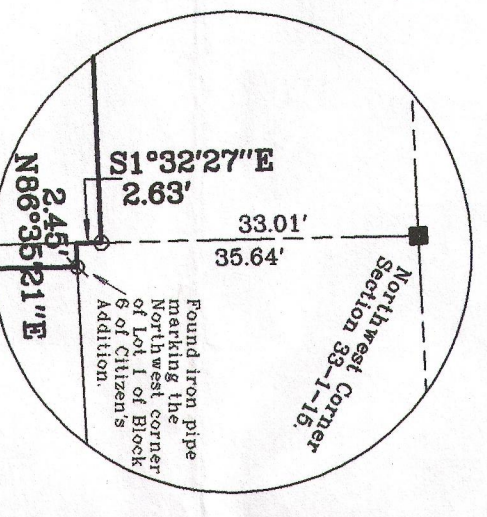

- Notes:
- 1) This survey plat is not certified unless signed and sealed in red ink.
 - 2) This Plat of Survey is the Wisconsin Lien Law, to file here. Lien waiver required.

Certified Survey Map No. 1407

C.S.M. 2419
Tax Parcel
UA241900003

Certified Survey Map No. 3638

Copyright 2013 by Jensen & Olson Land Surveying, LLC.
All rights reserved. No part of this survey plat may be reproduced or transmitted in
writing, or information storage and retrieval systems, without permission in writing
from Douglas G. Olson, Jensen & Olson Land Surveying, LLC.
I, Douglas G. Olson, Wisconsin Registered Land Surveyor, do hereby certify
that this survey was performed by me, or under my direction in full compliance with
Code "Minimum Standards for Property Surveys", and that this map is an accurate
representation thereof to the best of my knowledge and belief.

Douglas G. Olson
Wisconsin Registered Land Surveyor - 2095

Lot 8
Tax Parcel
UWNA 00021
OCT 7 2013

Lot 9
Tax Parcel
UWNA 00022

2013.012

Existing Building
2 Natural Way

Lot 1
C.S.M. 4490
Tax Parcel
UA449000001
12.354 Acres
538.150 Sq.Ft.

Certified Survey Map No. 215

Garage

Lot 4
Tax Parcel
UWNA 00029

Lot 5
Tax Parcel
UWNA 00025

2013.012

School Street
(66' Wide)

North line of the Northeast 1/4 of Section 35-1-15 as currently monumented.
S 88°51'31"E 246.53'
E 230°7'48.00"

North 1/4 Corner
Section 35-1-15
N 88°51'31"E 246.53'
E 230°7'48.00"

North 1/4 Corner
Section 35-1-15
N 88°51'31"E 246.53'
E 230°7'48.00"

Sheet 1 of 1 Sheets
Drawing Name: 11r15e-2013012-2013012Plat REV3.dwg

Job Reference Number
2013.012

2013.012


- Legend**
- Found County Section Corner
 - Found Iron Pipe
 - Found Iron Rod
 - Set Iron Rod 1/2" dia.
 - Recorded Information
 - Manhole
 - Utility Pole
 - Utility Pedestal or Transformer
 - Fire Hydrant
 - Water Valve
 - Asphalt Surface
 - Concrete Surface
 - Gravel Surface



Jensen & Olson Land Surveying, LLC

45 South Wisconsin Street * P.O. Box 322 * Elkhorn, Wisconsin. 53121
Telephone: (262) 723-3434 * Facsimile: (262) 723-8044
Email: jensen.olson@elknet.net

Scale in Feet
1" = 40'

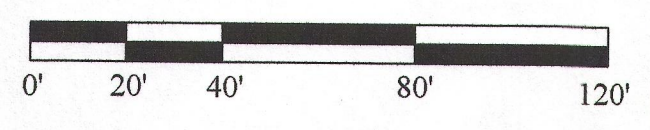

- Survey date: May 28, 2010.
Revisions:
- No. 1 - Sanitary Sewer Line and Easement
 - No. 2 - Relation to State Plane
 - No. 3 - Recorded C.S.M.