


HAROLD H. KOLB

REGISTERED PROFESSIONAL LAND SURVEYOR
LAKE GENEVA, WISCONSIN

SCHOOL STREET - 66' WIDE

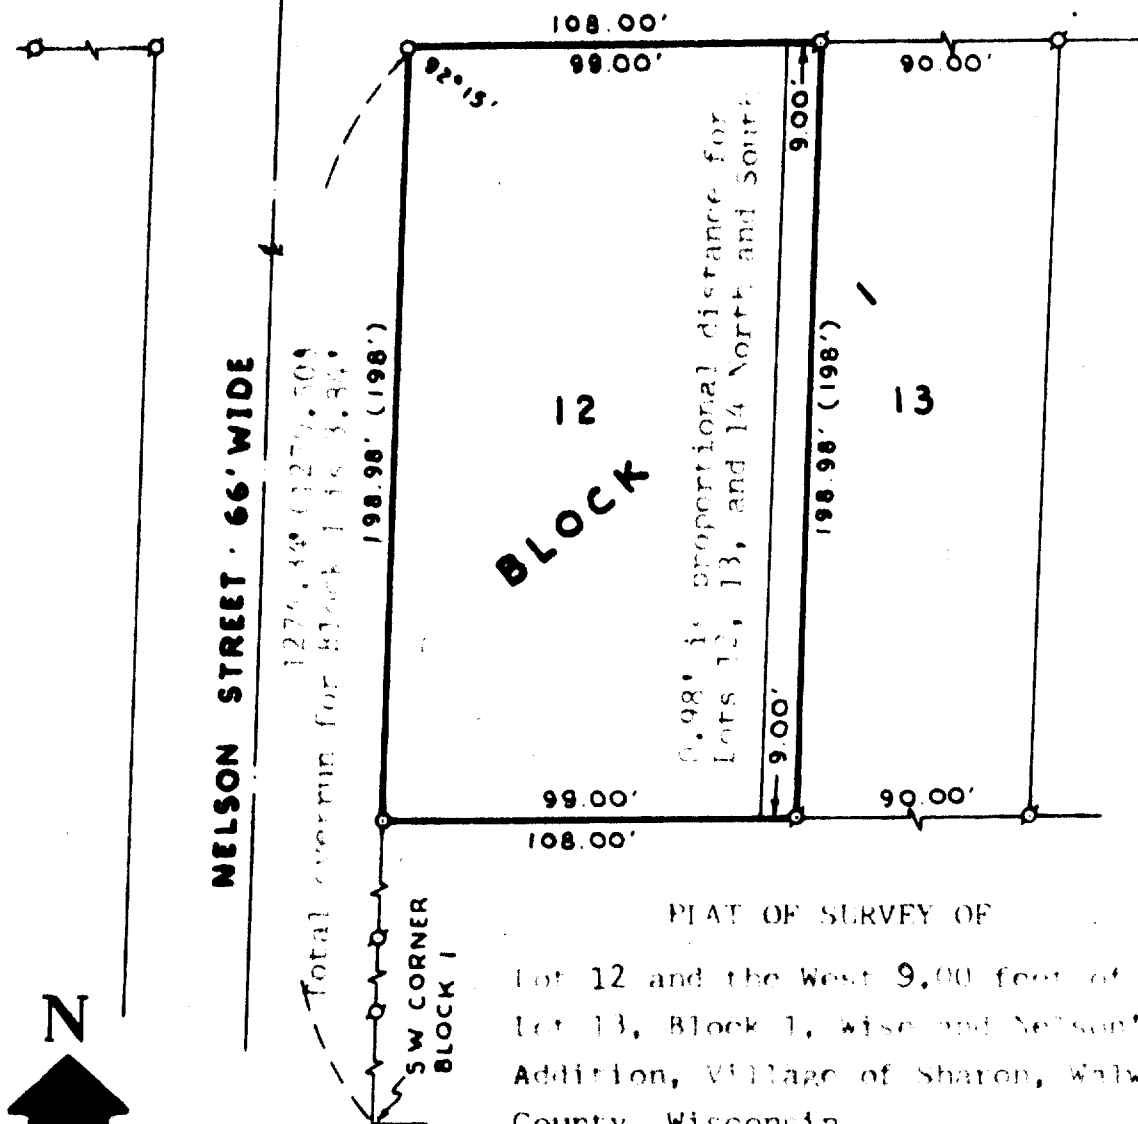


PLAT OF SURVEY OF

Lot 12 and the West 9.00 feet of
Lot 13, Block 1, Wise and Nelson's
Addition, Village of Sharon, Walworth
County, Wisconsin.

N
SCALE: 1"=50'

LEGEND

- ⬤ - IRON PIPE FOUND
- - IRON PIPE PLACED
- - CONCRETE MONUMENT
- x - SPIKE
- () - AS PLATTED

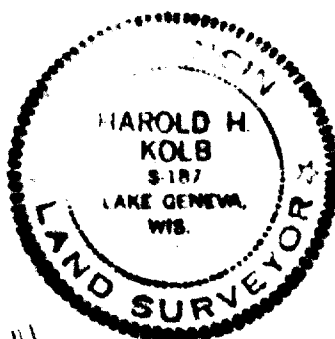

I, HAROLD H. KOLB, DO HEREBY CERTIFY THAT I HAVE
SURVEYED THE PROPERTY HEREON DESCRIBED ACCORDING
TO THE OFFICIAL RECORDS, AND THAT THE PLAT HEREON
IS A CORRECT REPRESENTATION OF THE LOT LINES.

Harold H. Kolb
HAROLD H. KOLB
WISCONSIN REGISTERED LAND SURVEYOR, S-187
DATE November 29, 1972

WVNA-14

8-51