

PLAT OF SURVEY

LOT 17 AND PART OF LOT 16, BLOCK 8 OF CITIZENS ADDITION, LOCATED IN PART OF THE SOUTHWEST QUARTER OF THE SOUTHEAST QUARTER OF SECTION 33, T.1N., R.15E., OF THE 4TH P.M., VILLAGE OF SHARON, WALWORTH COUNTY, WISCONSIN.


STATE OF WISCONSIN
COUNTY OF ROCK SS.

I HEREBY CERTIFY THAT I HAVE SUPERVISED THE SURVEY OF THE PROPERTY DESCRIBED ABOVE FOR THE EXCLUSIVE USE OF BARDEN AND SON CONCRETE AND THAT TO THE BEST OF MY KNOWLEDGE AND BELIEF THE PLAT HEREON DRAWN CORRECTLY REPRESENTS SAID SURVEY AND ITS LOCATION AND COMPLIES WITH CHAPTER A-E7.

GIVEN UNDER MY HAND AND SEAL THIS 29th DAY OF MAY, 2026, AT JANESVILLE, WISCONSIN.


RYAN M. COMBS P.L.S. NUMBER 2677

If the surveyor's signature is not red in color, the map is a copy and may contain unauthorized alterations. The certification contained hereon shall not apply to any copies.

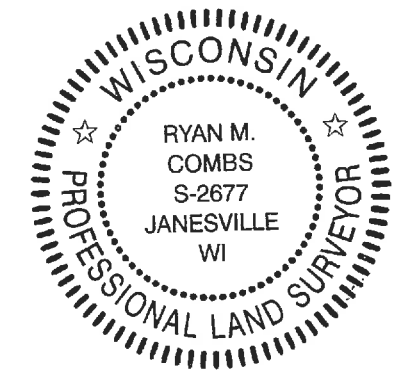

LEGEND

- FOUND 3/4" IRON PIN
- ⊙ FOUND 1" IRON PIPE
- (XXX) RECORD DATA

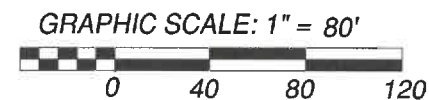


NOTES:
FIELDWORK COMPLETED MAY 28, 2026.

THIS SURVEY IS SUBJECT TO ANY AND ALL EASEMENTS AND AGREEMENTS, RECORDED AND UNRECORDED.

BEARINGS BASED ON THE WISCONSIN COORDINATE REFERENCE SYSTEM, WALWORTH COUNTY.

DISTANCE UNITS BASED ON THE US SURVEY FOOT.

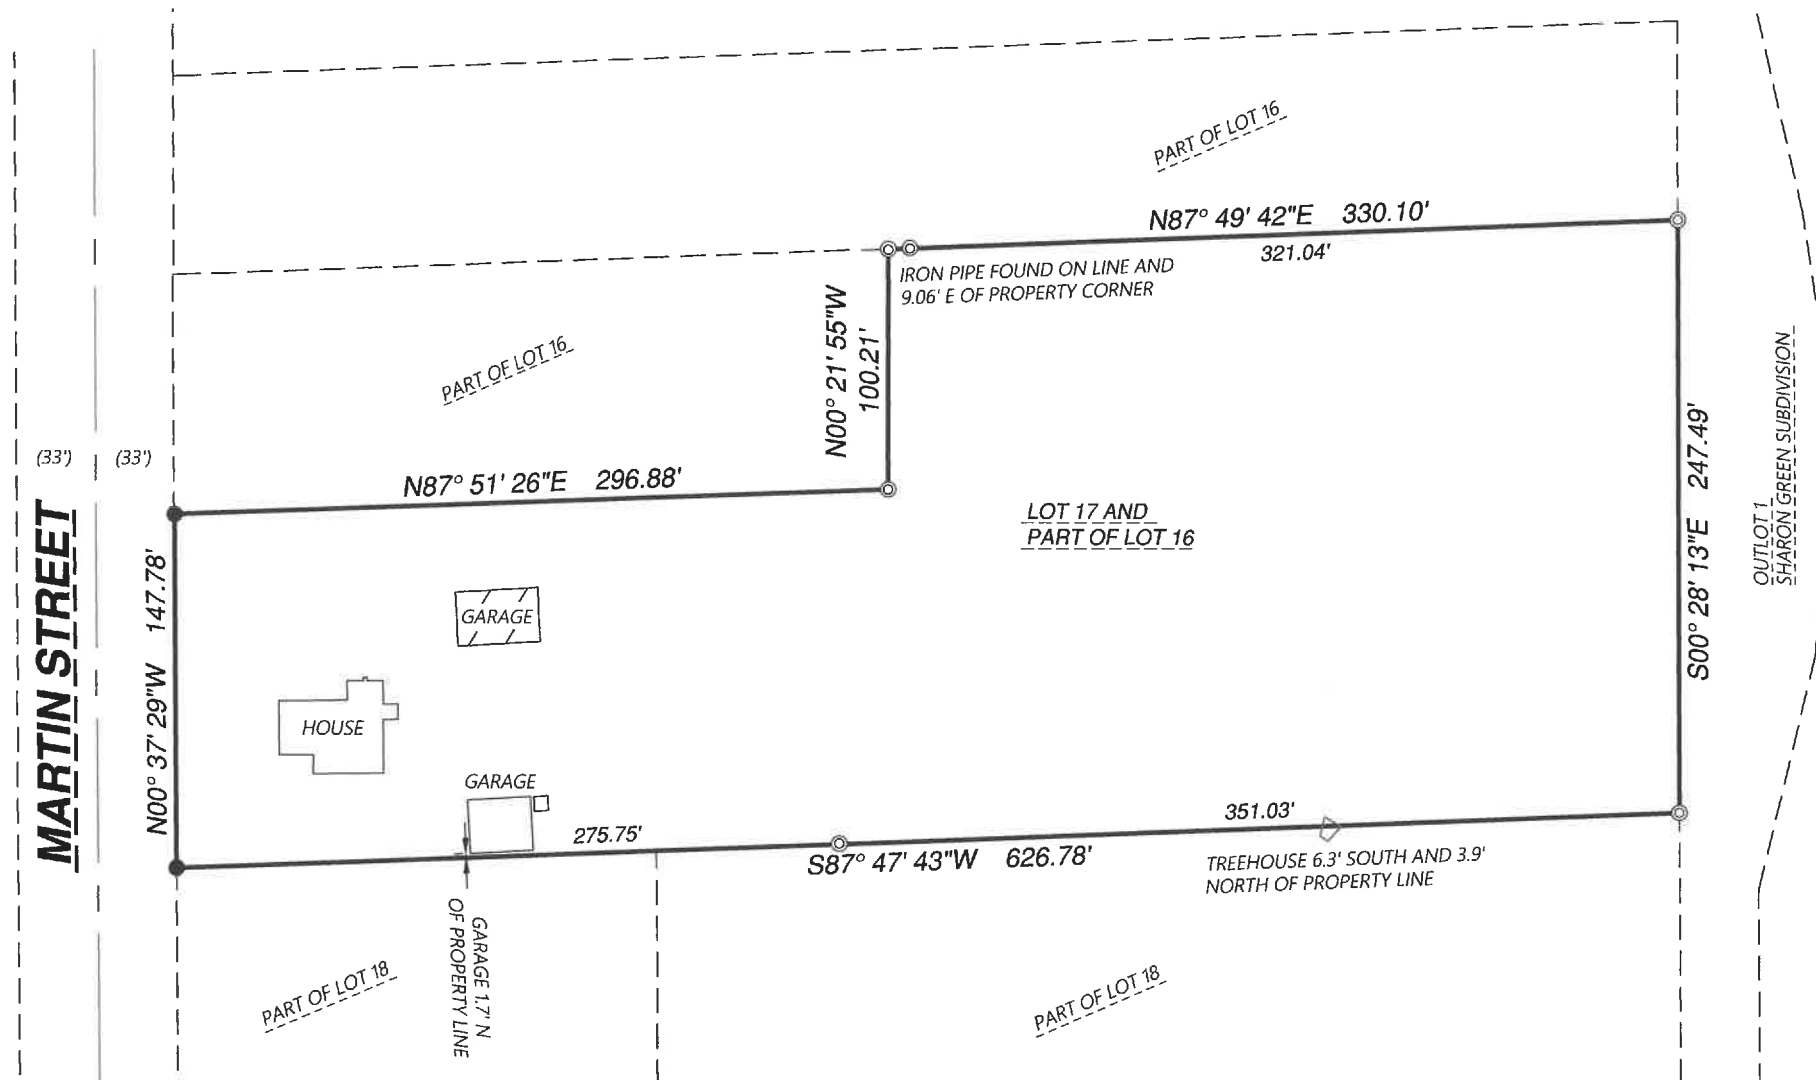

Project No. 126-206
For: BARDEN AND SON CONCRETE, LLC



- LAND SURVEYING
- LAND PLANNING
- CIVIL ENGINEERING

109 W. MILWAUKEE ST
JANESVILLE, WI 53548
www.combssurvey.com

tel: 608-752-0575
fax: 608-752-0534