


GEORGE T. DUNHAM
SURVEYING & SUBDIVIDING
DELAVER, WISCONSIN

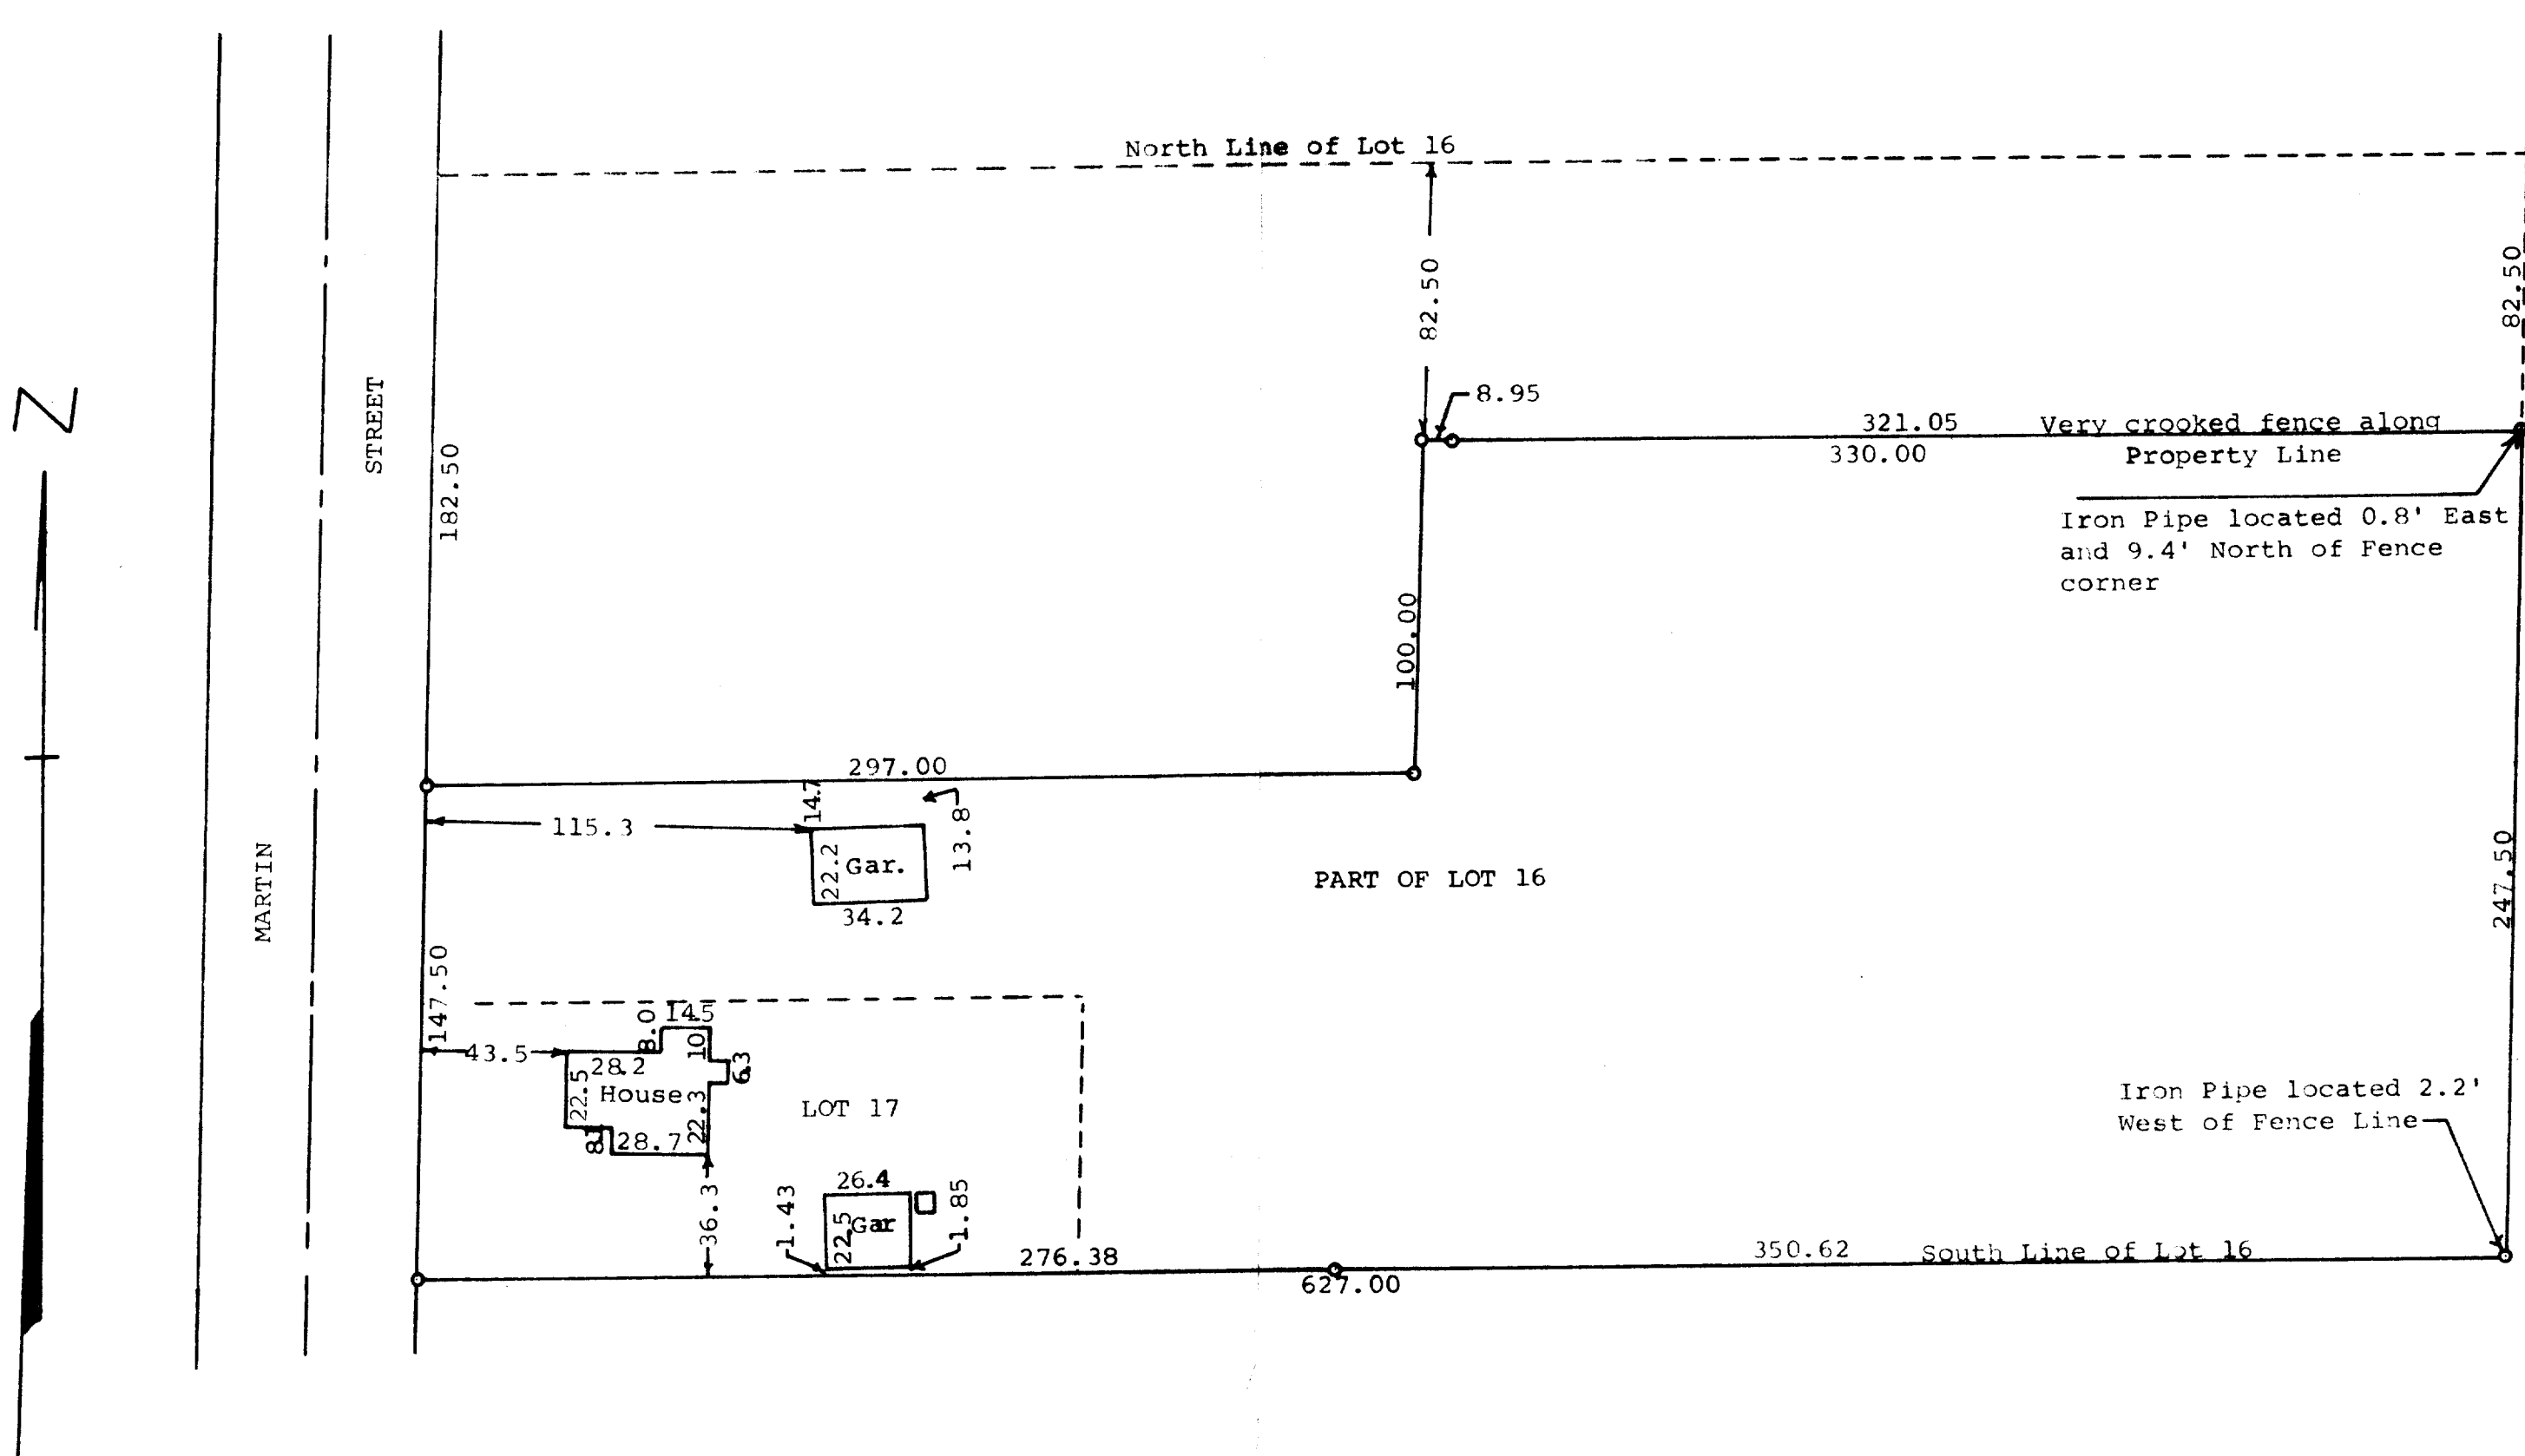

Scale - 1" = 50'
o = Iron Pipe

STATE OF WISCONSIN)
COUNTY OF WALWORTH) ss

I, George T. Dunham, Surveyor, certify that I have surveyed the property described as follows,

All of Lot 17 and part of Lot 16 in Block 8 of Citizens Addition, Village of Sharon, Walworth County, Wisconsin, described as follows, to-wit: Beginning on the west line of said Lot 16 at a point located 182.50 feet south of the northwest corner of said Lot 16; thence East parallel with the north line of said Lot 16, 297.00 feet; thence North parallel with the west line of said Lot 16, 100.00 feet; thence East parallel with the north line of said Lot 16, 330.00 feet to a point on the east line of said lot located 82.50 feet south of the northeast corner of said Lot 16; thence South along the east line of said Lot 16, 247.50 feet to the southeast corner of said Lot 16; thence west along the south line of said Lots 16 and 17, 627.00 feet to the southwest corner of said Lot 17; thence North along the west line of said Lots 16 and 17, 147.50 feet to the place of beginning,

and that the plat shown above is an accurate survey and a true representation thereof and correctly shows the exterior boundary lines and location of the buildings on said property and the correct measurements thereof.

March 13, 1973

George T. Dunham
George T. Dunham, Surveyor

