
  
 SCALE 1"=20'  
 0-IRON PIPE

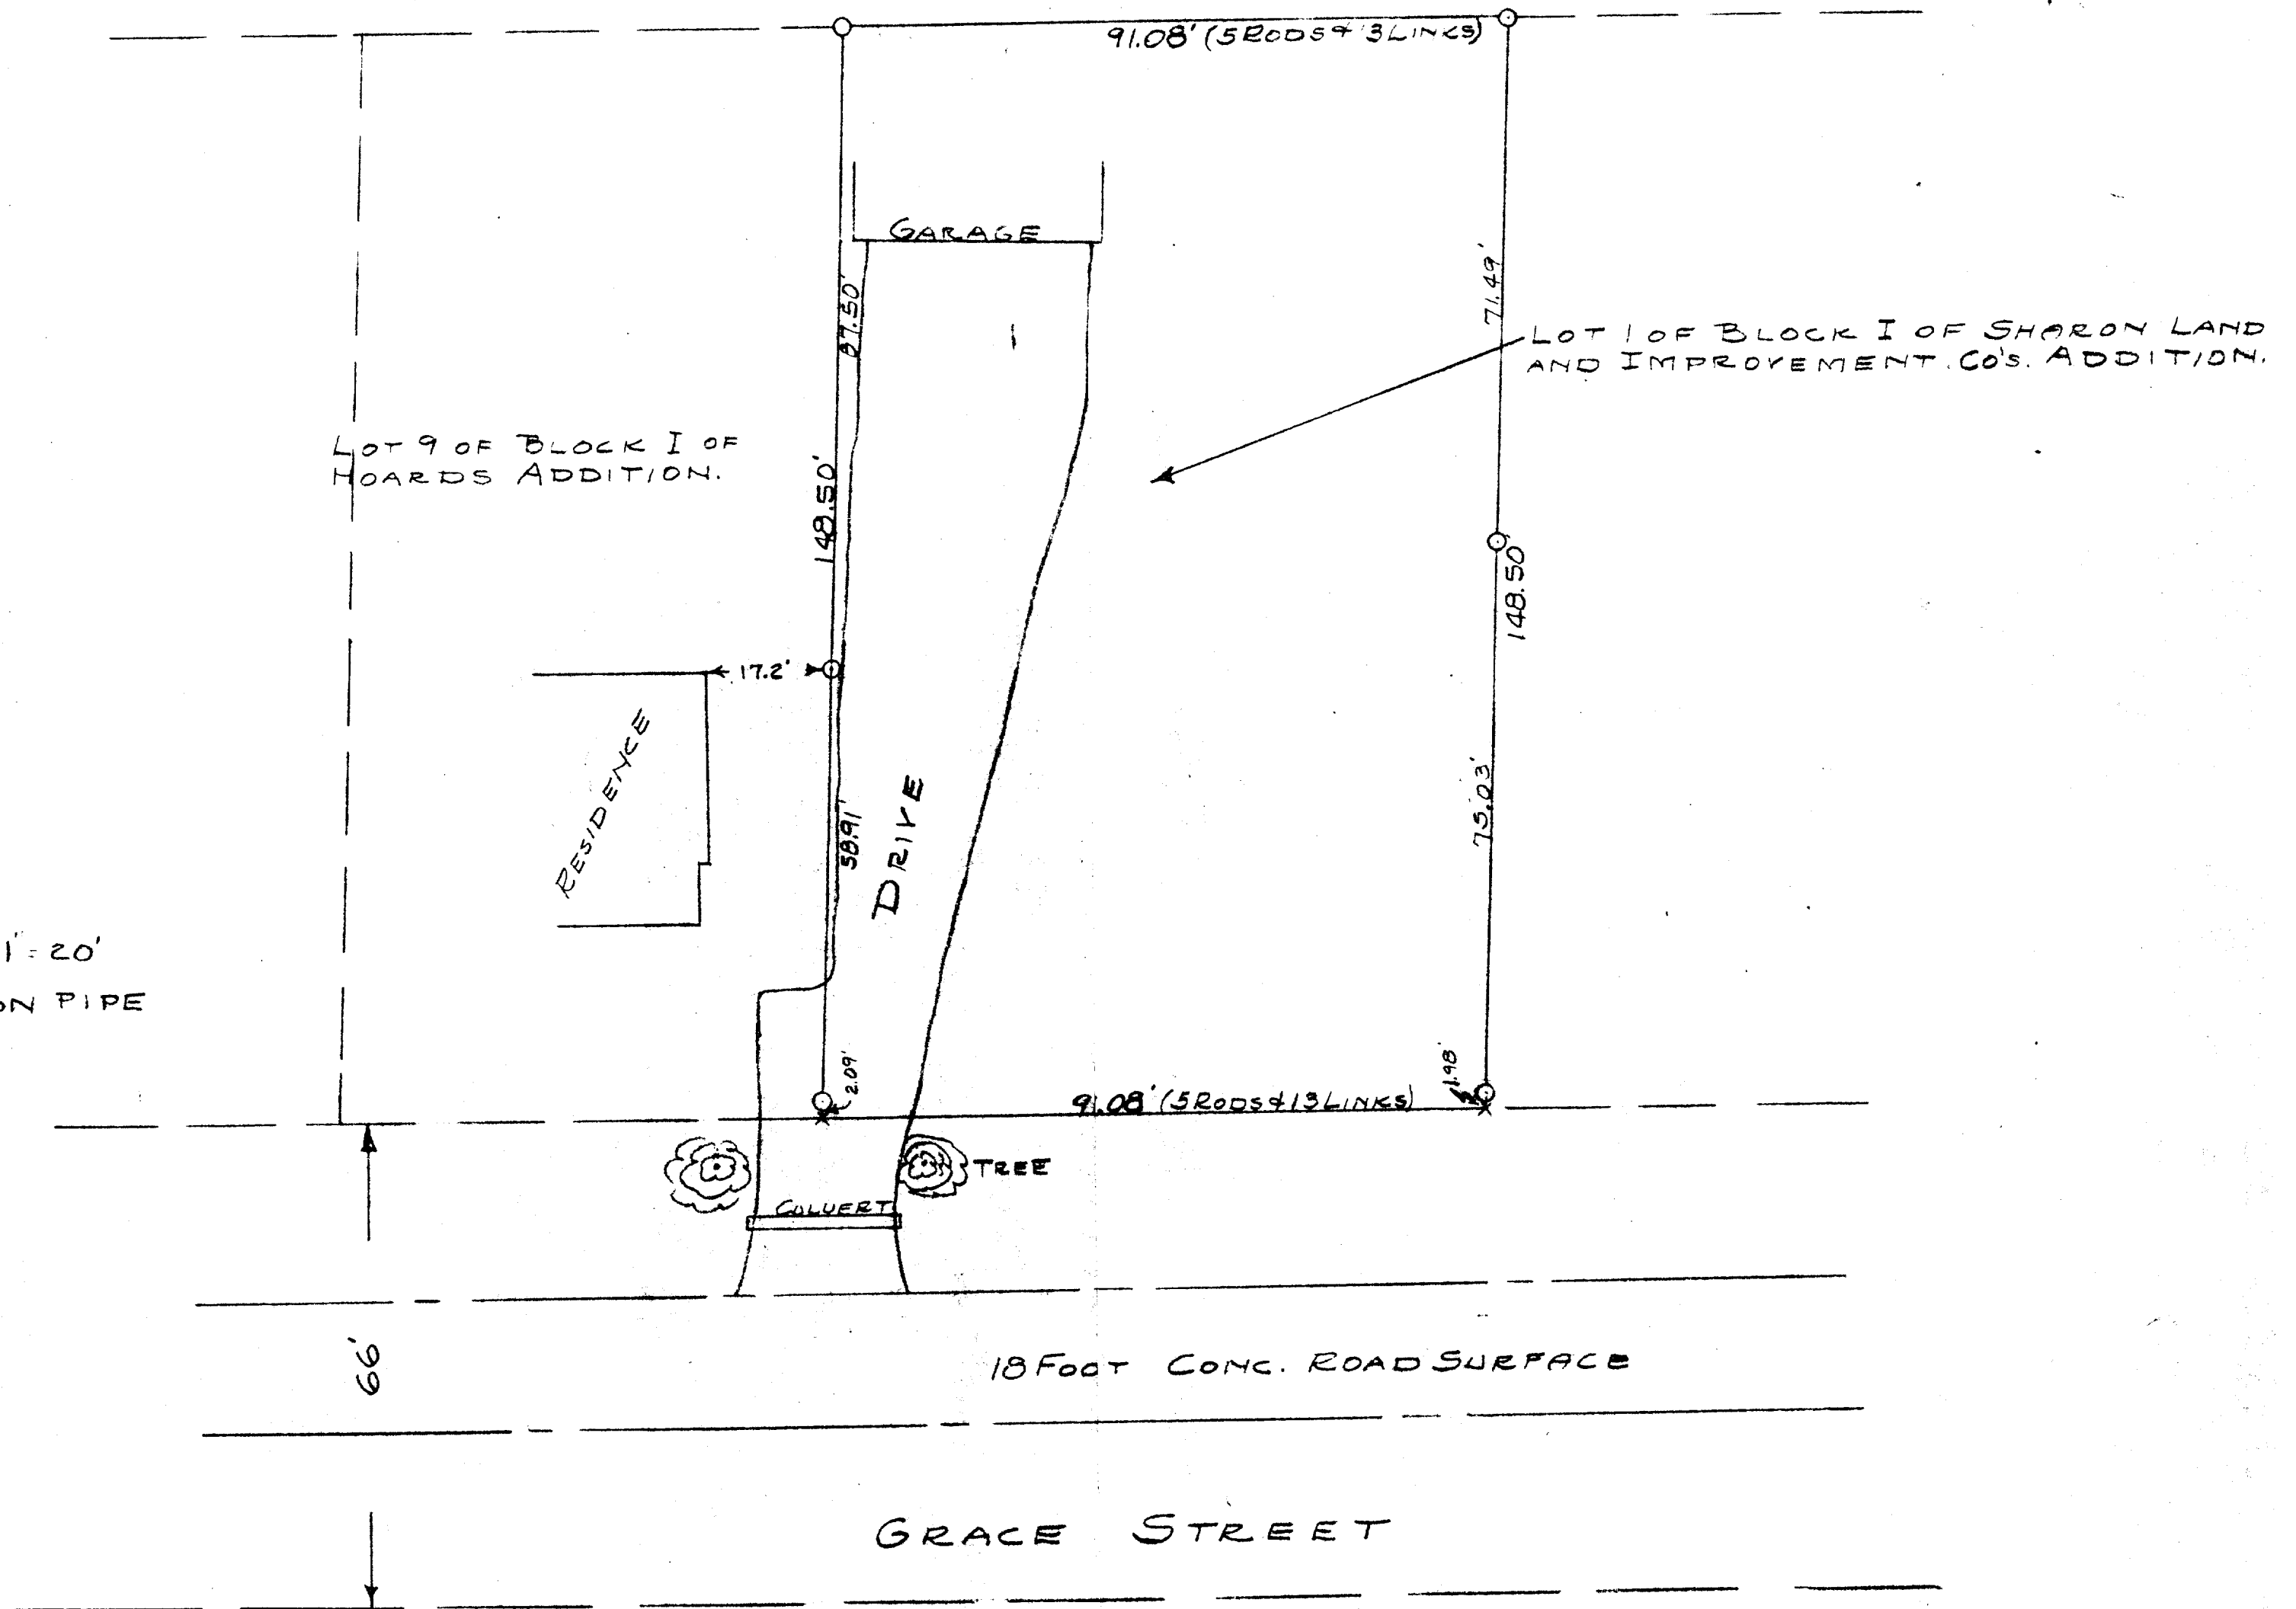

PLAT OF SURVEY OF LOT 1 OF BLOCK I OF  
 SHARON LAND AND IMPROVEMENT COM-  
 PANY'S ADDITION TO THE VILLAGE OF  
 SHARON, WALWORTH COUNTY, WISCONSIN.

JULY 1952

Lloyd L. Jensen  
 WALWORTH COUNTY SURVEYOR

USLI-1

8-5