


HAROLD H. KOLB
 REGISTERED PROFESSIONAL LAND SURV.
 TWIST BUILDING
 LAKE GENEVA, WIS. 53147

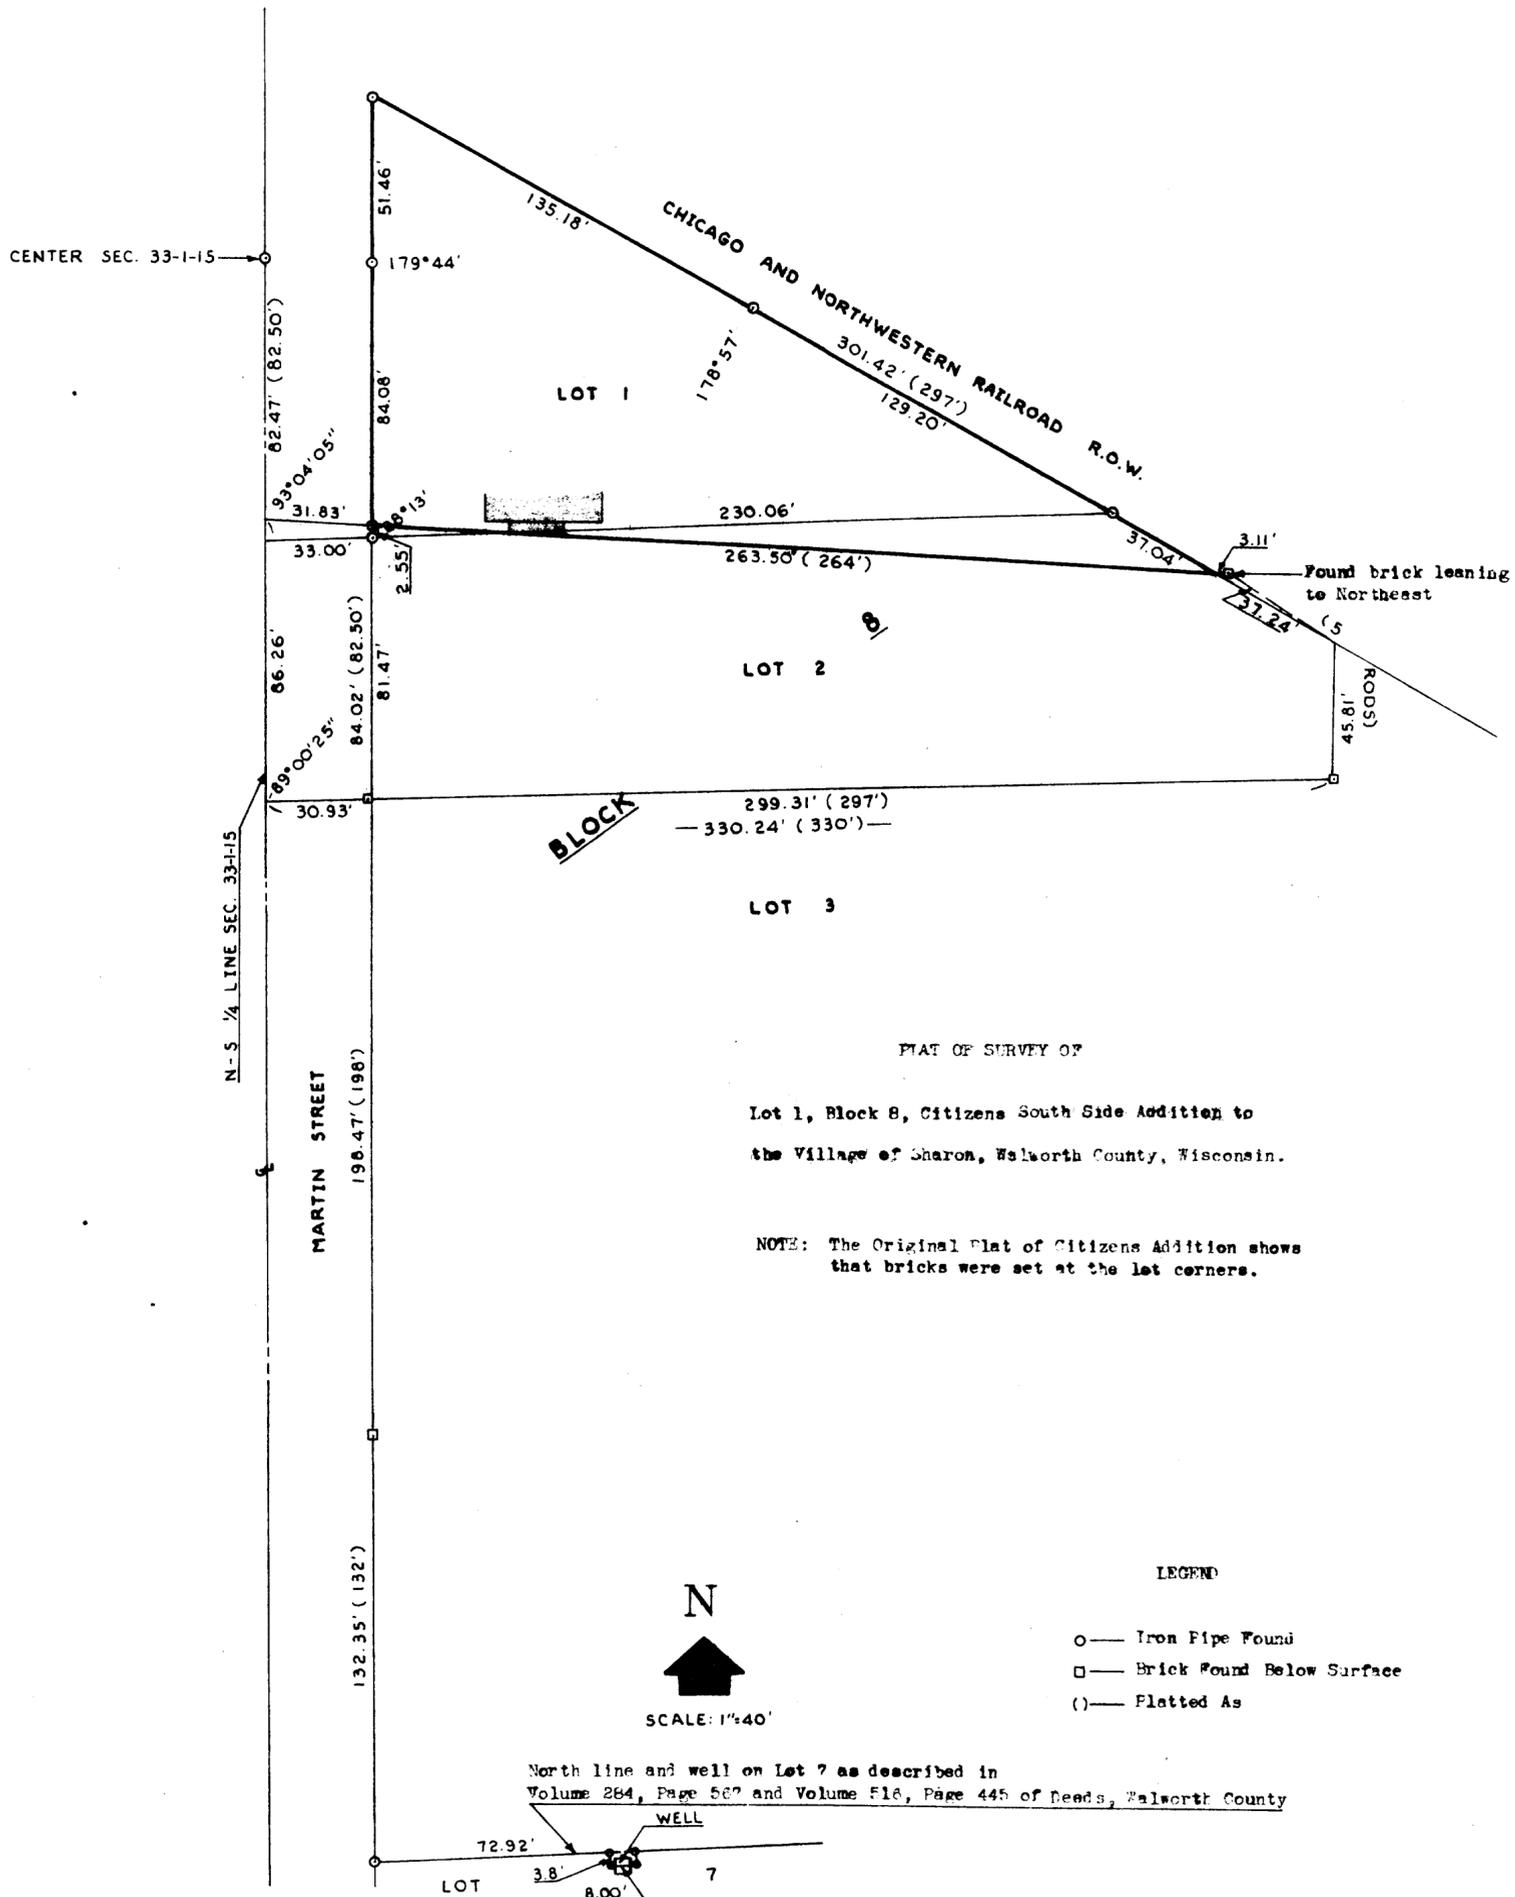

PLAT OF SURVEY OF
 Lot 1, Block 8, Citizens South Side Addition to
 the Village of Sharon, Walworth County, Wisconsin.


NOTE: The Original Plat of Citizens Addition shows
 that bricks were set at the lot corners.

LEGEND

- — Iron Pipe Found
- — Brick Found Below Surface
- () — Platted As



North line and well on Lot 7 as described in
 Volume 284, Page 567 and Volume 516, Page 445 of Deeds, Walworth County

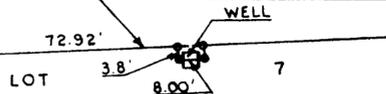

Harold H. Kolb
 Harold H. Kolb
 Wisconsin Registered Land Surveyor, 5-187
 Date May 31, 1974

107-111

8-65