


HAROLD H. KOLB
REGISTERED PROFESSIONAL LAND SURVEYOR
TWIN BUILDING
LAKE GENEVA, WIS. 53147

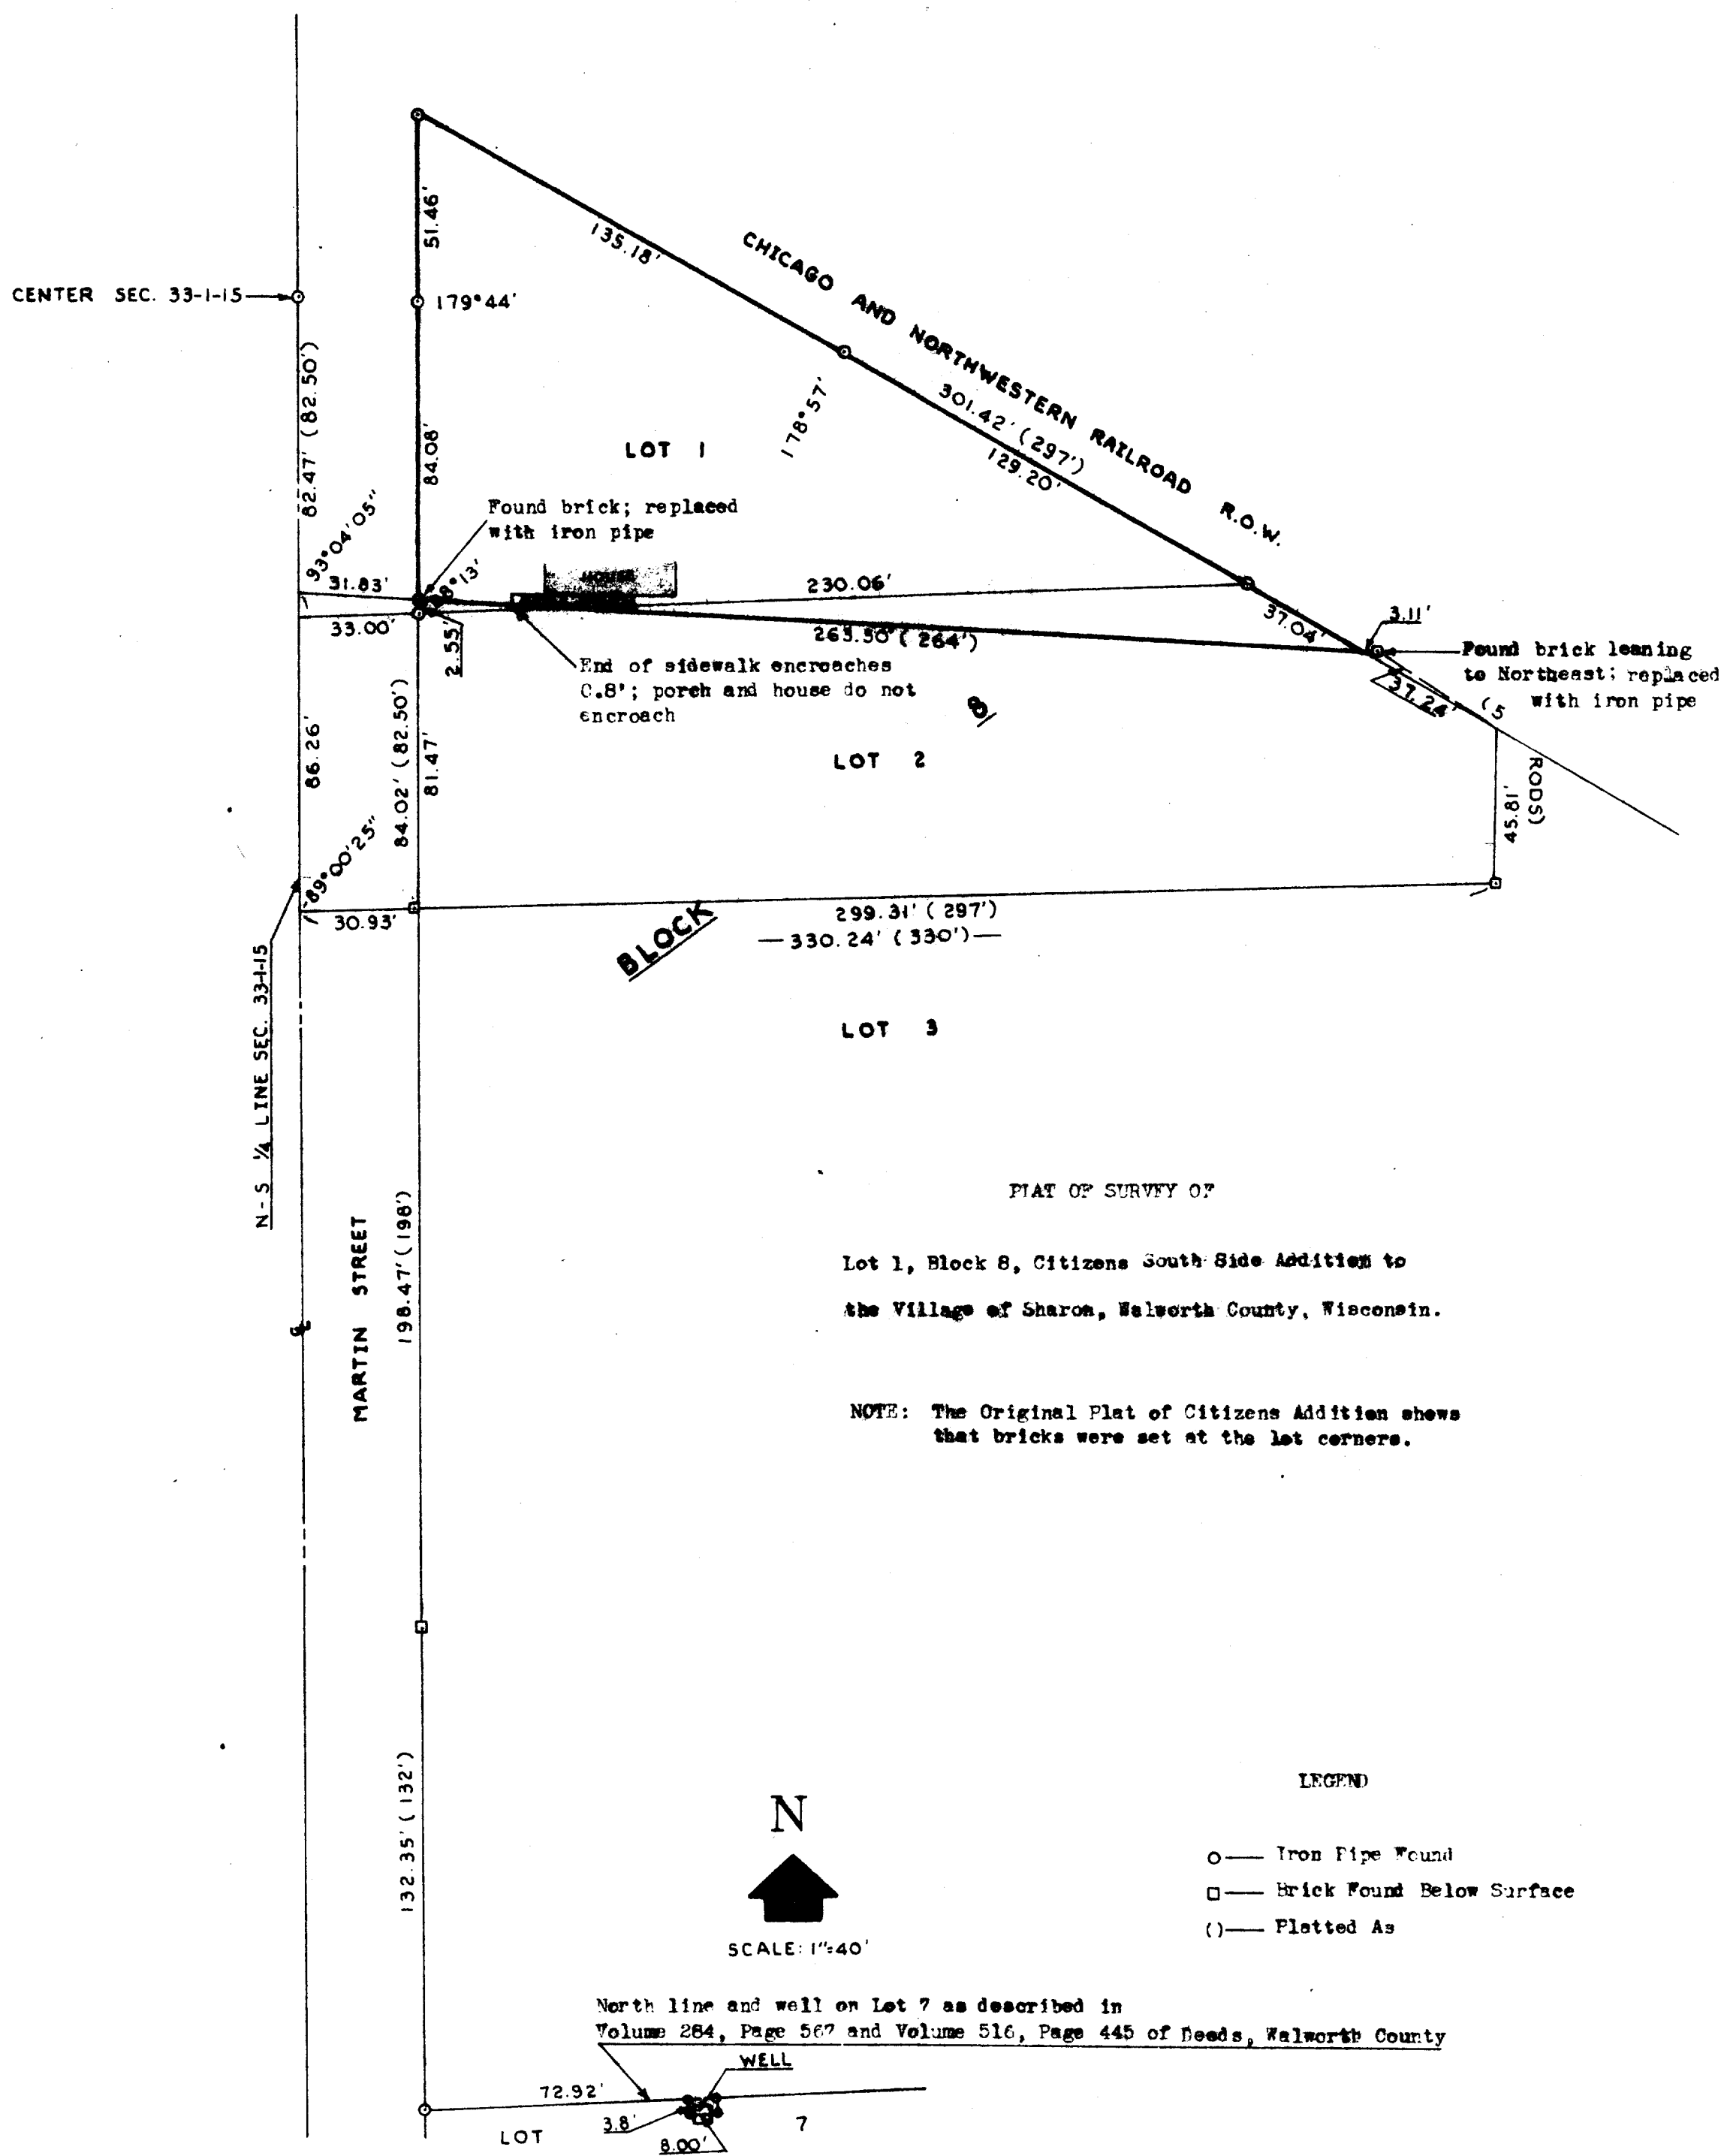

Harold H. Kolb
Harold H. Kolb
Wisconsin Registered Land Surveyor, S-187
Date *May 31, 1974*
Revised: June 13, 1974