



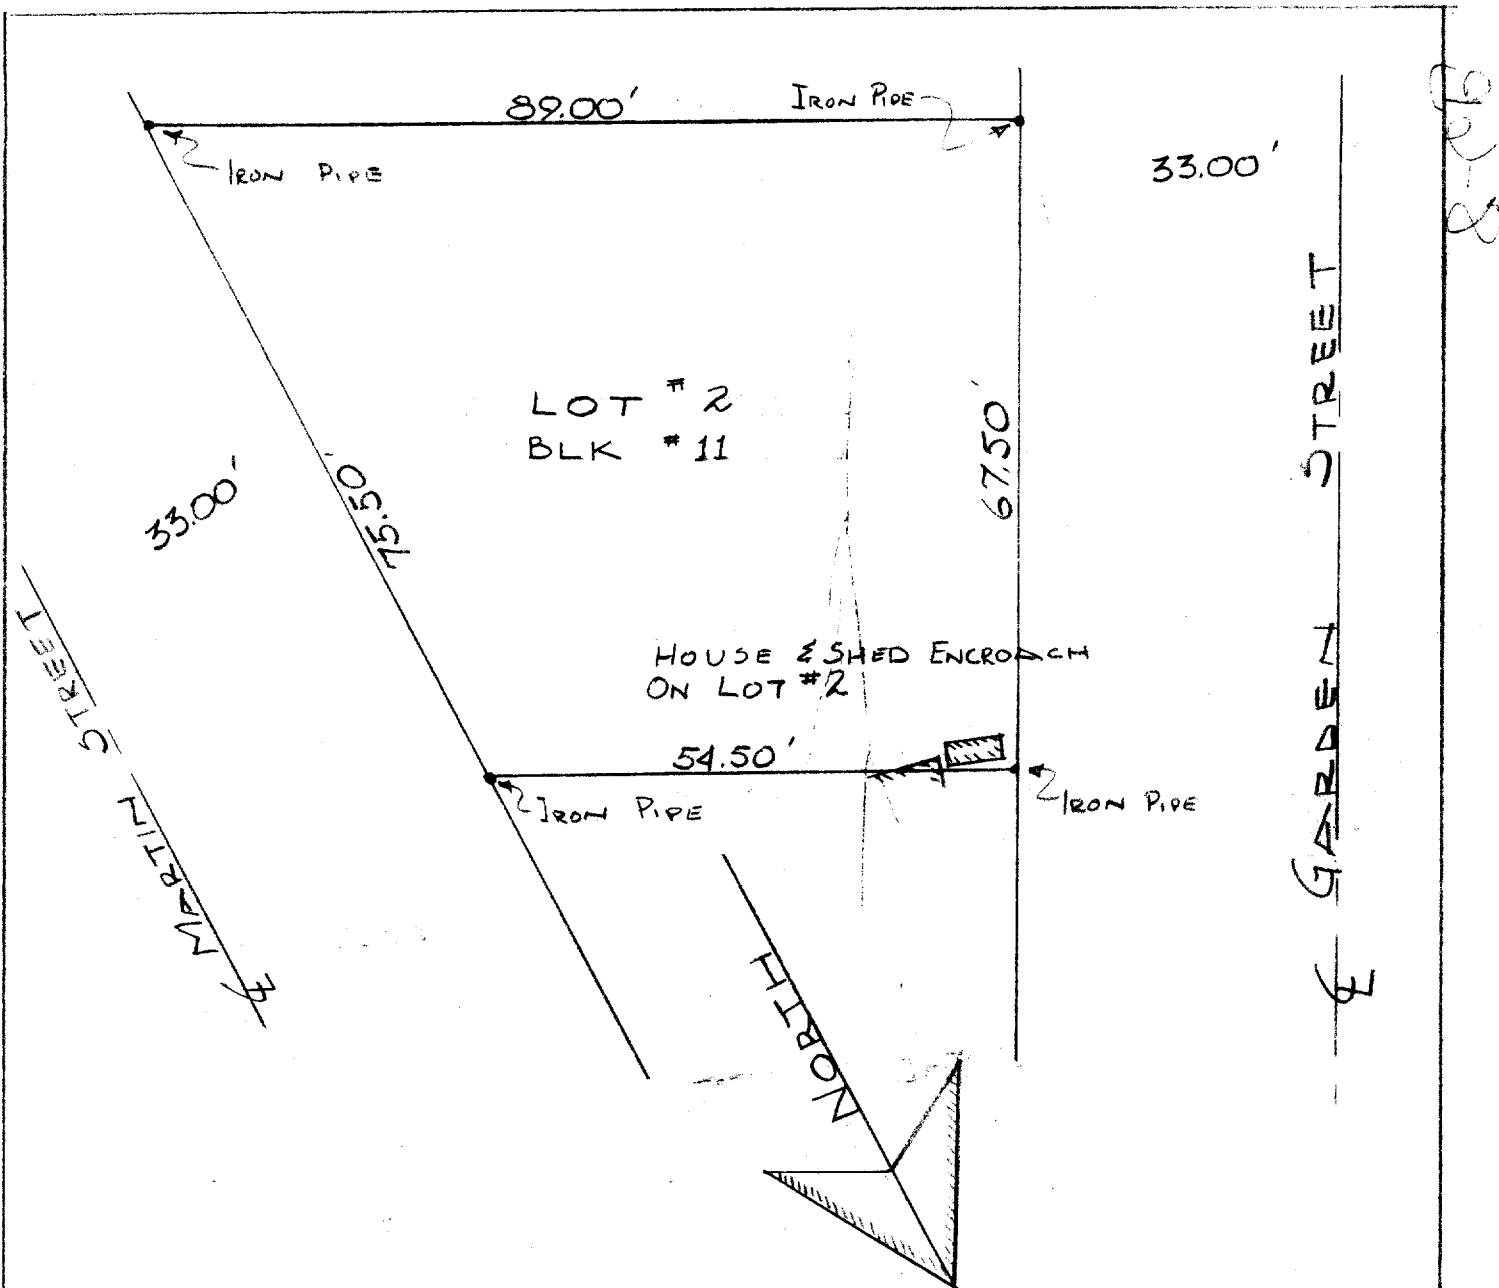

DESCRIPTION: Lot #2 of Block #11 of the Original Plat of the Village of Sharon, Walworth County, Wisconsin.

Plat of survey by James F. Biagi

May 27, 1960.

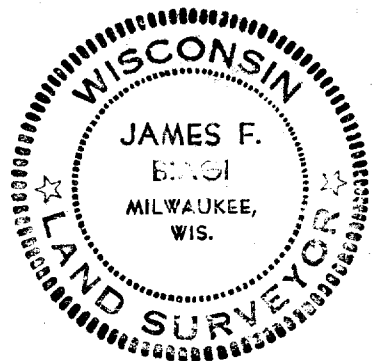

James F. Biagi
James F. Biagi RLS 272